


SECTION

TOWNSHIP 245, RANGE 12W, W. M.

North

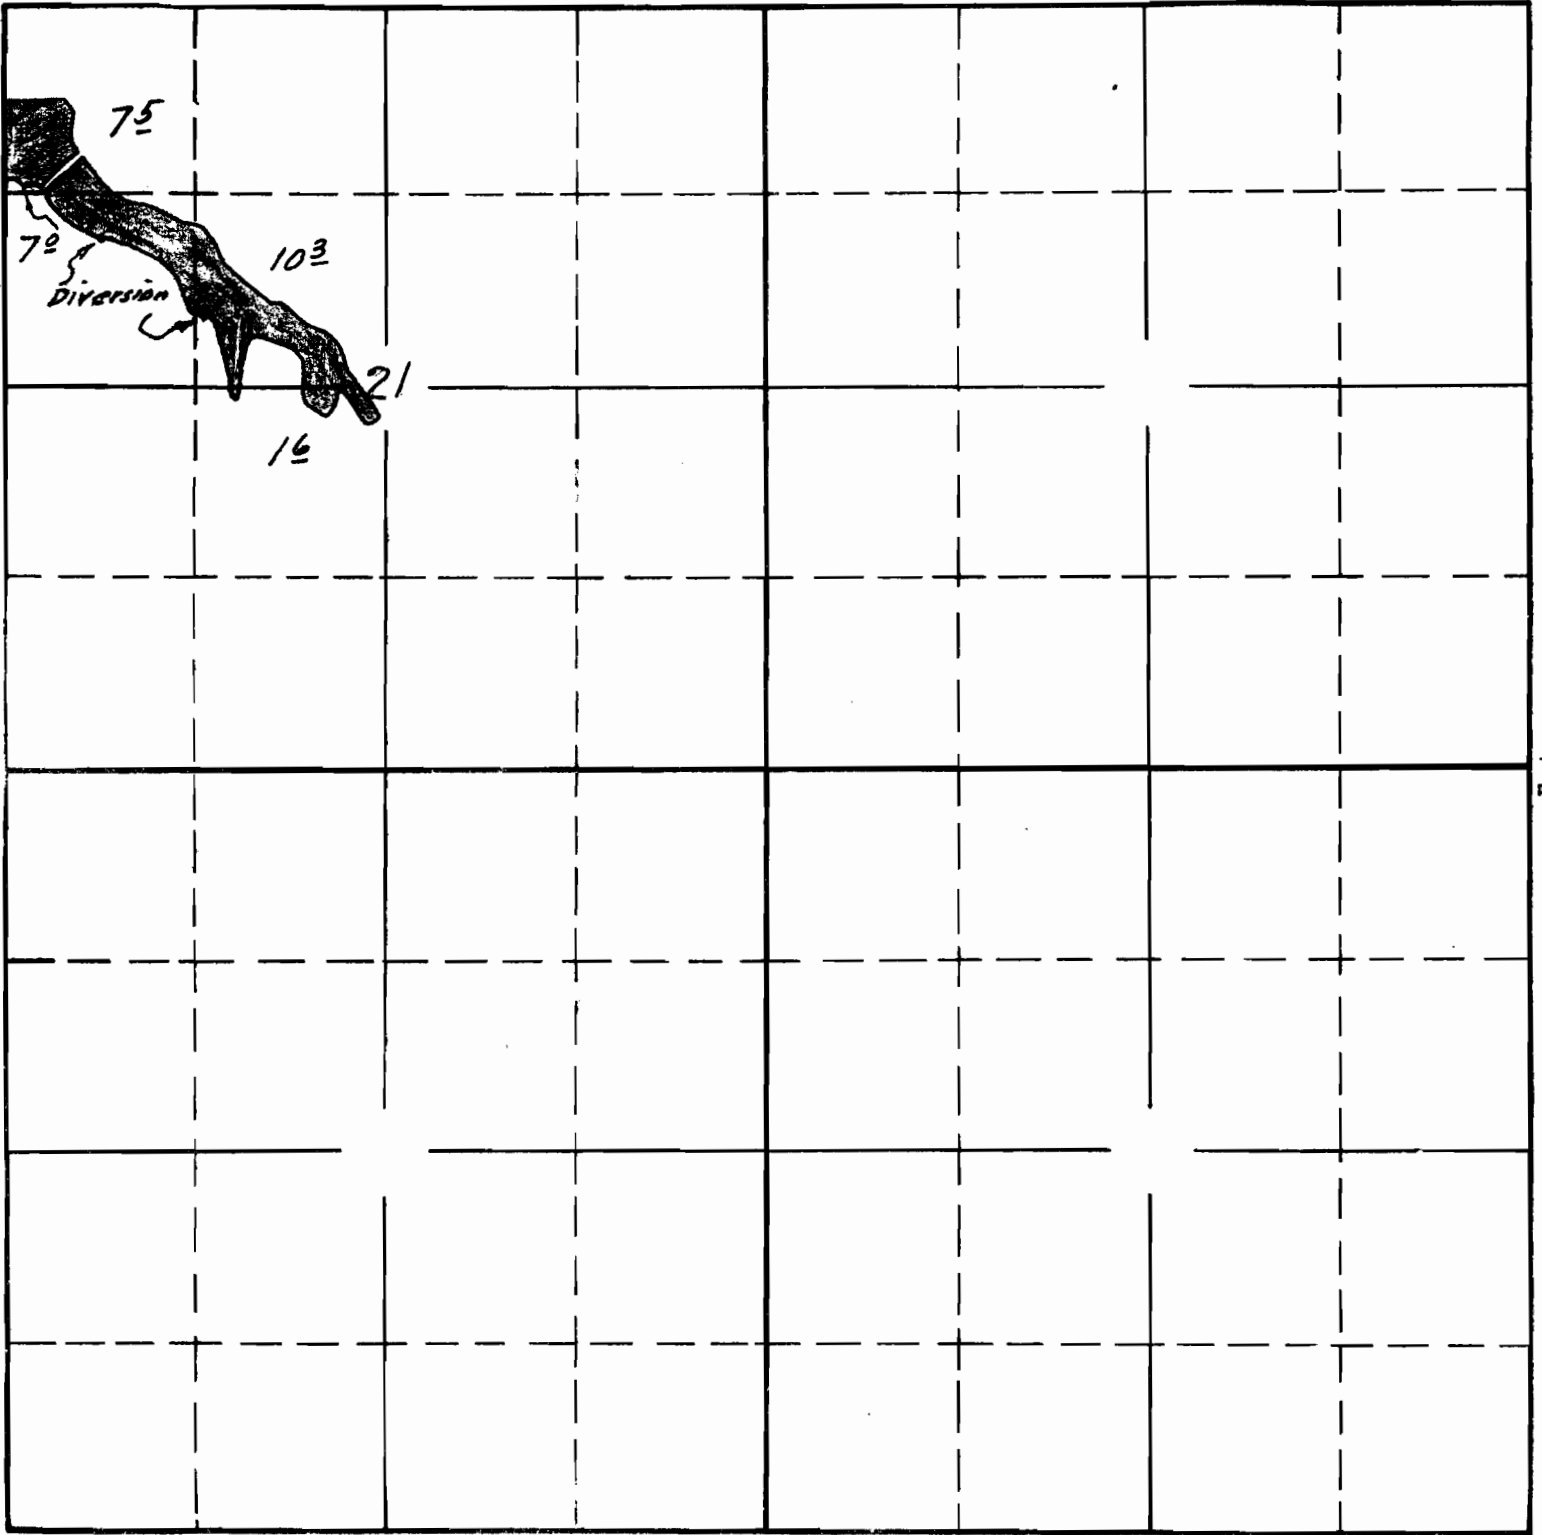

West

East


Surveyed July 2, 1940 C.A.C.

South

APPLICATION No. 17564
16948

PERMIT No. 12694

13265

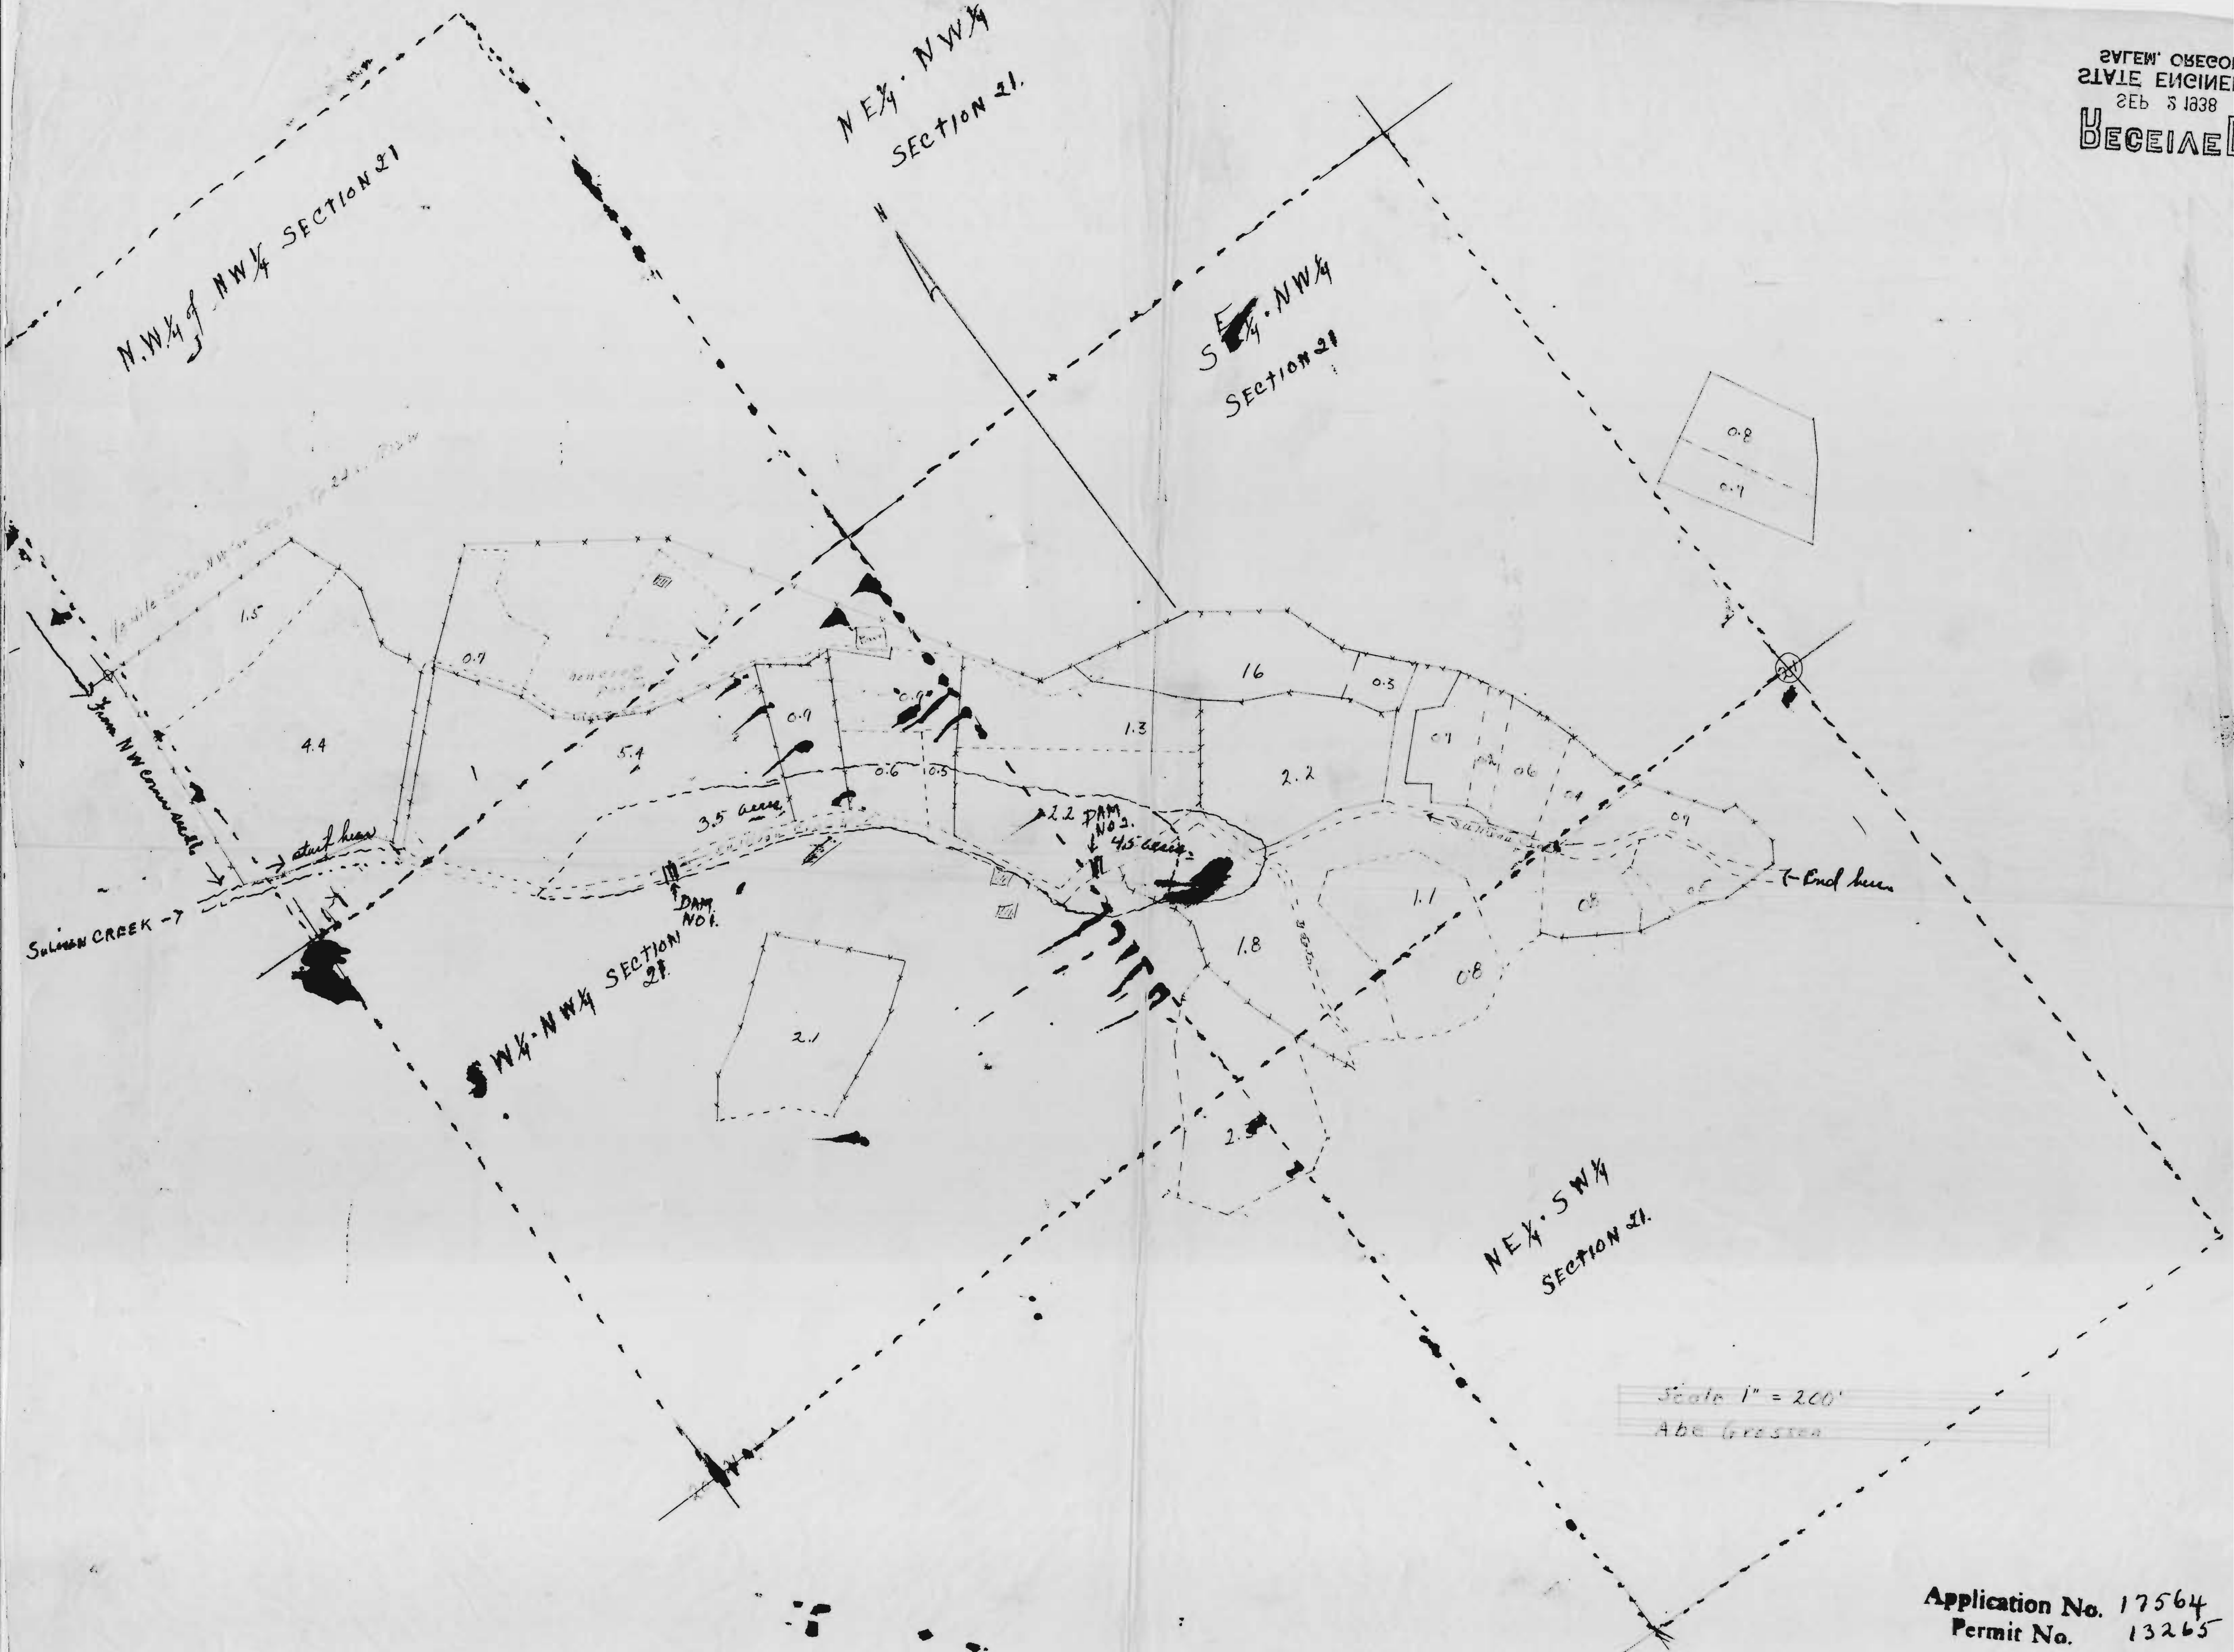

N.W. 1/4 of N.W. 1/4 SECTION 21

N.E. 1/4 - N.W. 1/4
SECTION 21

S.E. 1/4 - N.W. 1/4
SECTION 21

SECTION 21

N.E. 1/4 - S.W. 1/4
SECTION 21

SALMON CREEK ->

start here

End here

2.2 DAM NO. 2

3.5 acres

Scale 1" = 200'
Abe Grosvenor

Application No. 17564
Permit No. 13265

17564 EG
17-10 00