


2

T. 33 S., R. 2 E., W.M.

Scale: 8 inches = 1 mile

SE $\frac{1}{4}$

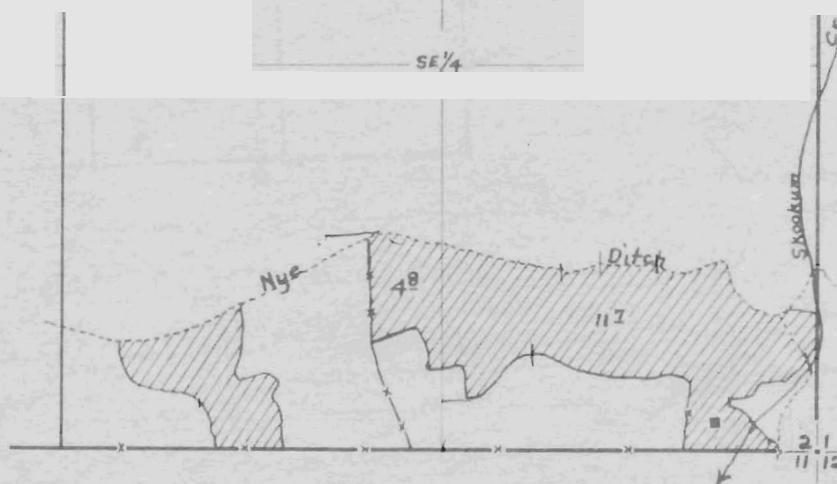

FIN.

ROO-

RVEY

UNDE

17569 Permit No. 13269
IN NAME OF

R. Bruce Grieve

Surveyed Nov 20 1956, by D.C. Hendrix, WM.

Tracing No. 2 of 2

P.13269

N $\frac{1}{4}$ Cor. Sec. 16

T. 32 S., R. 3 E., W.M.

MAP NUMBER

APP. NO. 17569

PER. NO. 13269

PRIORITY DATE 9/7/38

STREAM Mill ^{Misc} Scale:

8 inches = 1 mile

Map showing correct point
of diversion of Nye Ditch
from Mill Creek.

46° E. Diversion

CERT. 27740



Section 1

T. 33 S., R. 3 E., W.M.

Scale: 8" = 1 mile



FINAL PROOF SURVEY

UNDER

pplication No. 17569 Permit No. 13269

IN NAME OF

R. Bruce Grieve

Surveyed 4-26-56 5-24-56 6-8-56 1956, by D. C. Hendrix

Tracing No. 1 of 2