


SECTION

30

TOWNSHIP 2 S., RANGE 1 W., W. M.

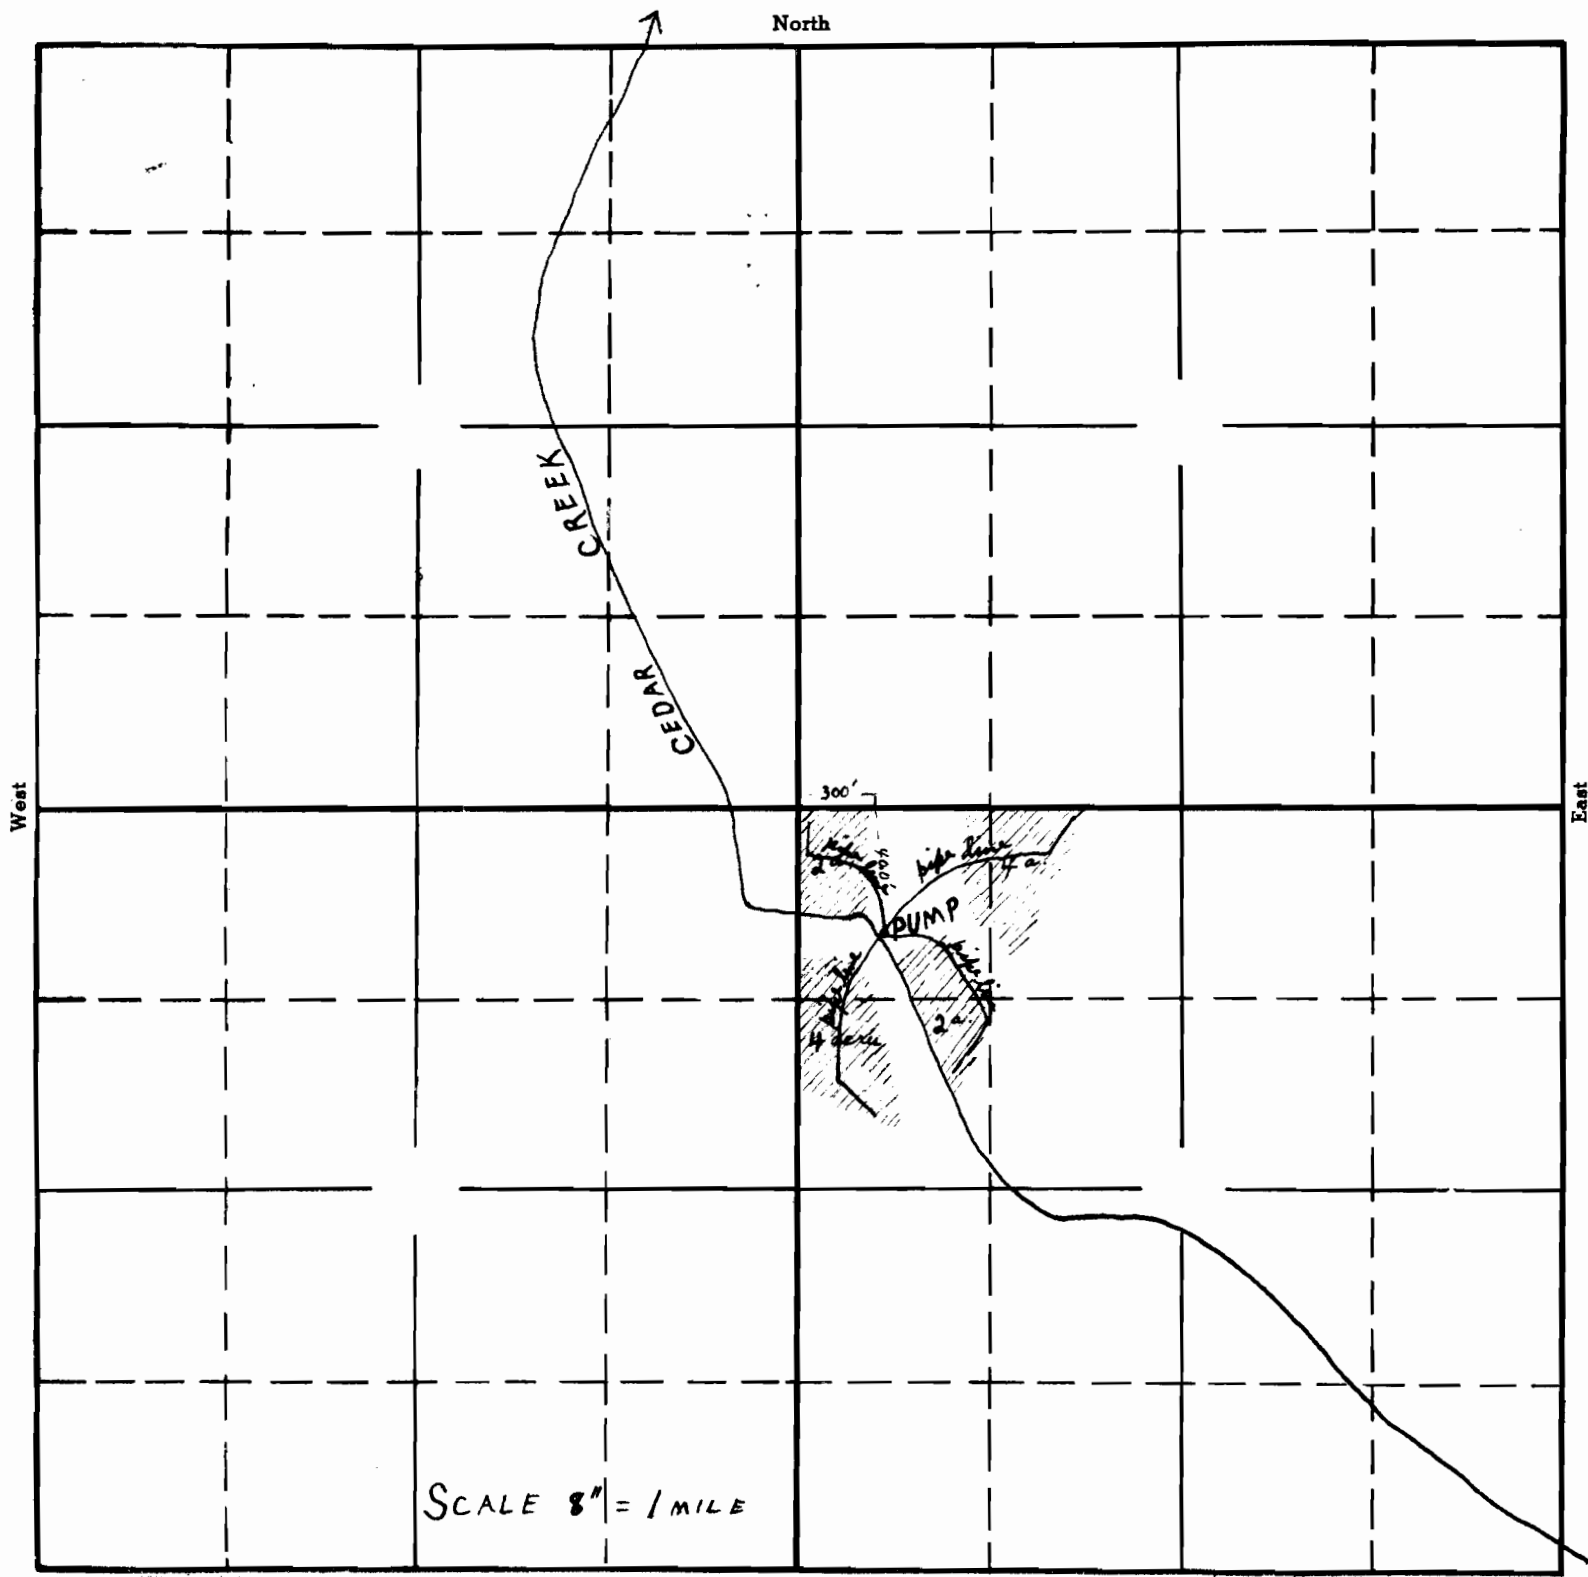

SCALE 8" = 1 MILE

South

RECEIVED

SEP 14 1938


STATE ENGINEER
SALEM, OREGON

17585
2-6-38
APPLICATION No. 17585
PERMIT No. 13282

SECTION

TOWNSHIP 25 , RANGE 11W , W. M.

North

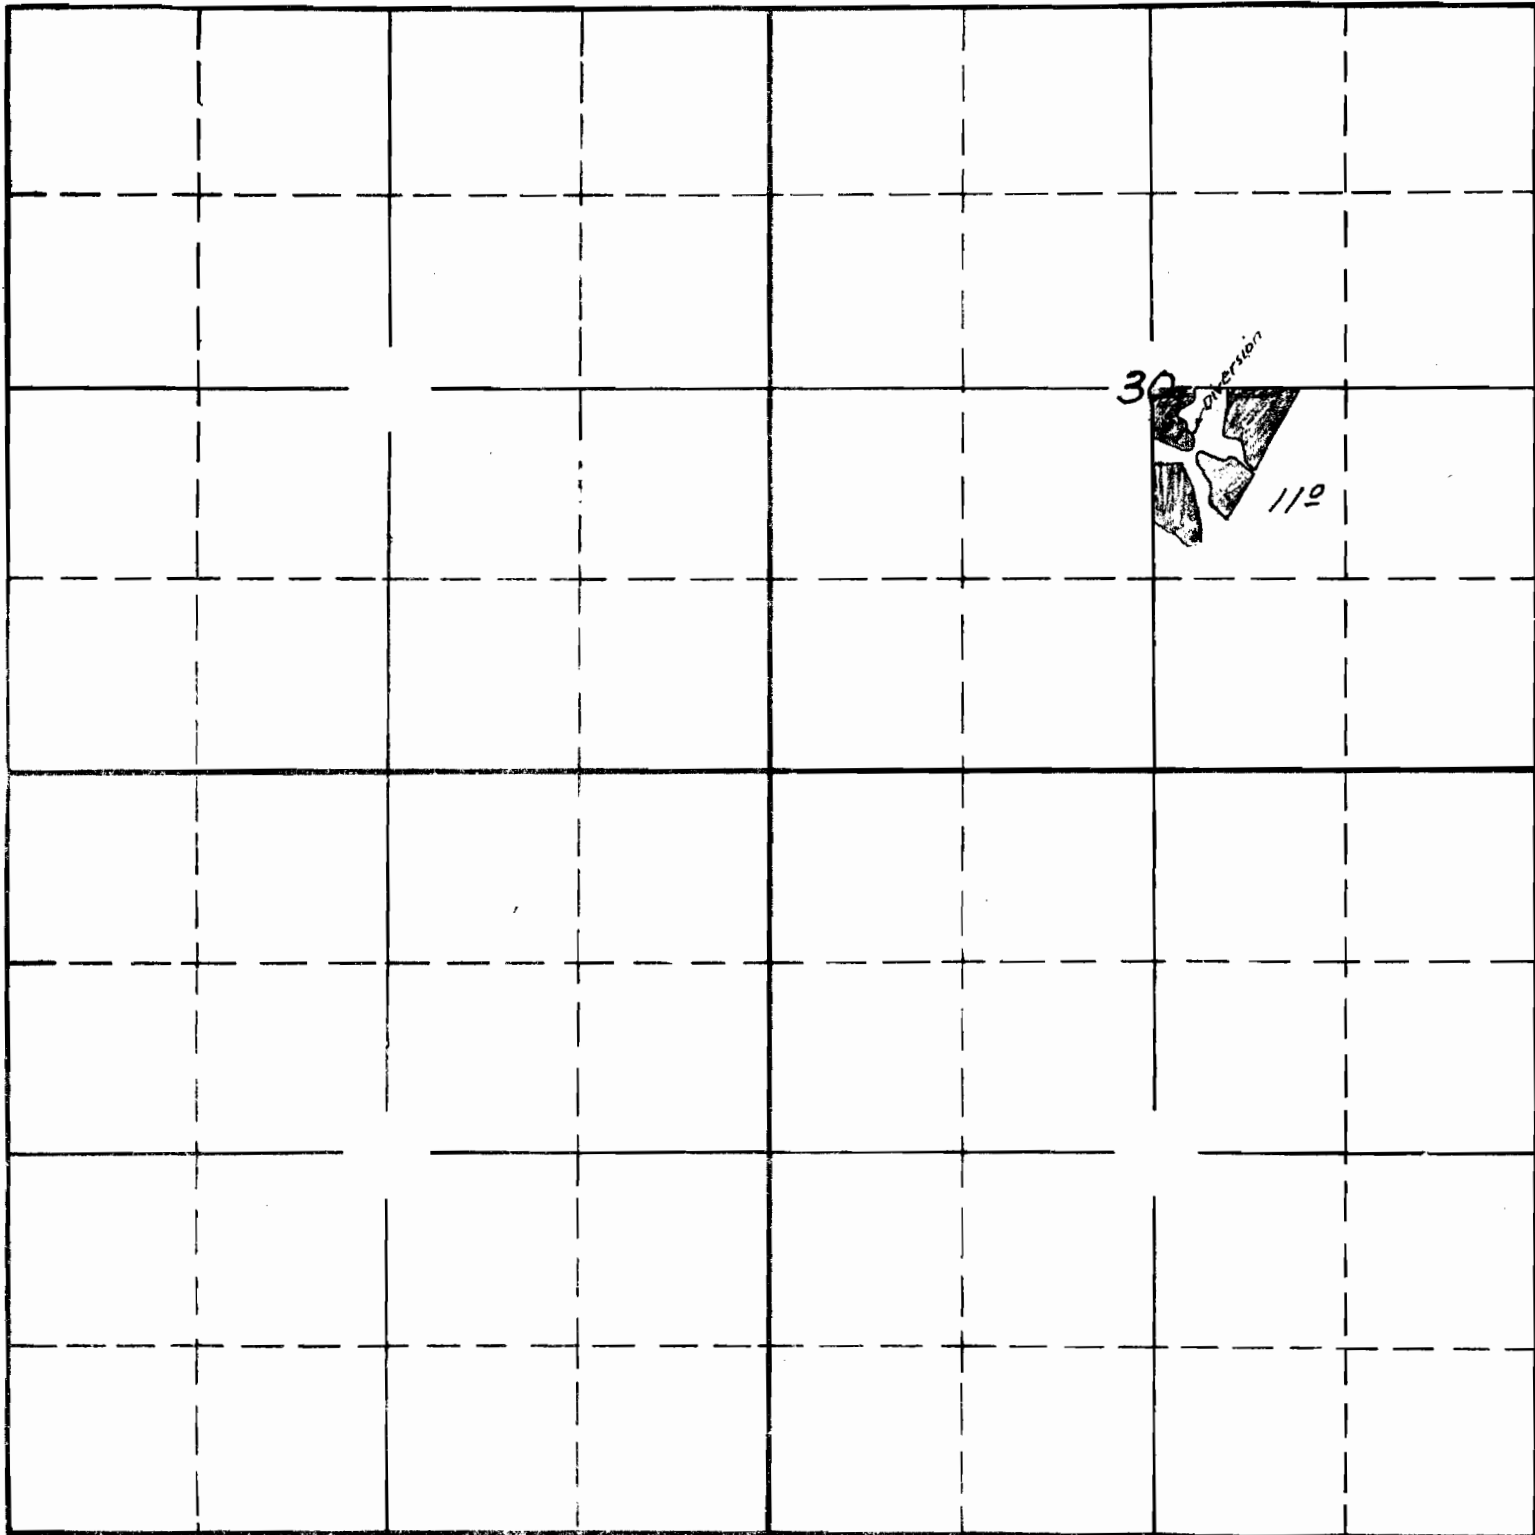

30

conversion

112

West

East

Surveyed June 8 1940 G.O.G.

South

APPLICATION No. 17585

PERMIT No. 13282