


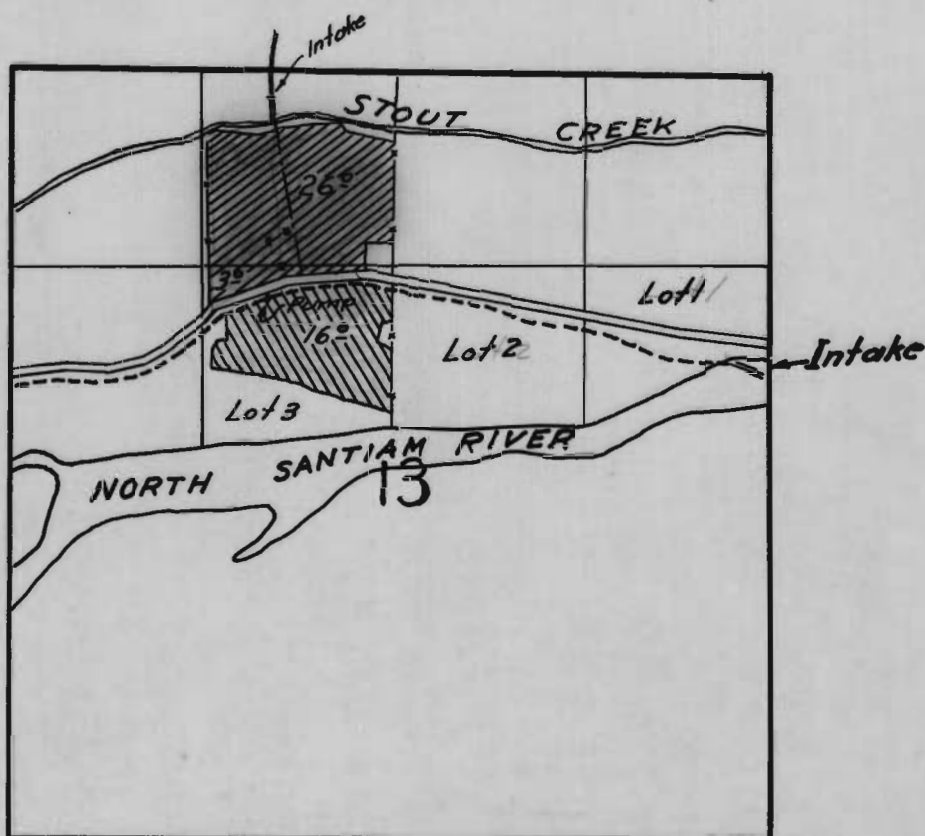

FINAL PROOF SURVEY

UNDER

17938

13620

Application No. 17642 Permit No. 13339

IN NAME OF

Joe C. Barrow

Surveyed May 15 1941, by L. L. Cummings