


30

TOWNSHIP 38 S, RANGE 4 W, W. M.

North

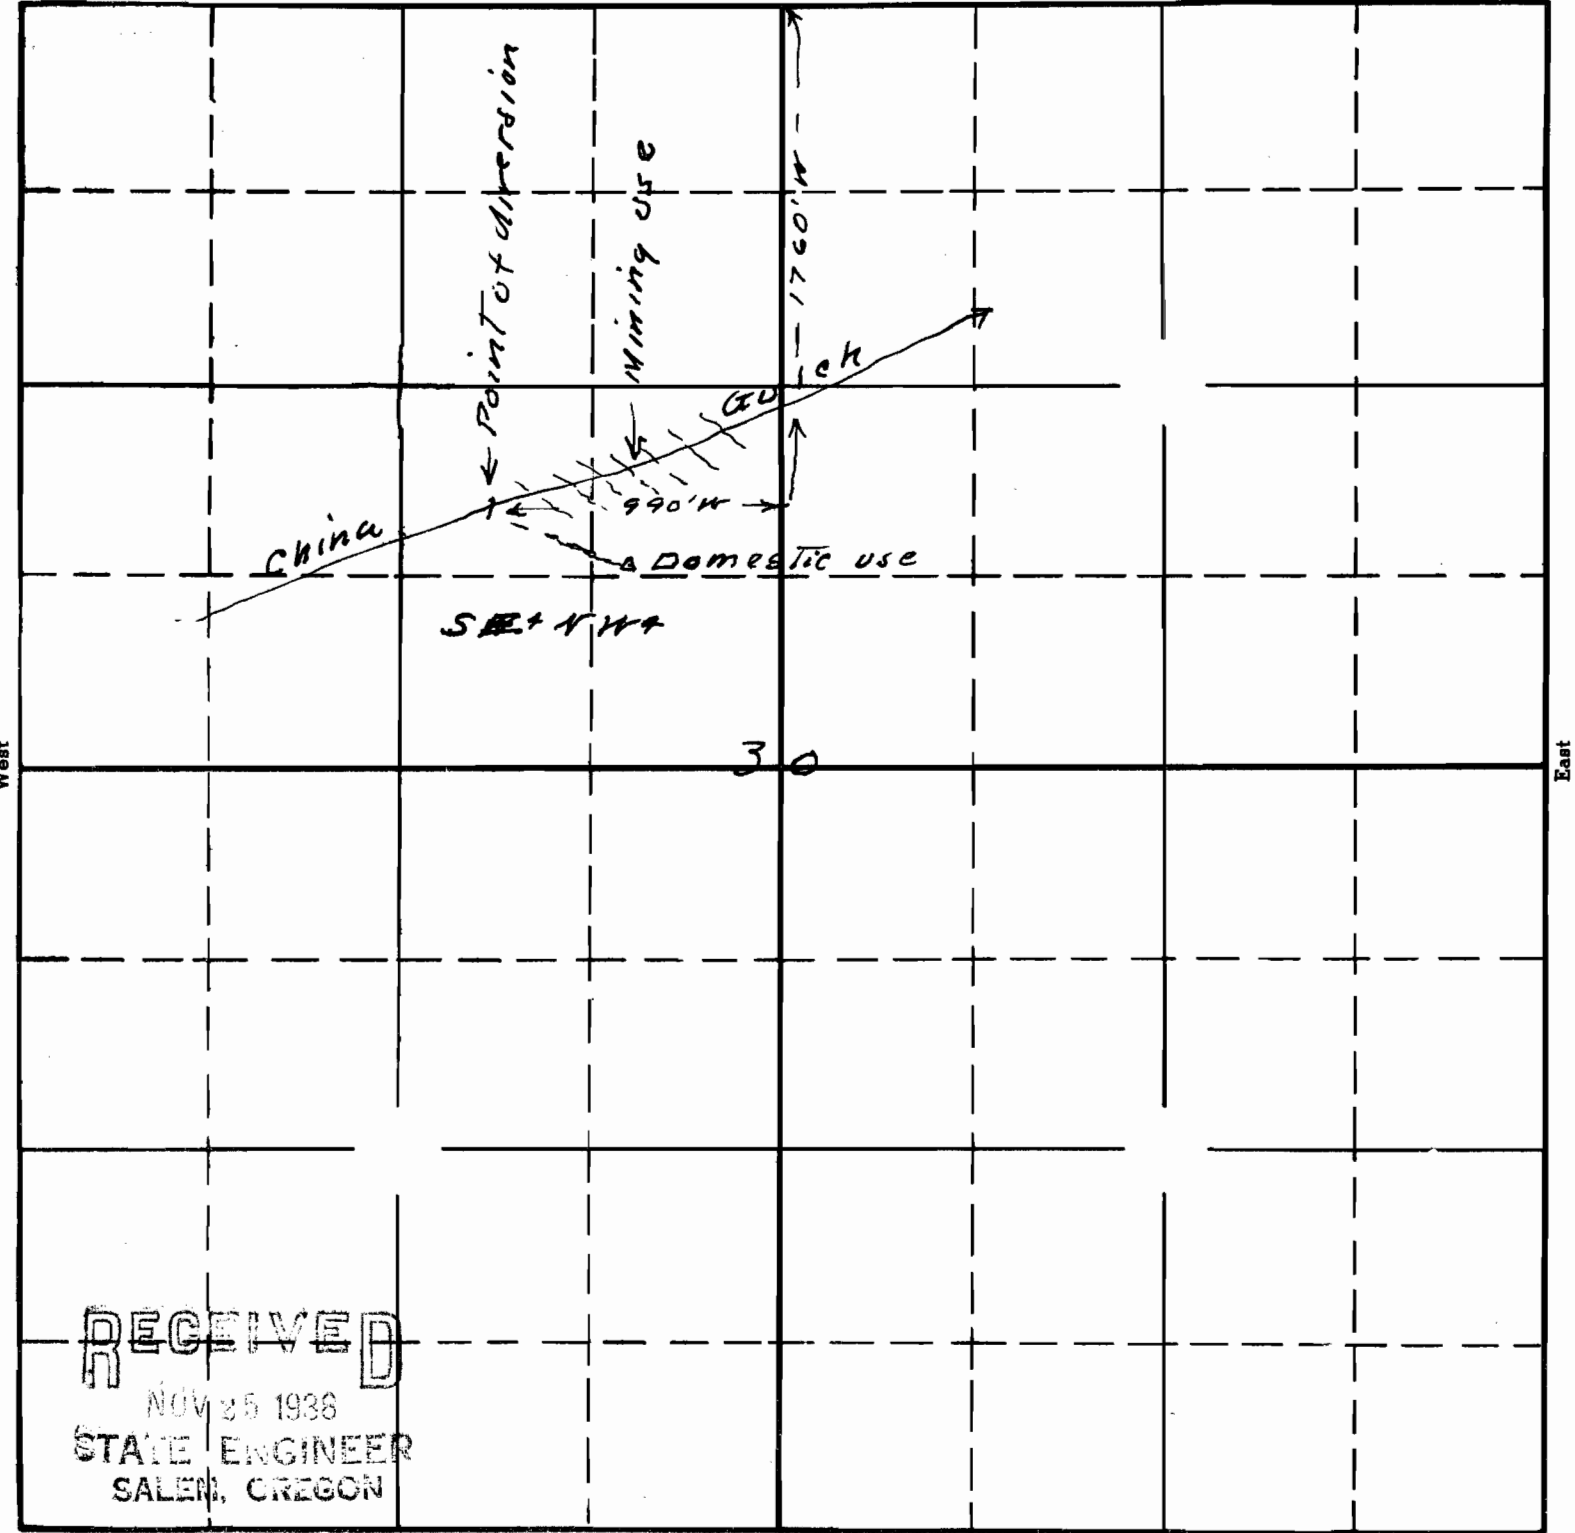

RECEIVED
 NOV 25 1938
 STATE ENGINEER
 SALEM, OREGON

Sketch to accompany application of
 G. K. Howard for use of waters of
 China Gulch for mining and domestic
 purposes.

made from measurements furnished
 by G. K. H.

This office 11/14/38 *Stinson*

17663 070
 15-16
 APPLICATION No. 17663
 PERMIT No. 13357