


SECTION

TOWNSHIP 21 S., RANGE 3E, W. M.

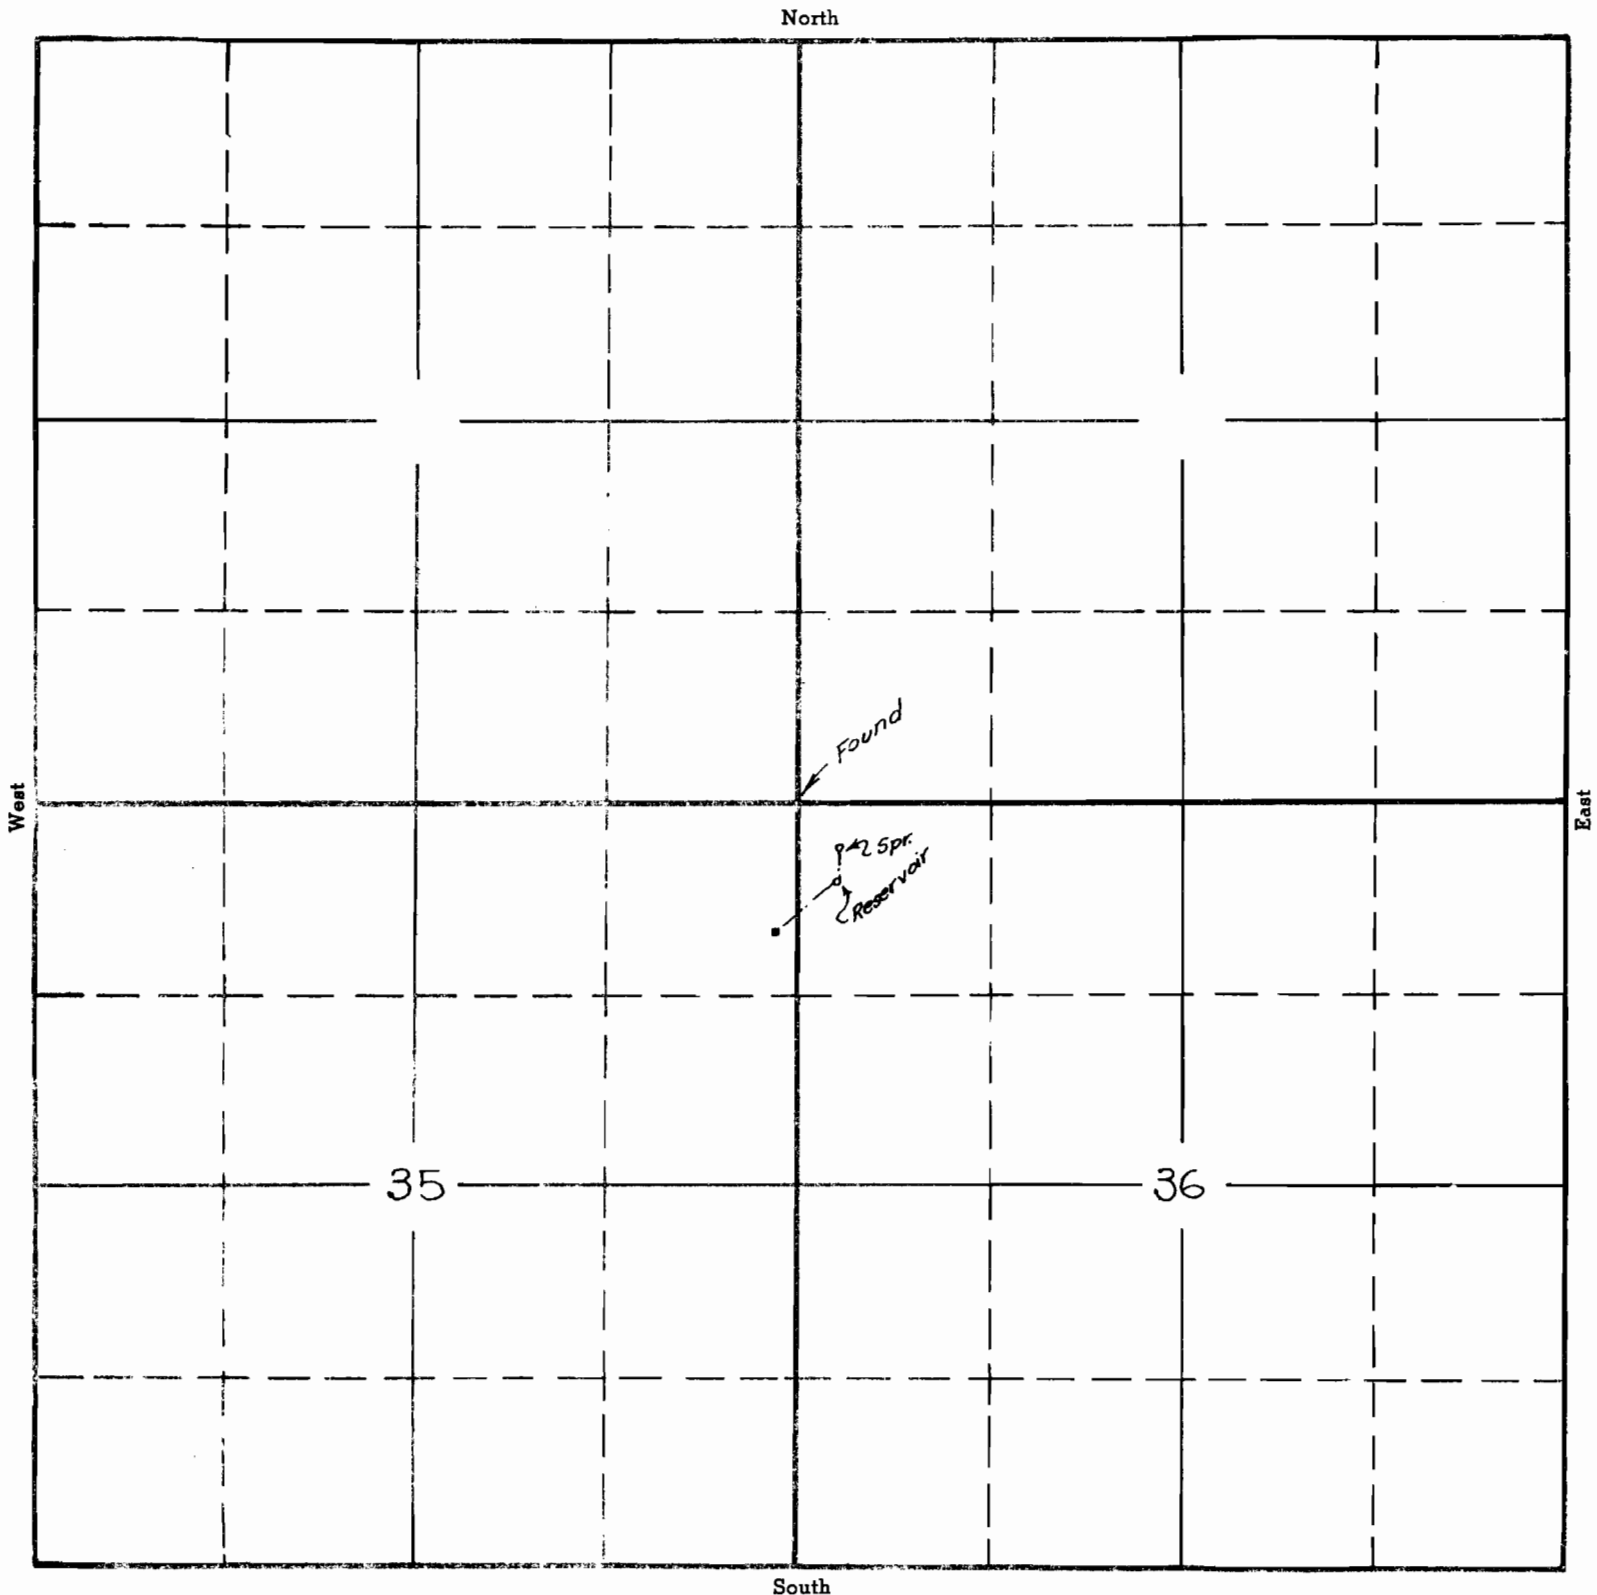

APPLICATION No. 17723  
PERMIT No. 13393