


SECTION

TOWNSHIP 38 S., RANGE 5 W., W. M.

Scale 4"=1 Mile

Jan. 1939.

North

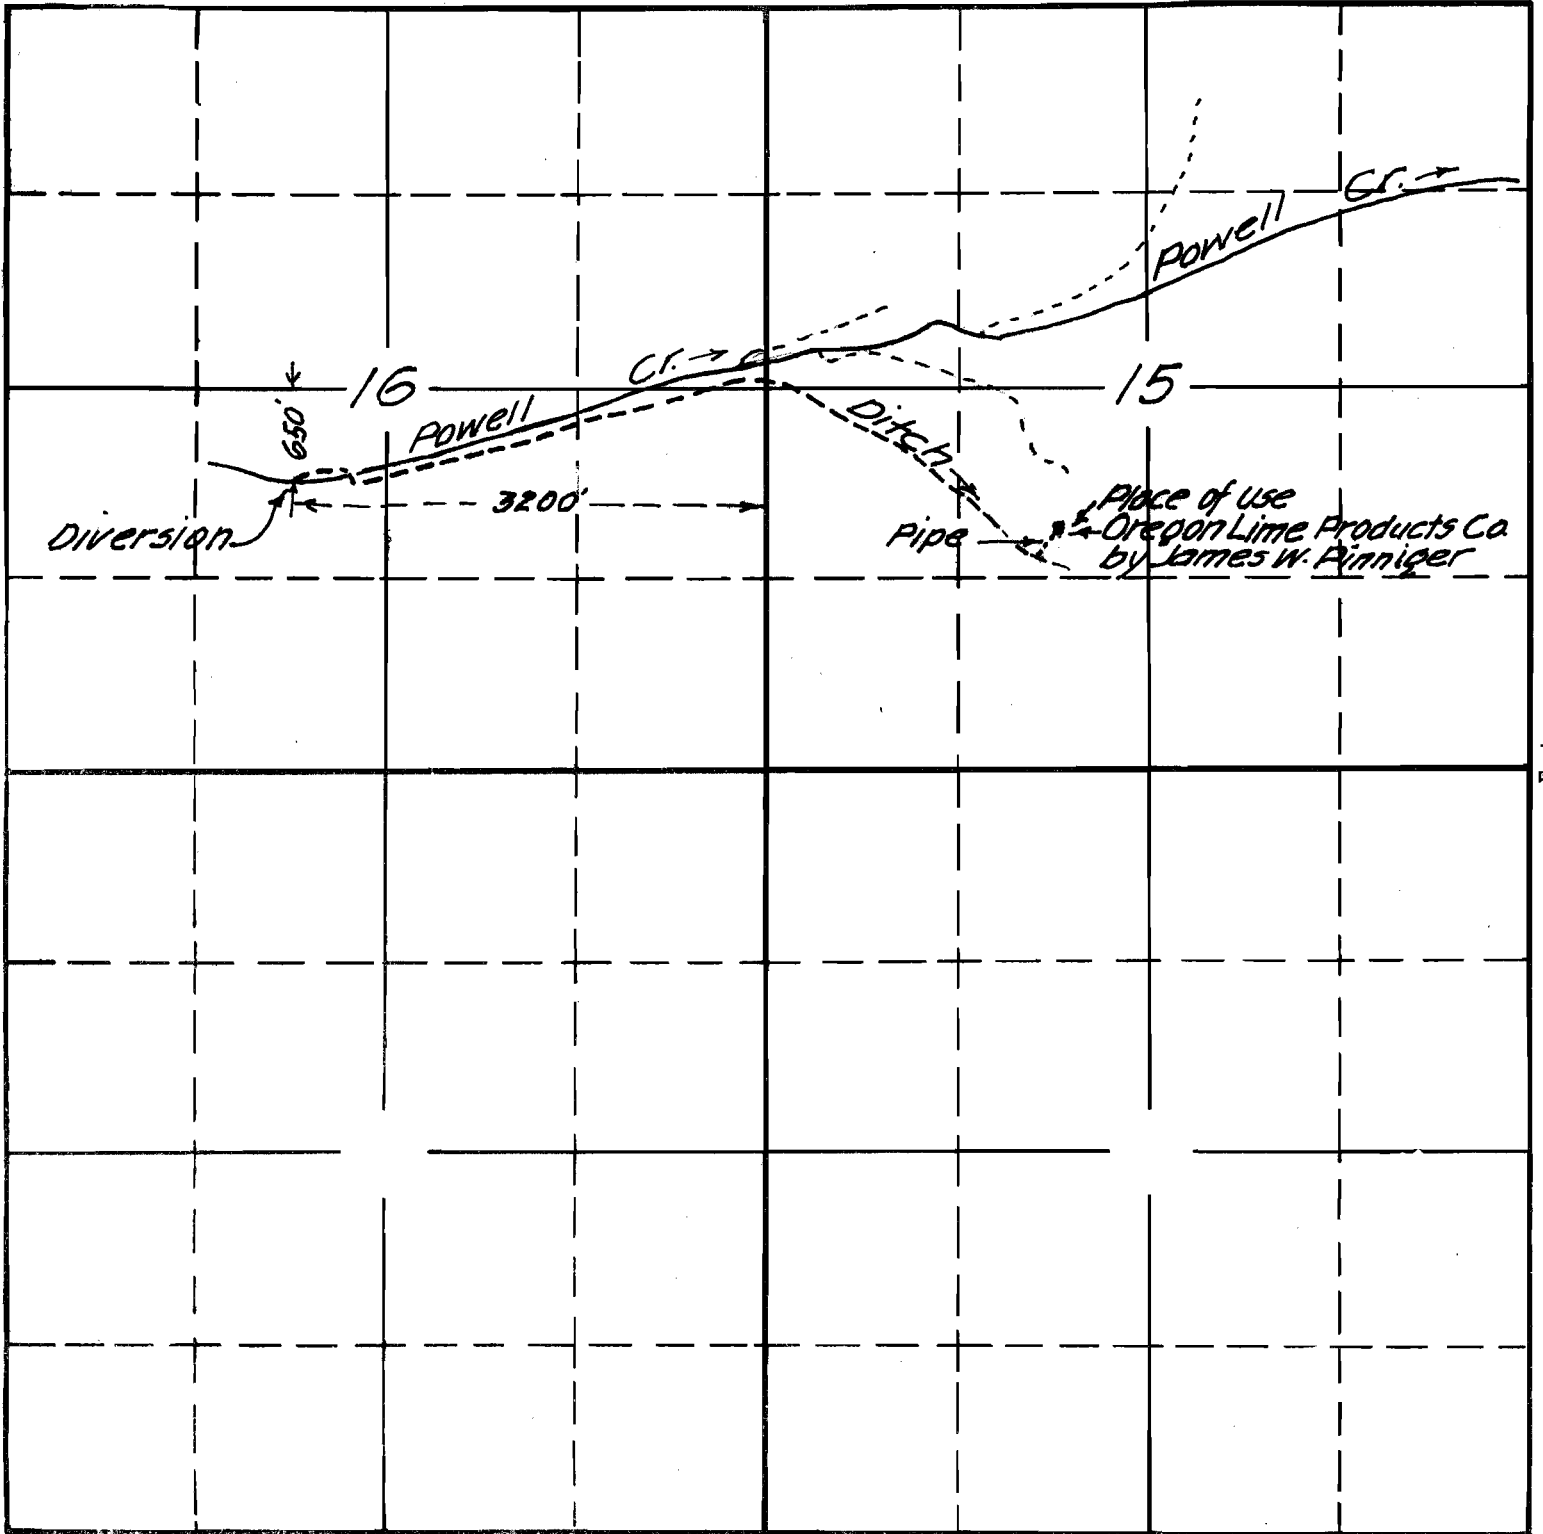

South

17735 OF
15-16 W

APPLICATION No. 17735

PERMIT No. 13401

RECEIVED

JAN 7 1939

STATE ENGINEER
SALEM, OREGON