SECTION

TOWNSHIP 34 S, RANGE 8 W., W. M.

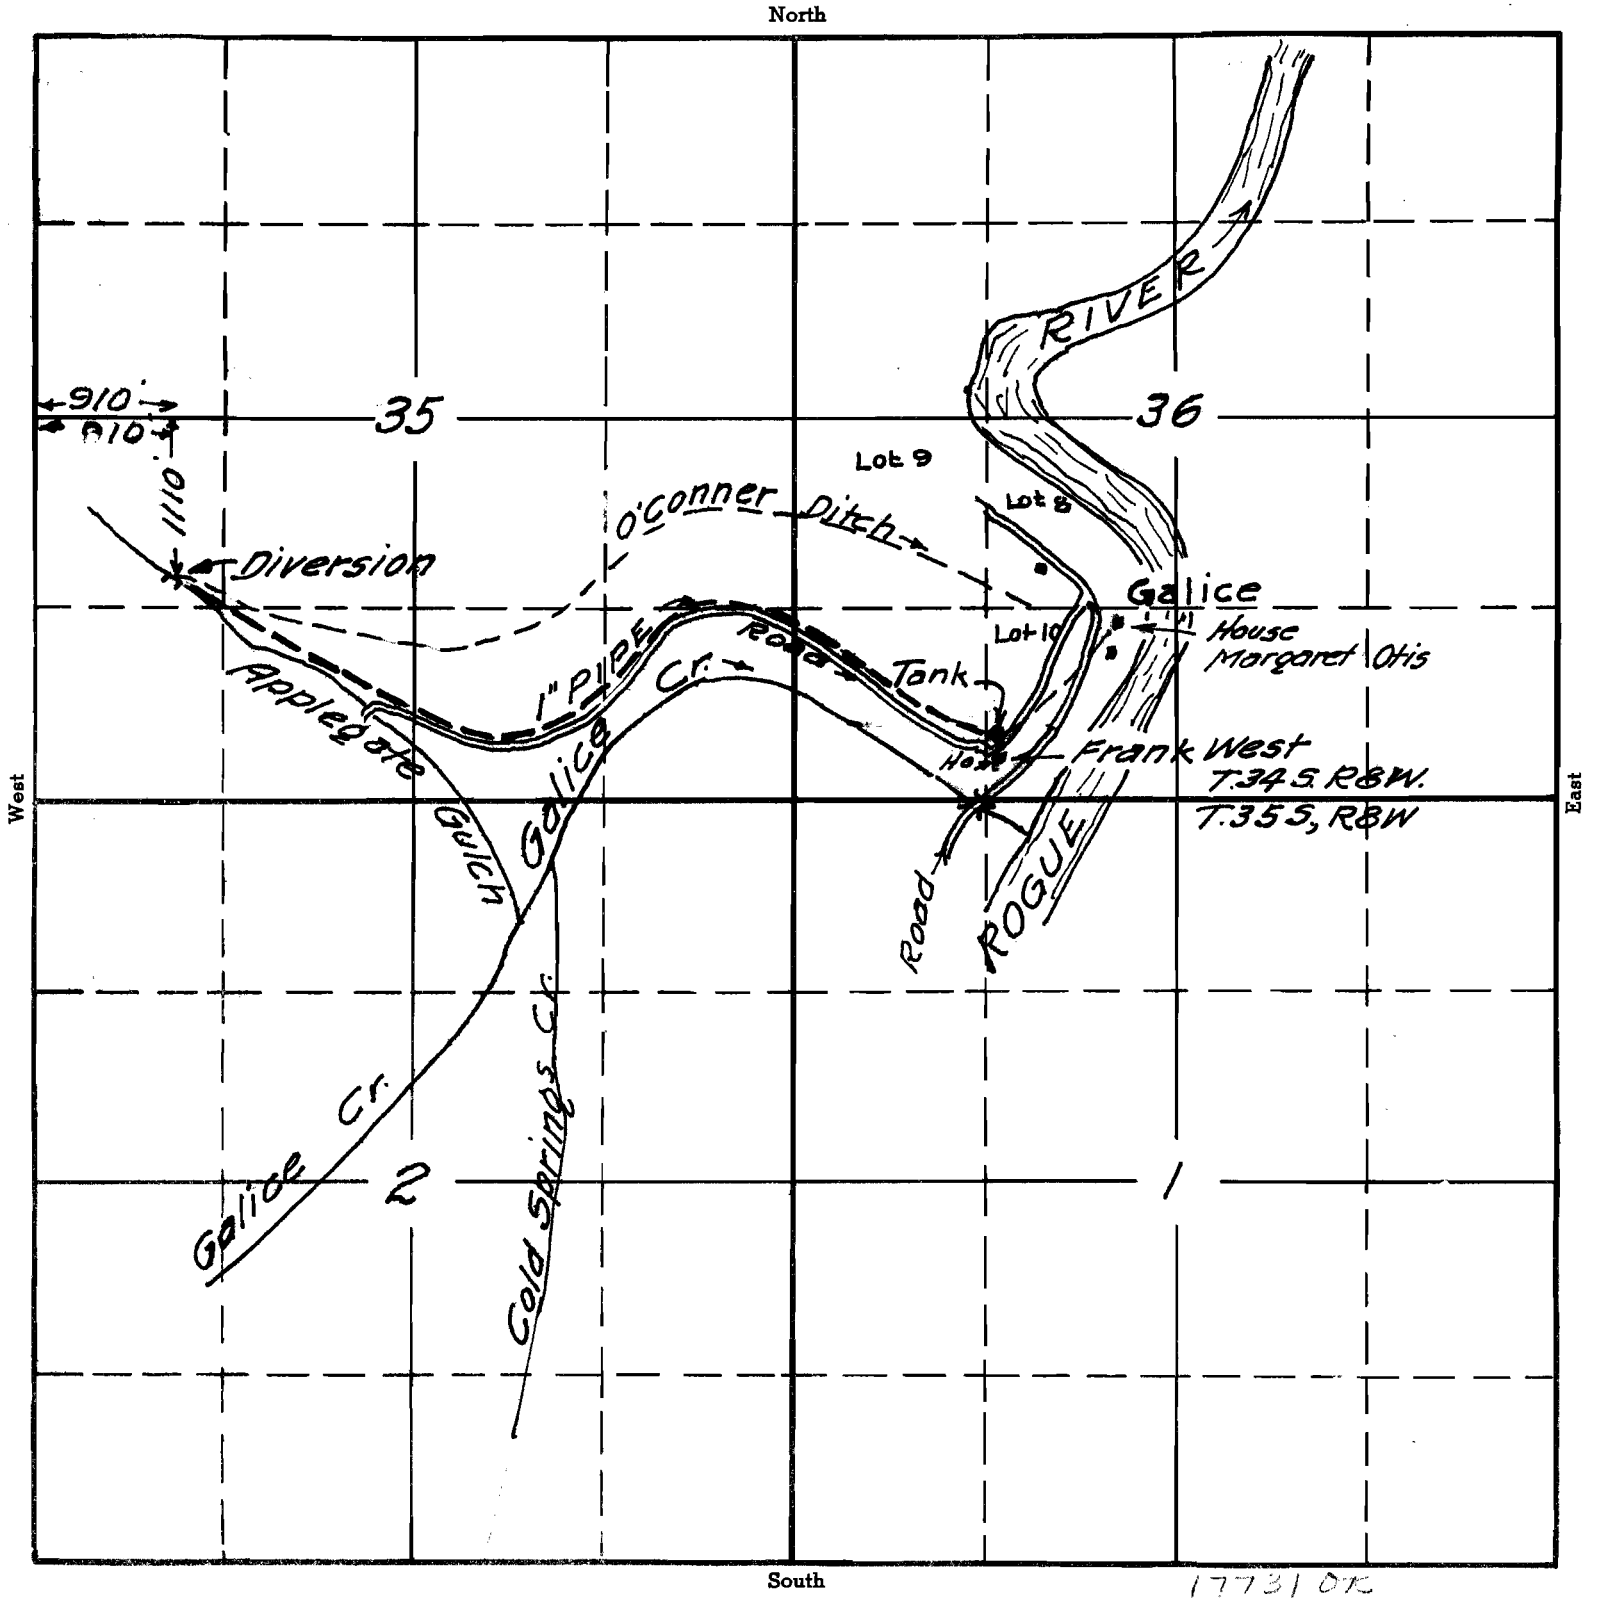

17731 OK
15-76

APPLICATION No. 17731
PERMIT No. 13406

RECEIVED
JAN 6 1936
STATE ENGINEER
SALEM, OREGON