


SECTION

TOWNSHIP 18S, RANGE 10W, W. M.

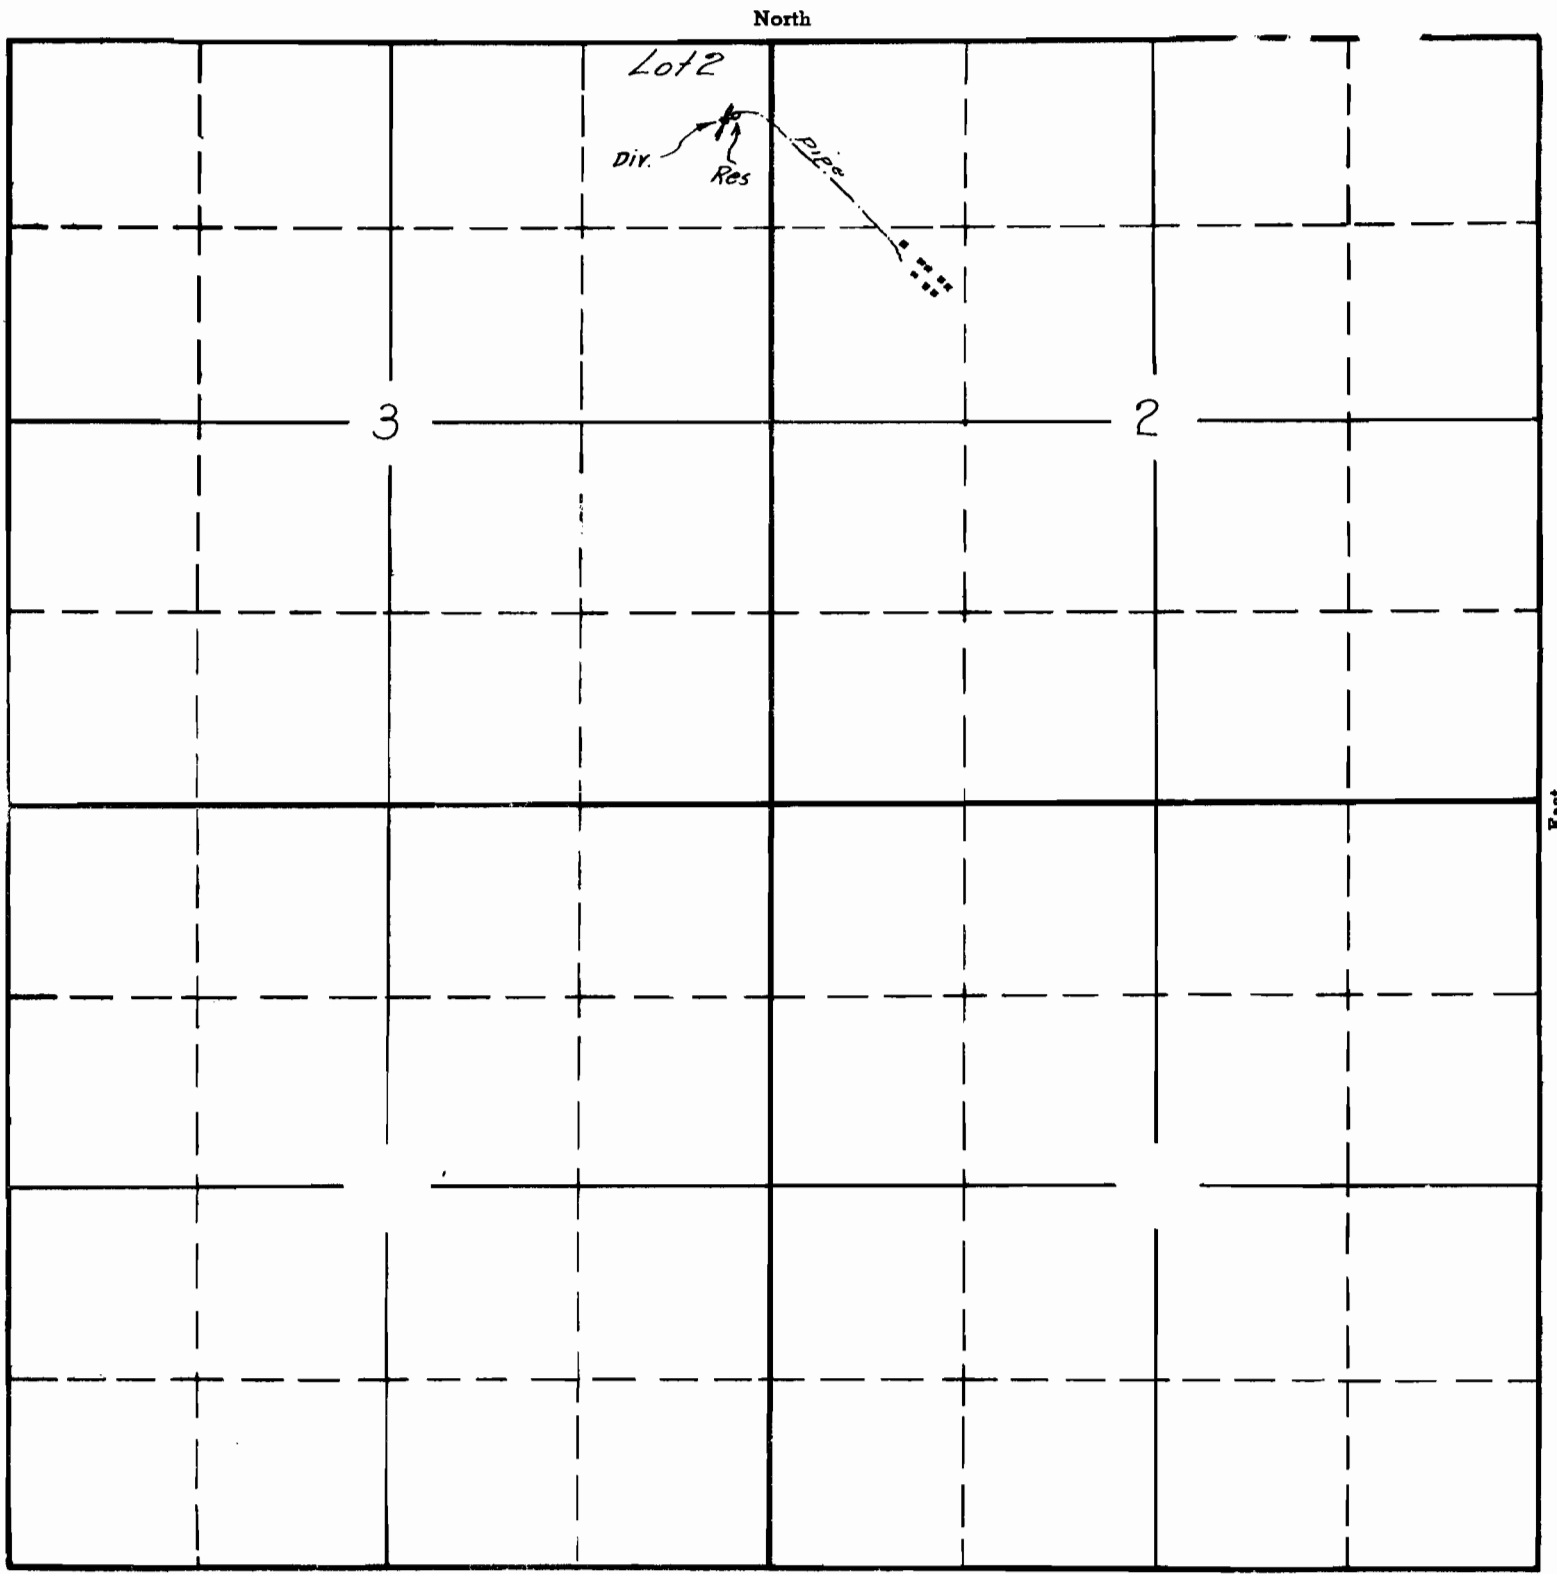

inspected by  
C A Cummings  
June 19 1939

APPLICATION No. 17707  
PERMIT No. 13431