


SECTION

TOWNSHIP 1N, RANGE 3E, W. M.

North

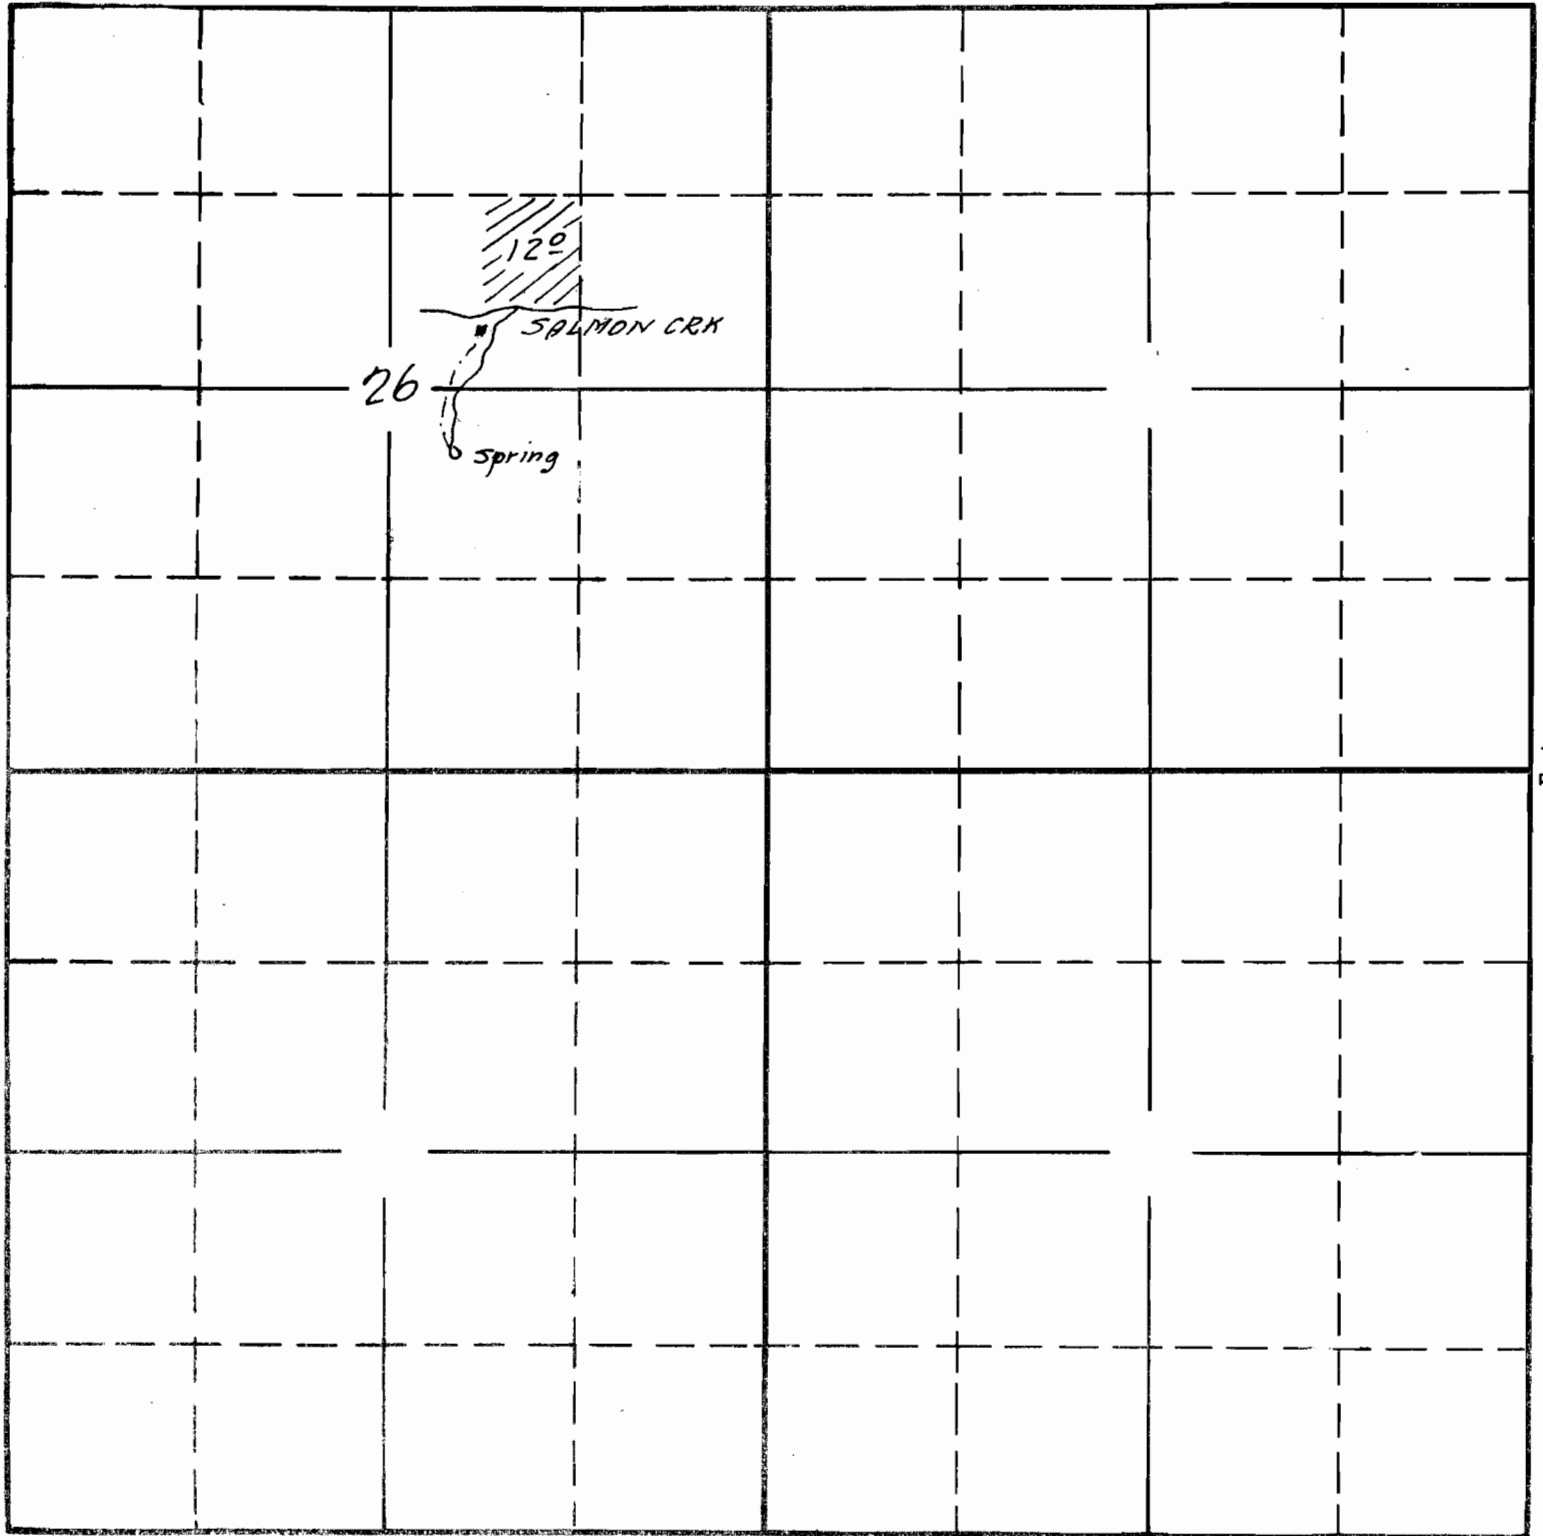

Sketched in office of
State Eng from data
by applicant 1-13-'39

South

17746
3-3
APPLICATION No. 17746
PERMIT No. 13441

[illegible][illegible]

Lot 4

44

Lot 5

80

Pond

Lot 6

James M. Stott
D.L.C. 48

26

SPT

D.F. Buxton
D.L.C. 59

South

PERMIT No. 13441