



T. 39 S. R. 5 W.W.M.

13477

39-5-24

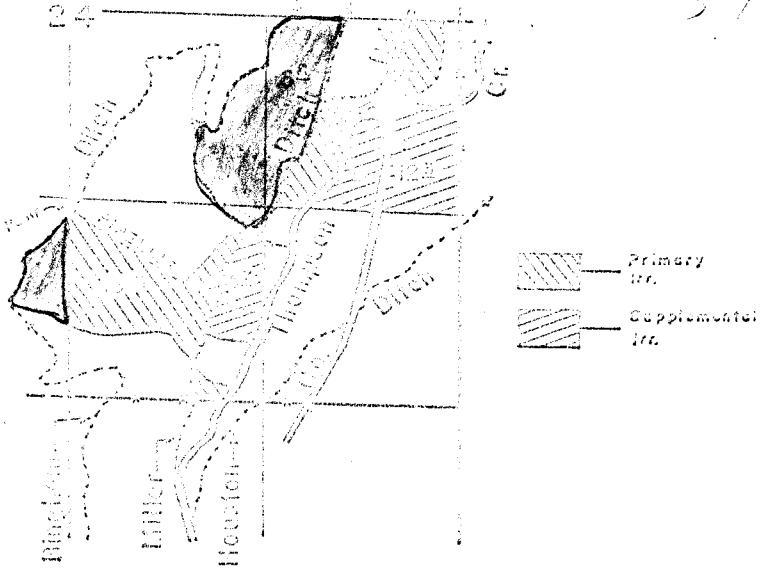

T. 40 S. R. 5 W.W.M.

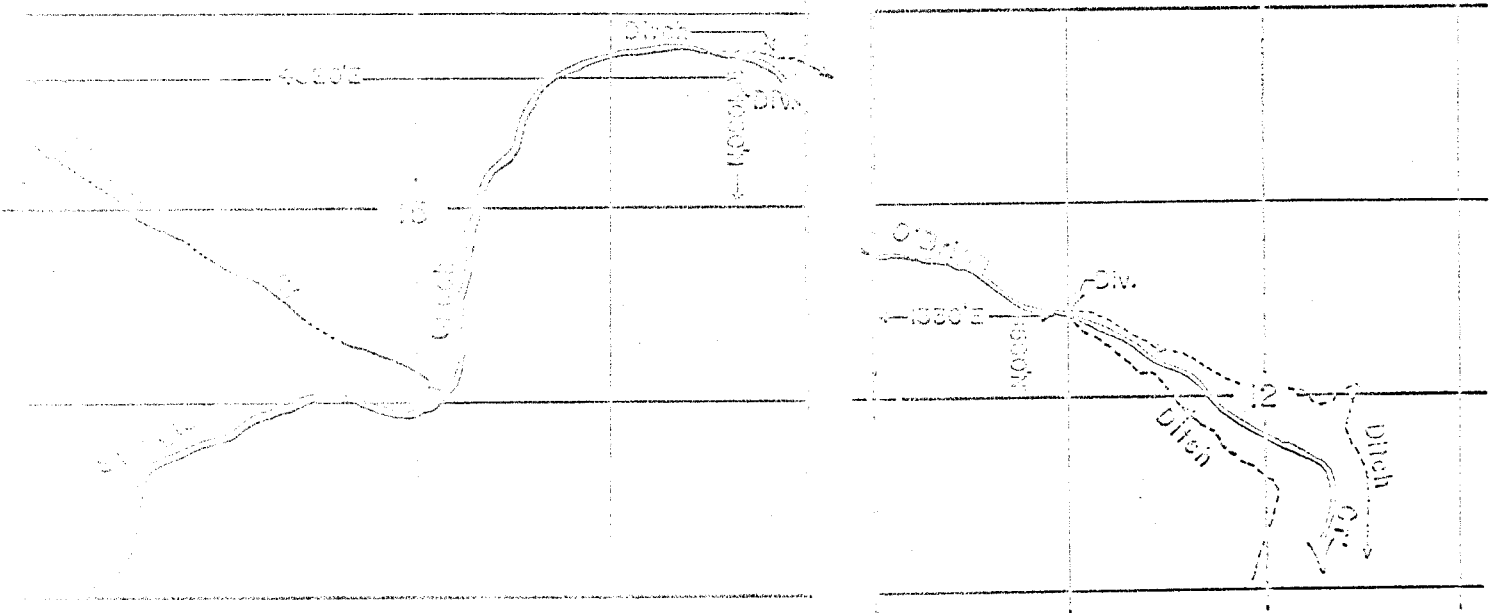

TO FLOOD SURVEY UNDER

Application No. 1793 Permit No. 13477  
IN NAME OF

Frances Bross

Surveyed Jan. 15, 1927, by G.C. Hendrix