


Twp. 21 Range 26

Showing lands irrigated P.C. Peterson Permit No 13494

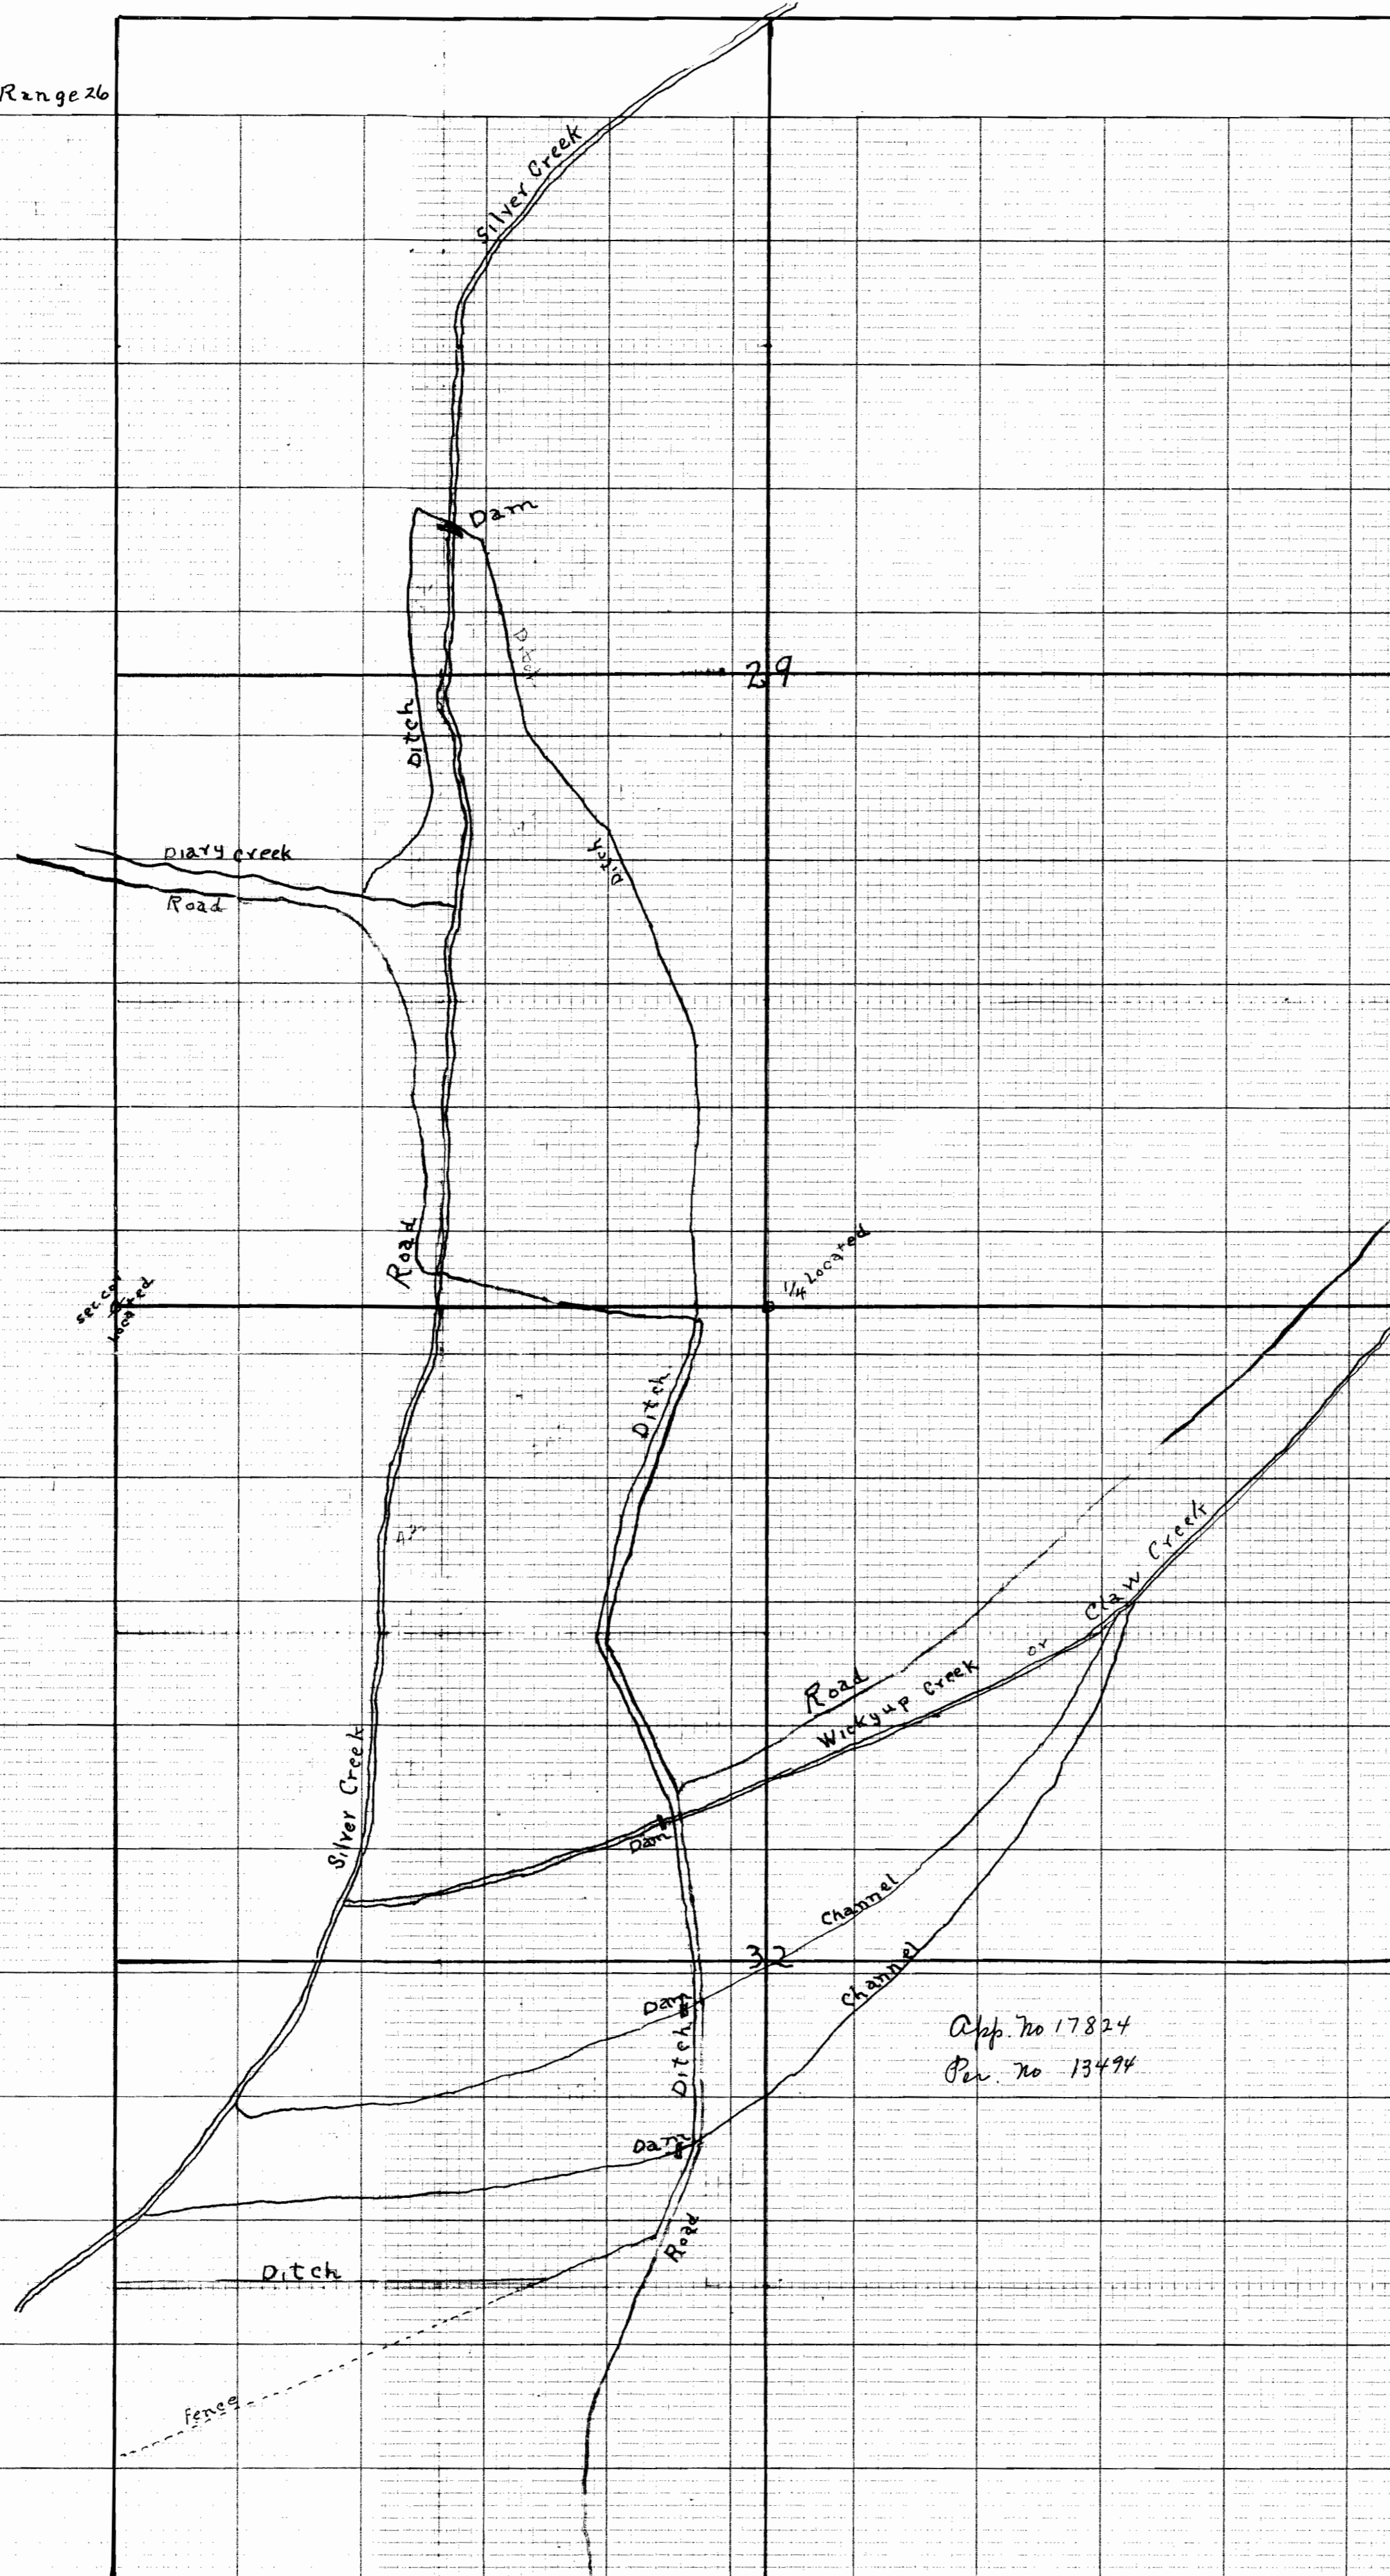

App. No 17824
Per. No 13494