


28

TOWNSHIP 36 S, RANGE 2 W, W. M.

North

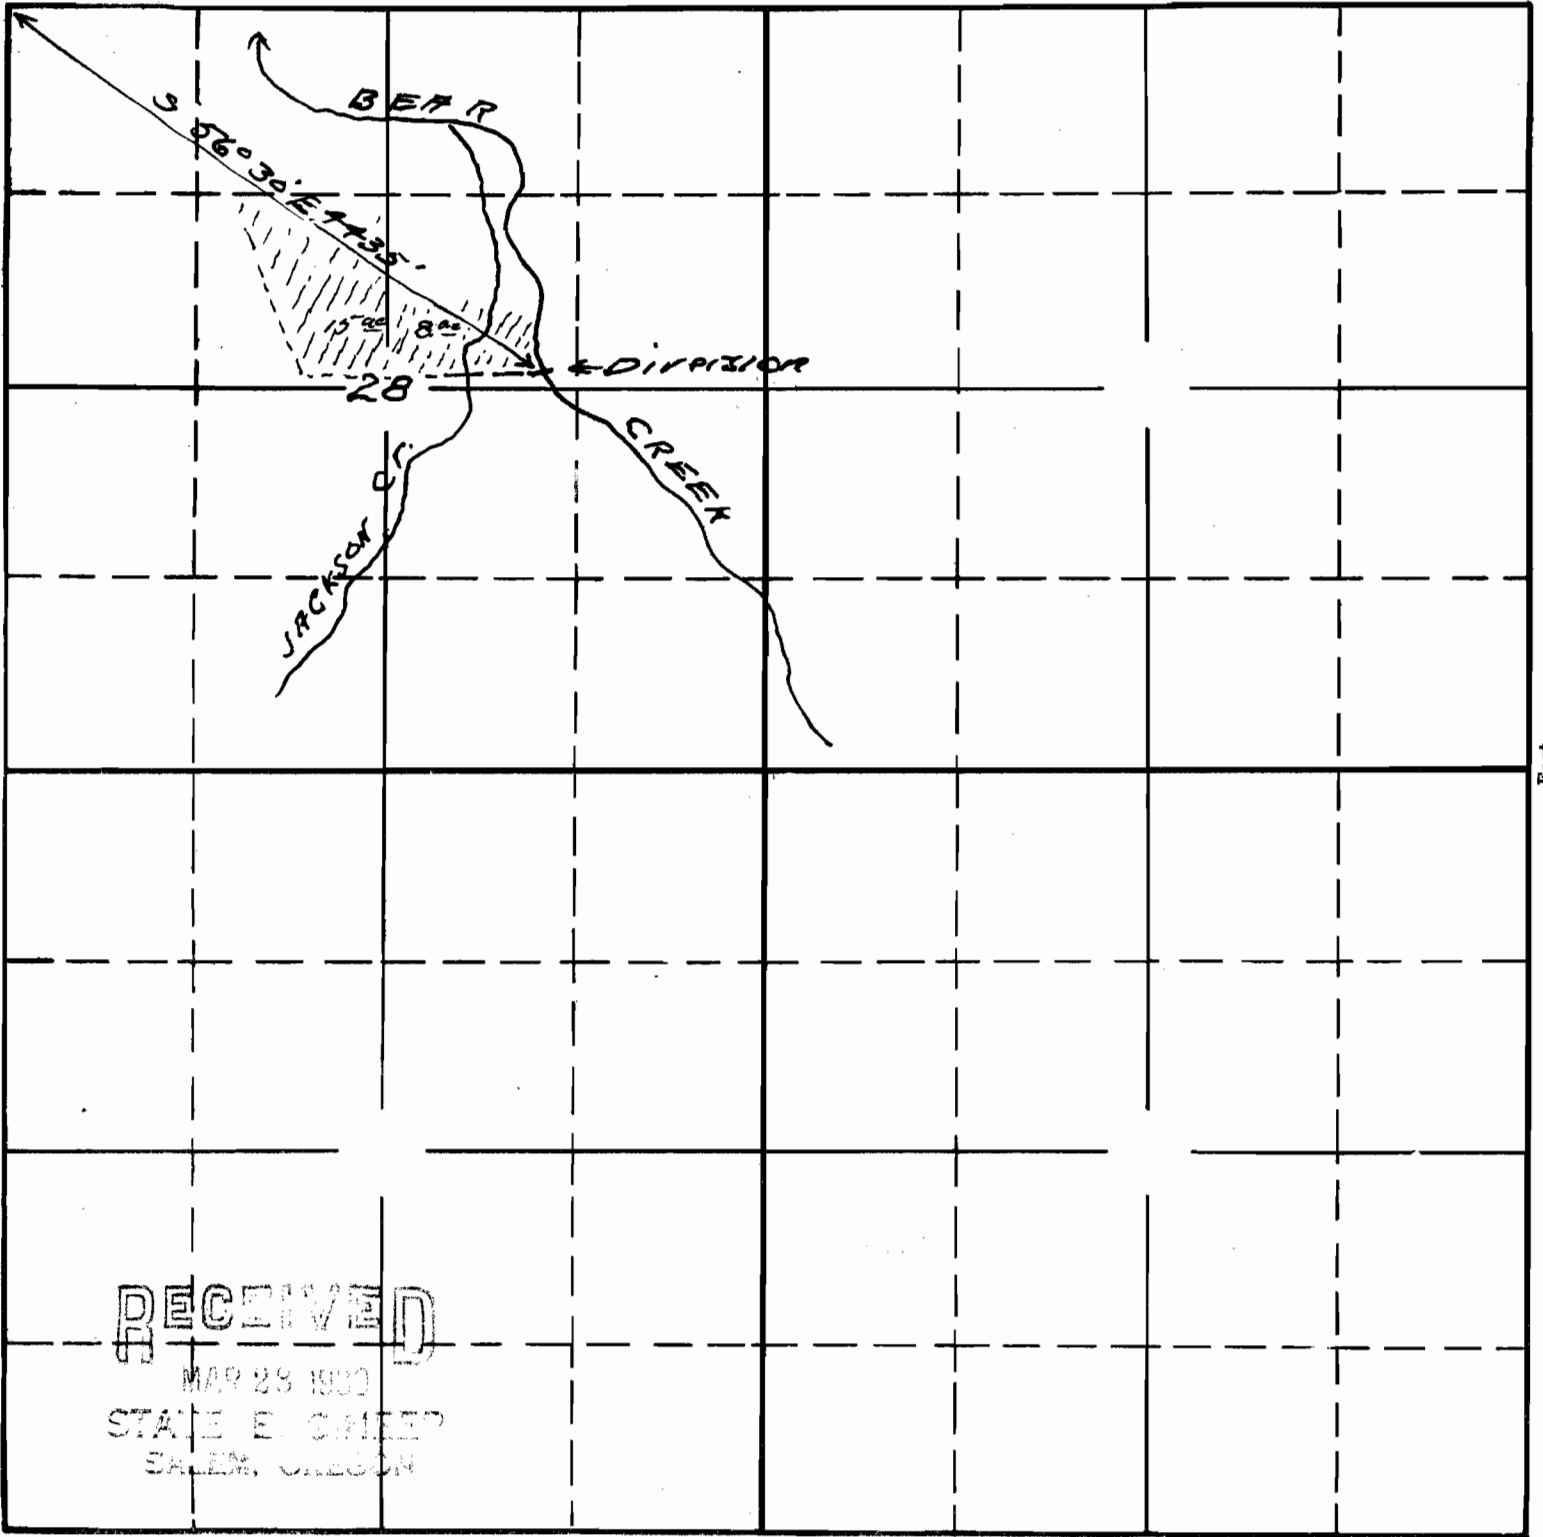

West

East

South

Sketch to accompany application of
 W.H. PENNINGER for use of waters of
 Bear Creek for irrigation purposes
 Tie made from actual survey by
 C.Z. Boyden surveyor.
 This water right to be subsequent to
 rights of R.R.V.I. Dist

17861 57c
 15-76
 APPLICATION No. 17861
 PERMIT No. 13542

This study 3/24/30 C.S. Smith