


SECTION

TOWNSHIP ~~6N~~ ^{7N}, RANGE ~~4W~~ ^{9W}, W. M.

North

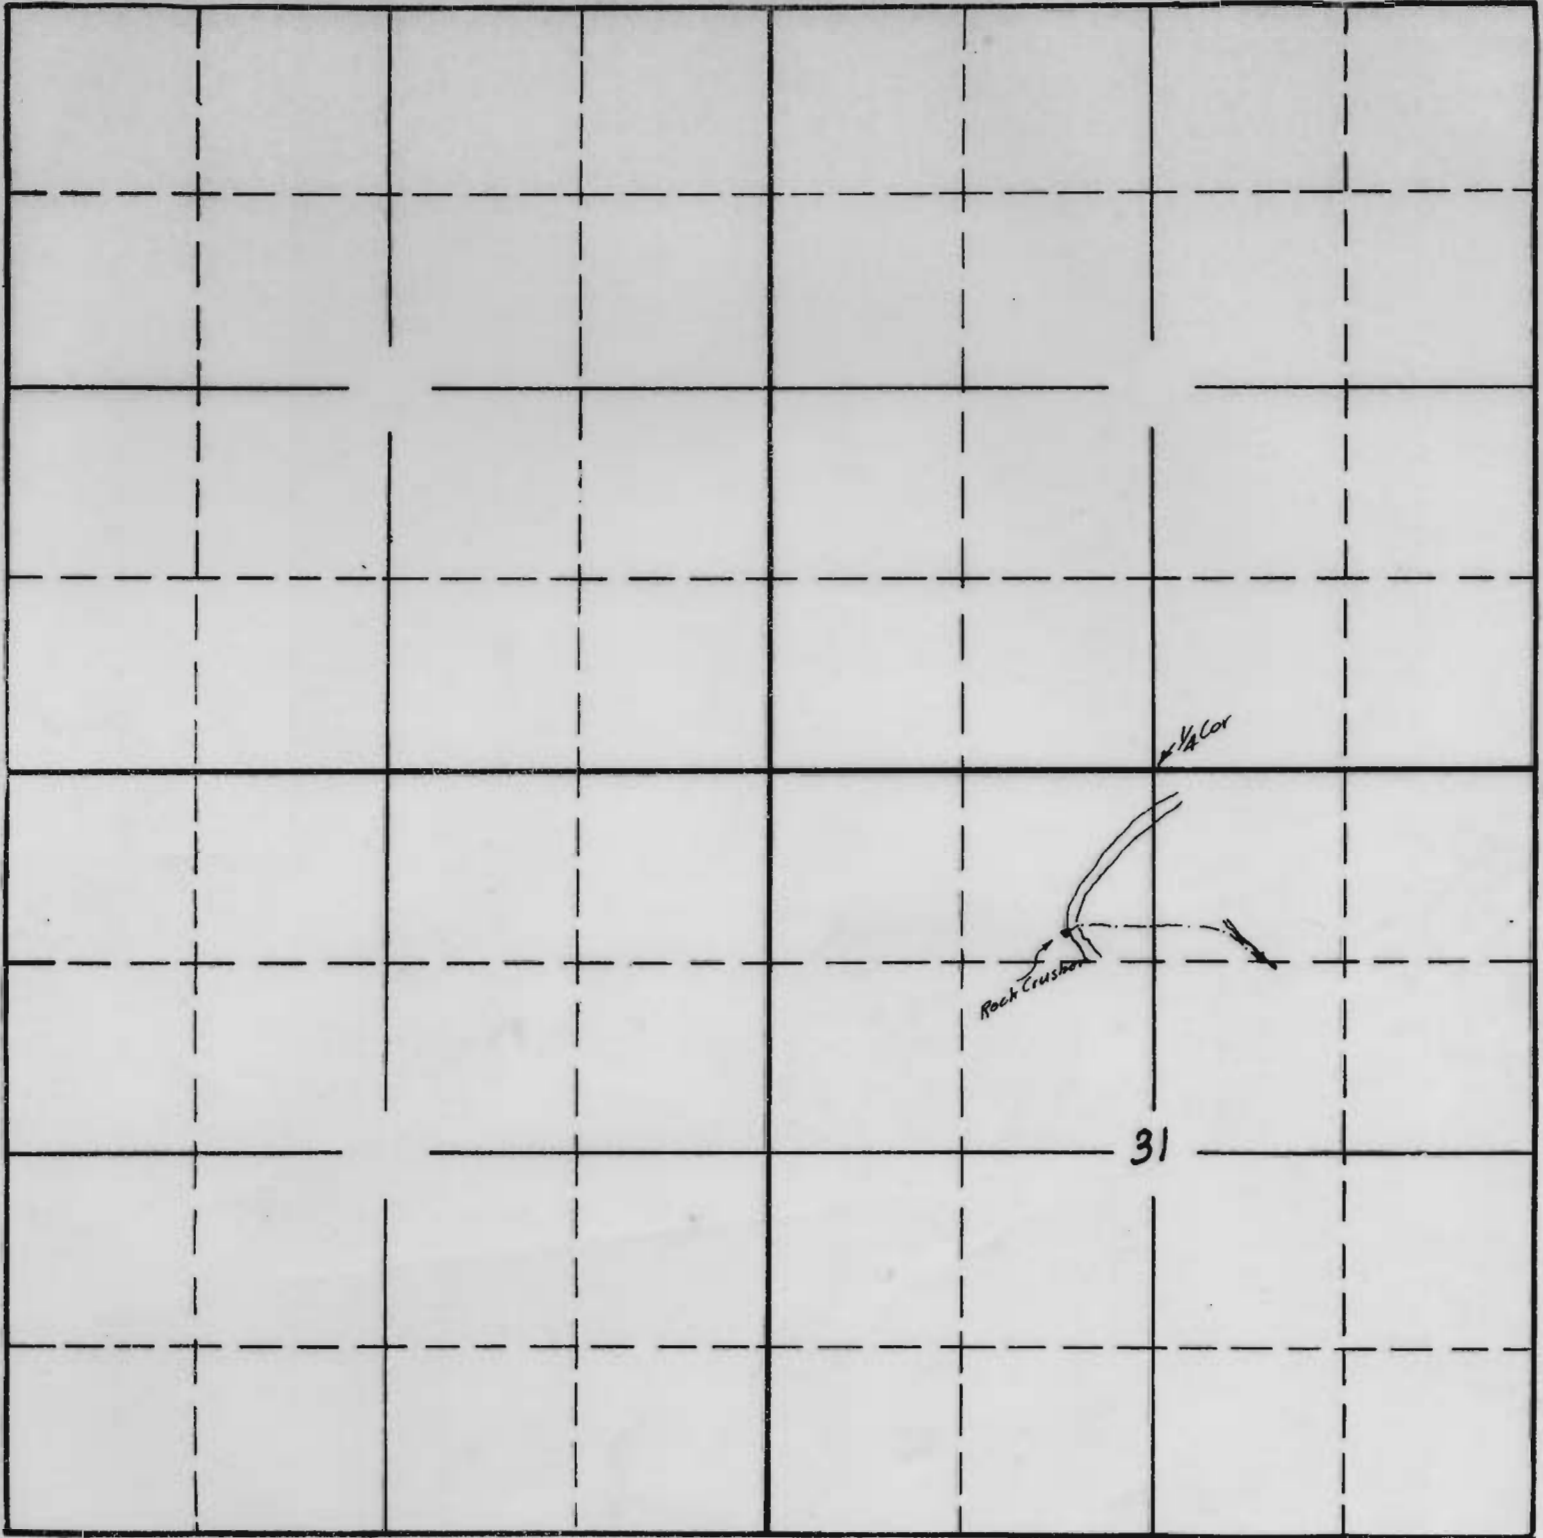

West

East

Surveyed by CAB May 30 1939 South

APPLICATION No. 17872

PERMIT No. 13548