


SECTION

TOWNSHIP 55, RANGE 3W, W. M.

North

West

East

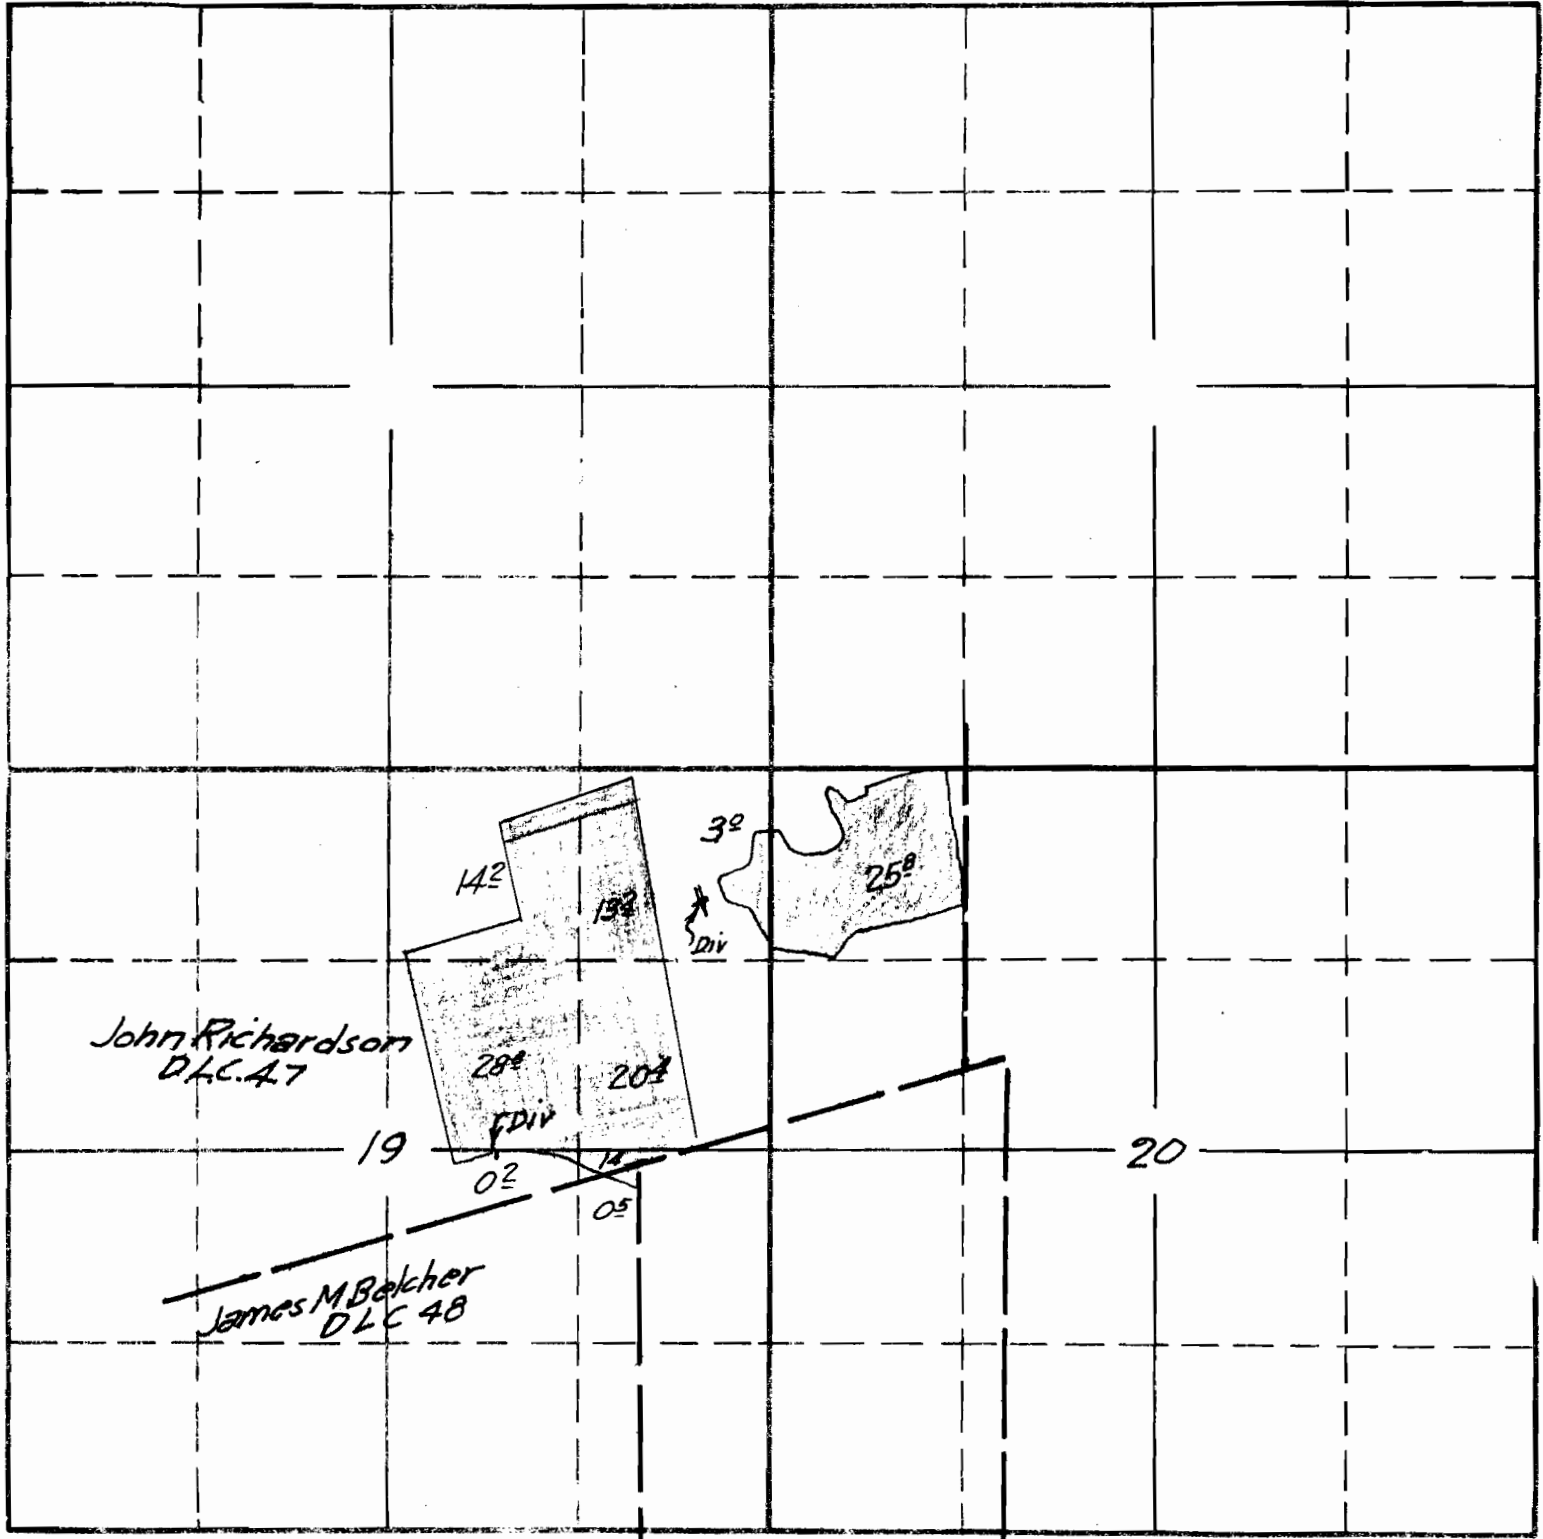

South

Surveyed June 4, 1940 C.E.C.

16132
 APPLICATION No. 18167
 PERMIT No. 13568
 12002

SECTION

19


20

T55. R.3 W.

TOWNSHIP

RANGE

W. M.

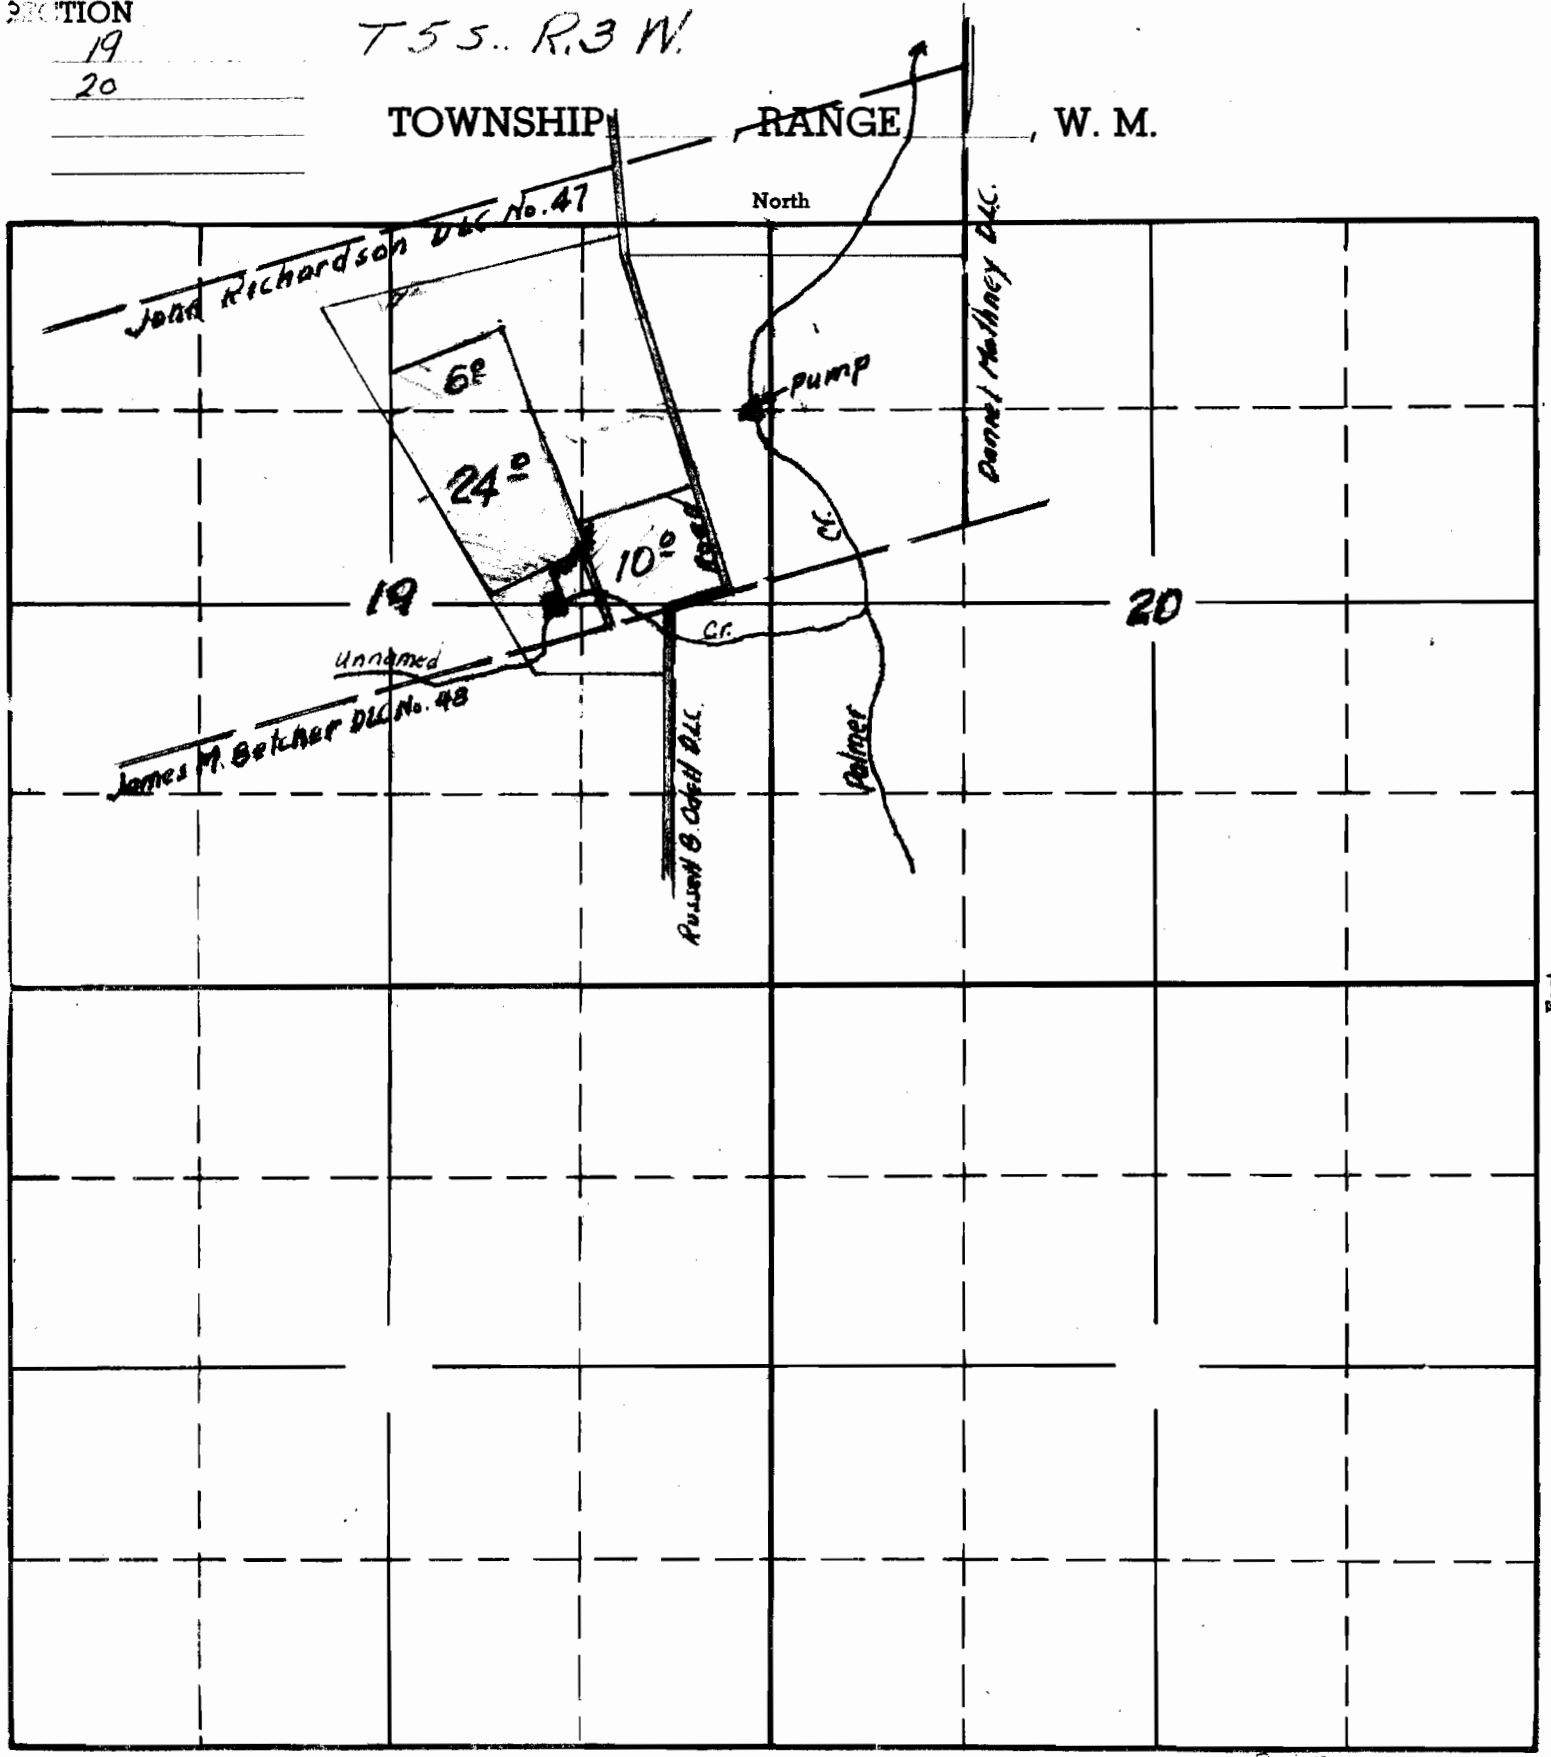

South

18167 OK
2-10E

APPLICATION No. 18167

PERMIT No. 13568

Sketch prepared from Govt Plats
and Metskers Map.