


2571

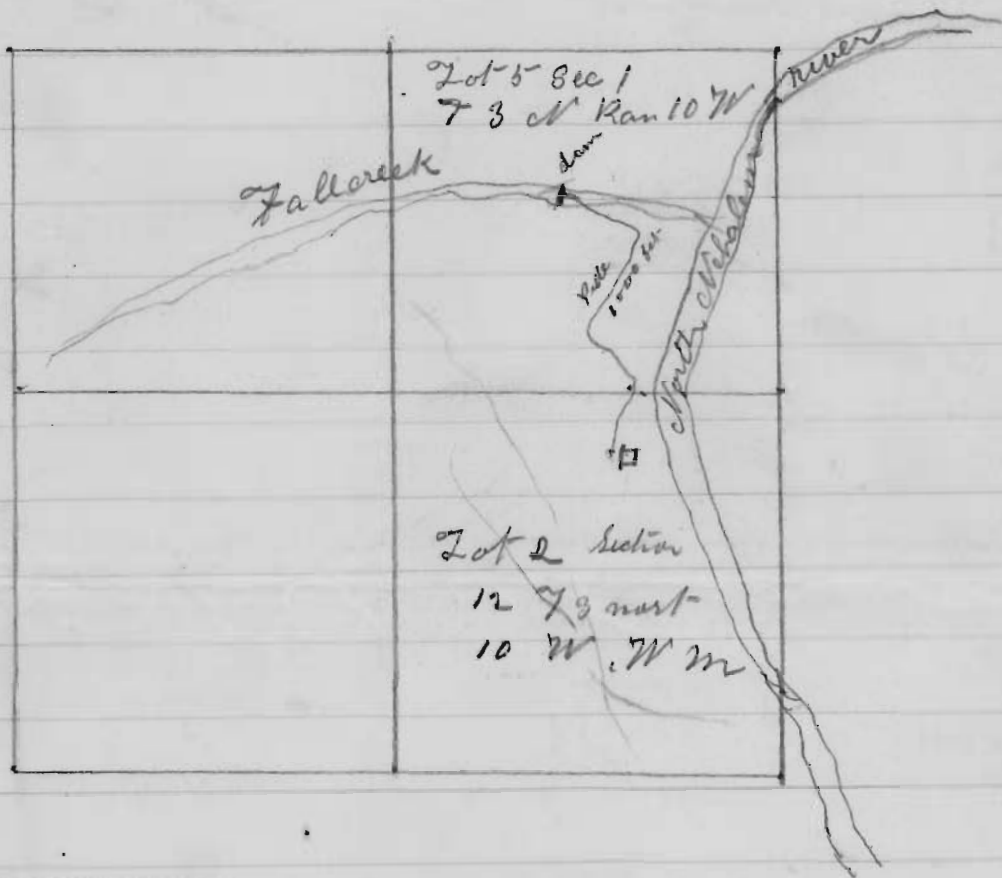

OFFICE OF STATE ENGINEER
RECEIVED
SEP 11 1912
SALEM, OREGON

Application 2571
Permit No. 1358