


SECTION

3

TOWNSHIP 12.5, RANGE 5W, W. M.

North

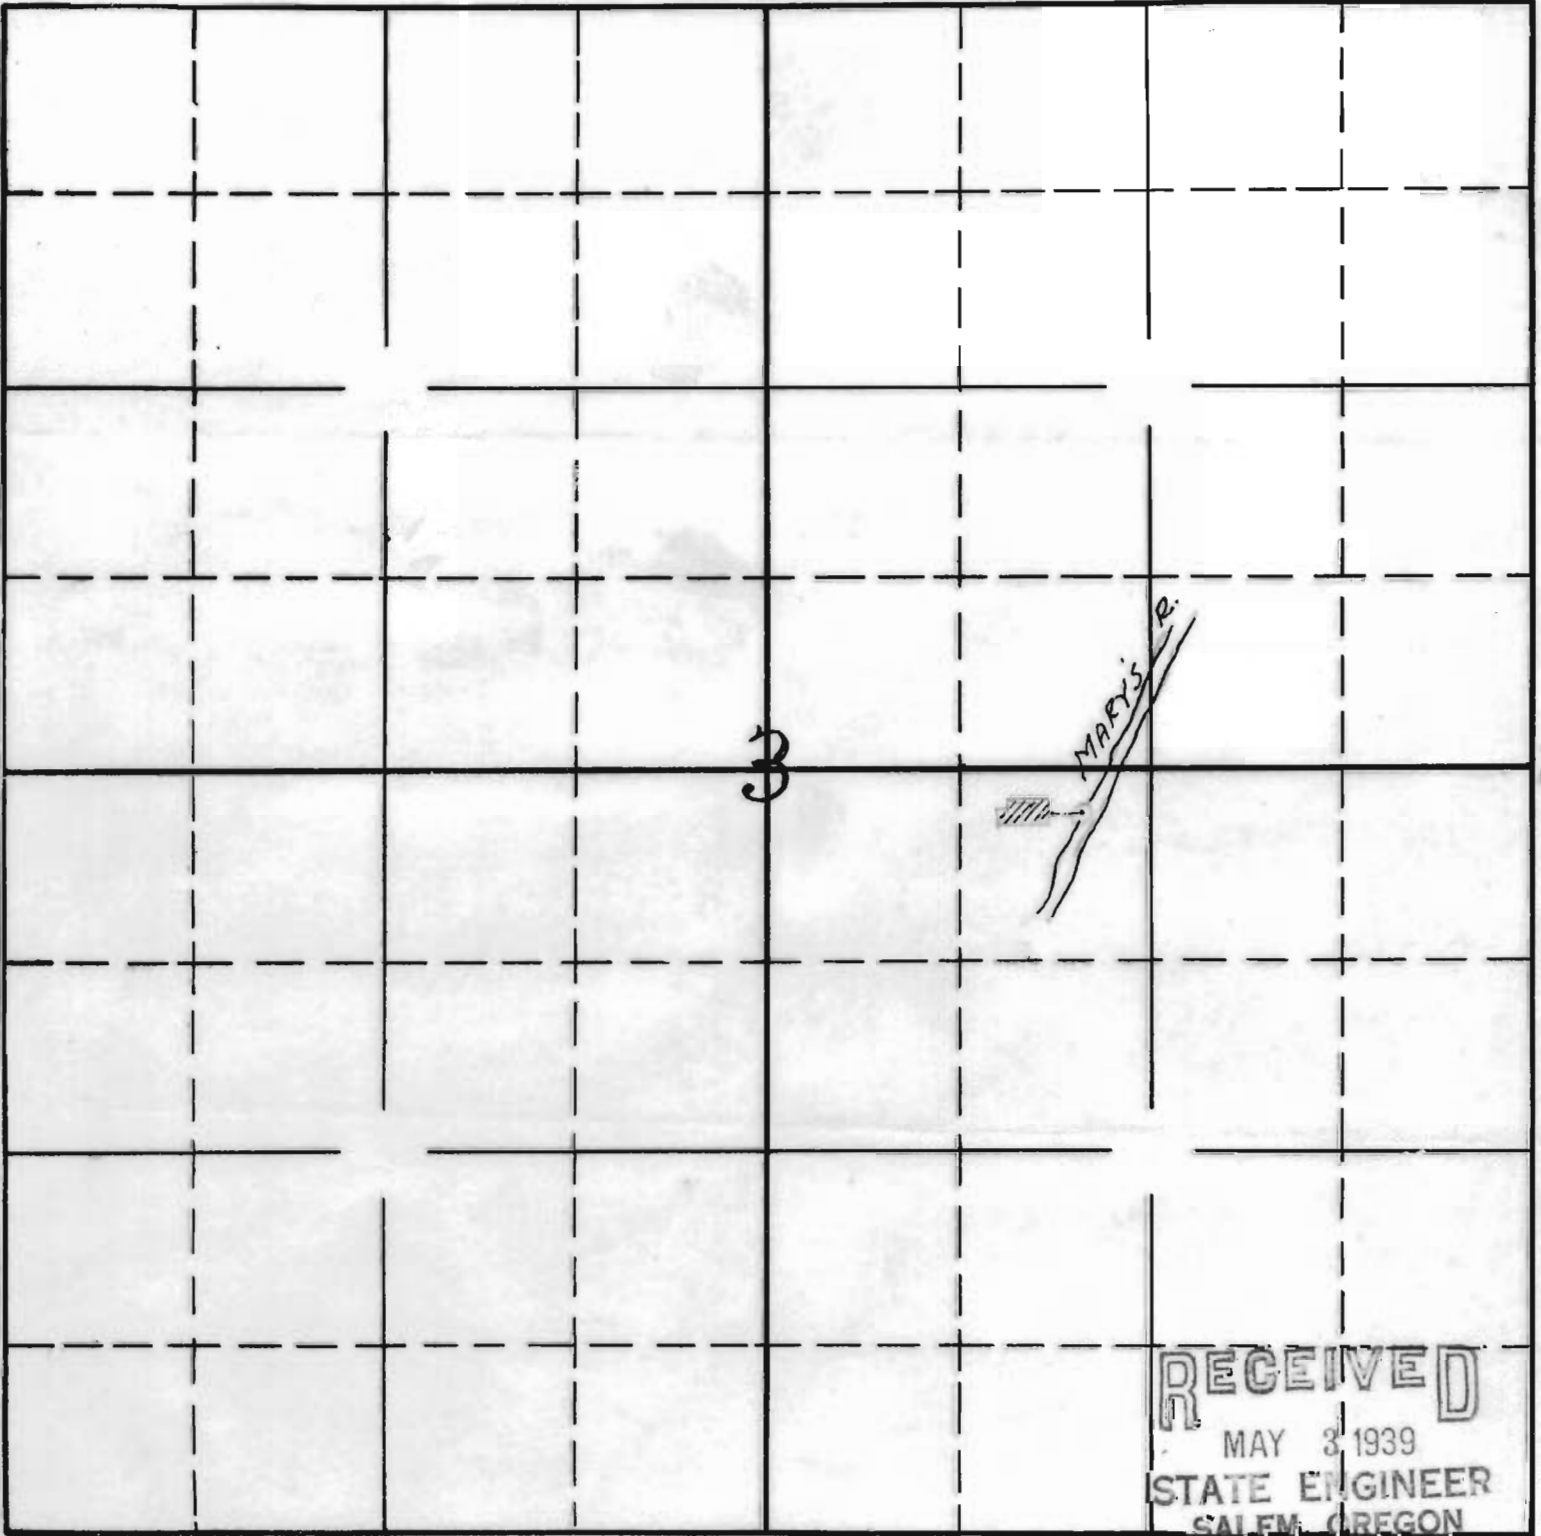

RECEIVED
 MAY 3 1939
 STATE ENGINEER
 SALEM, OREGON

17910 OK
 2-19

APPLICATION No. 17910
 PERMIT No. 13596


South
 Sketched in office of
 State Eng. from map
 by applicant 4-20-'39.

Scale
 1 in. = 660 ft.

SECTION

TOWNSHIP 125., RANGE 5W., W. M.

North

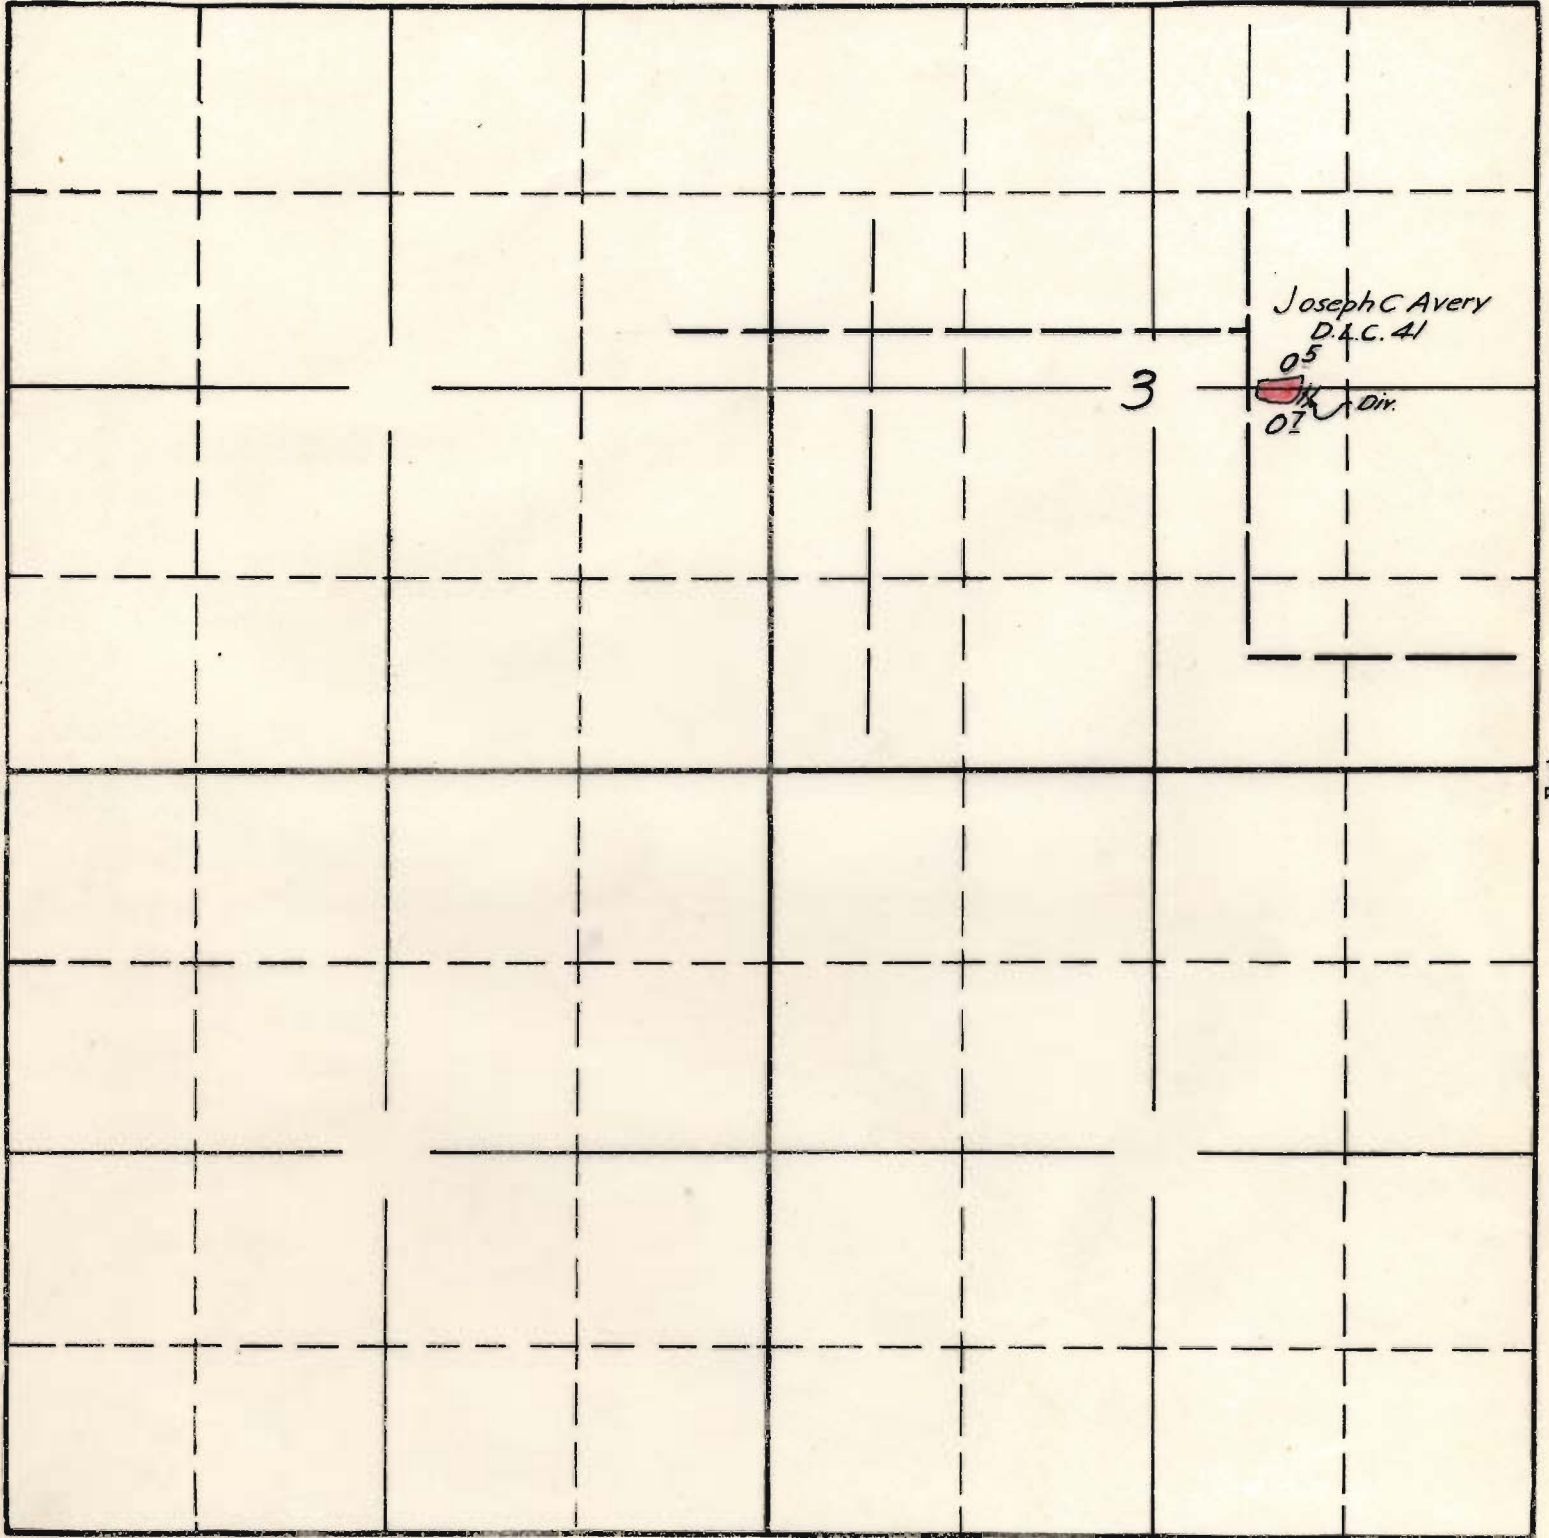

Joseph C Avery
D.C. 41
05
07 Dir.

3

West

East

Surveyed July 29, 1940 C.A.C.

South

APPLICATION No. 17910
PERMIT No. 13596