


SECTION

TOWNSHIP 1 S , RANGE 4 W , W. M.

3 W

North

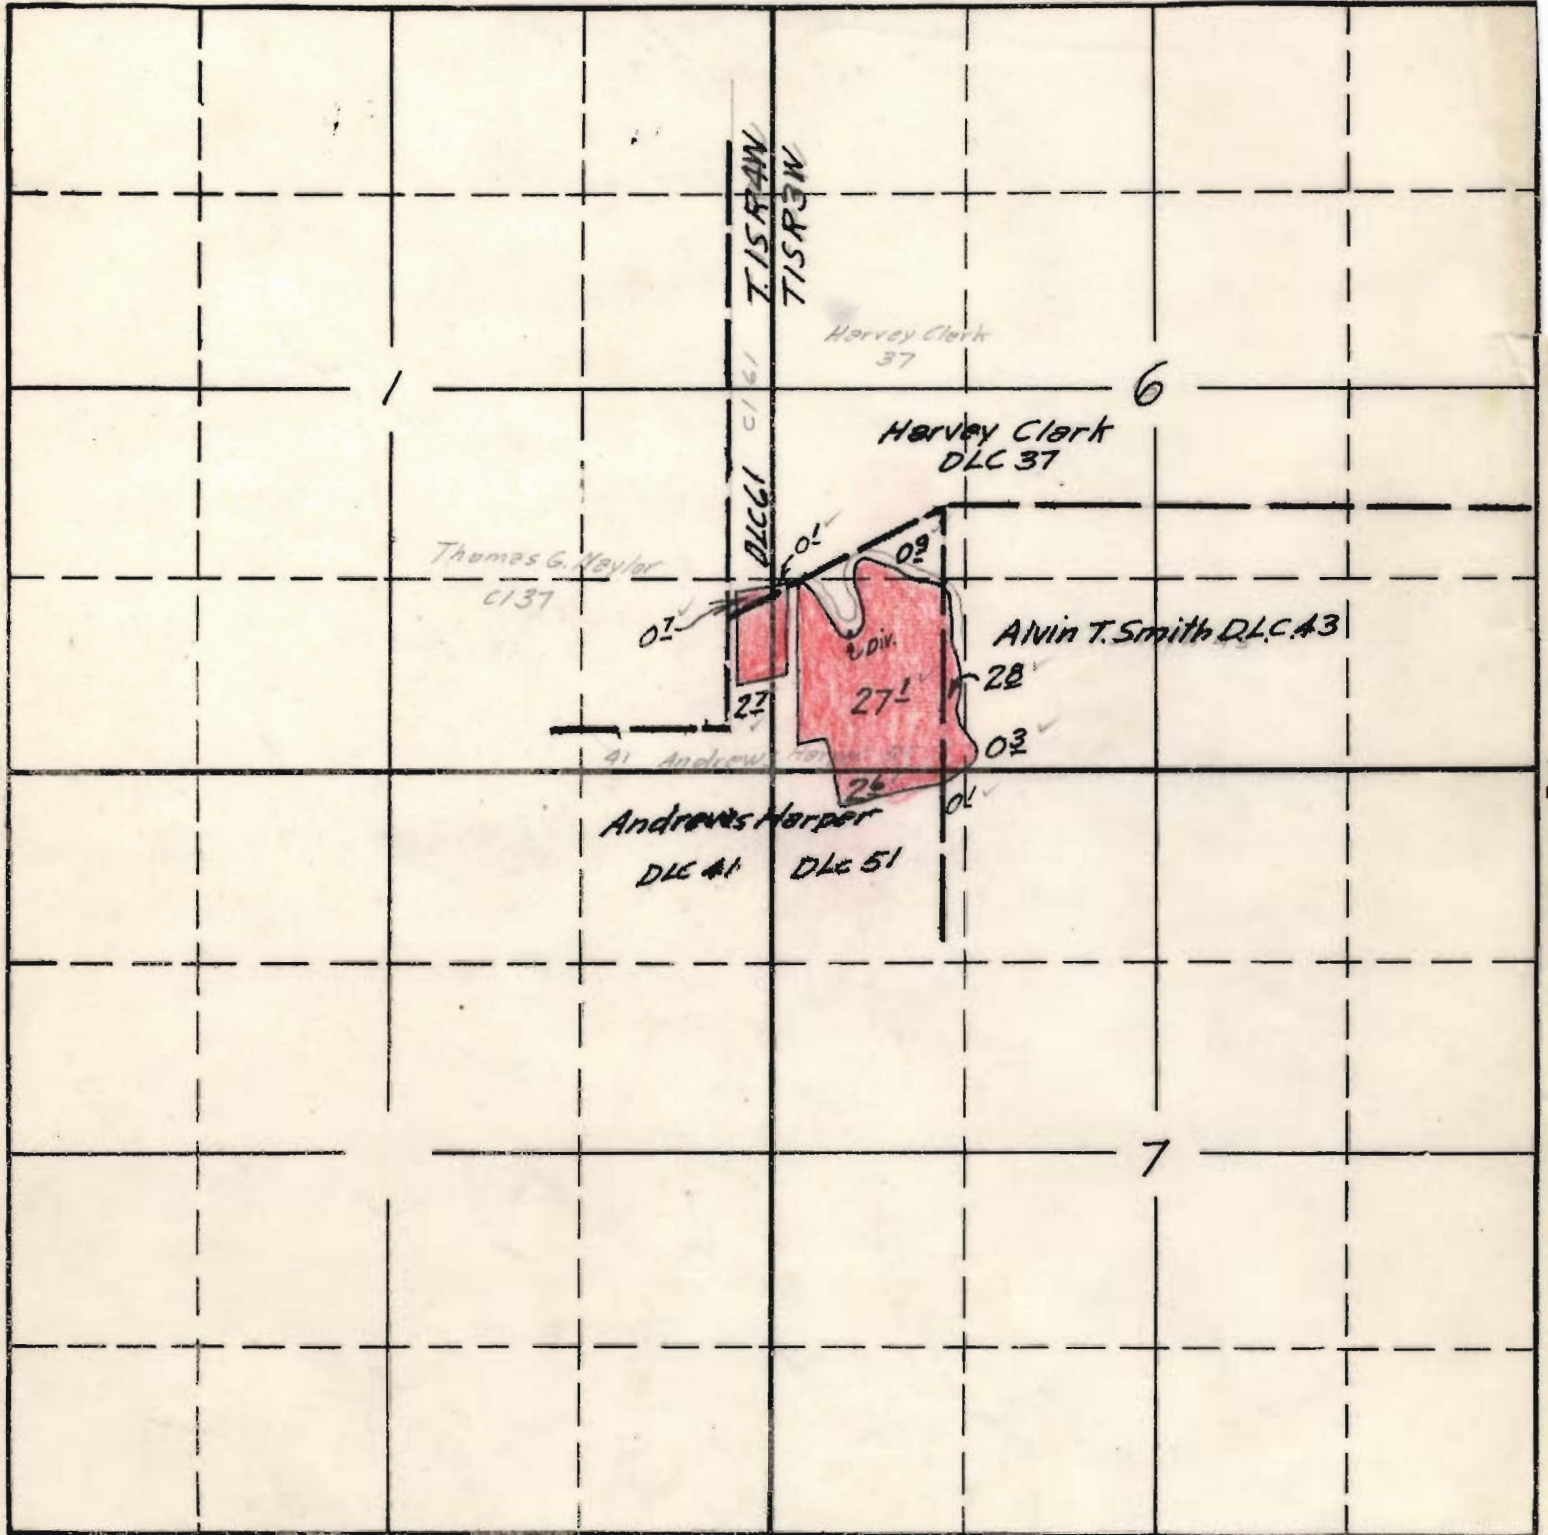

Surveyed June 11, 1940 B.A.B.


South

APPLICATION No. 17971  
PERMIT No. 13646

SECTION

TOWNSHIP 15, RANGE 3W, W. M.

North

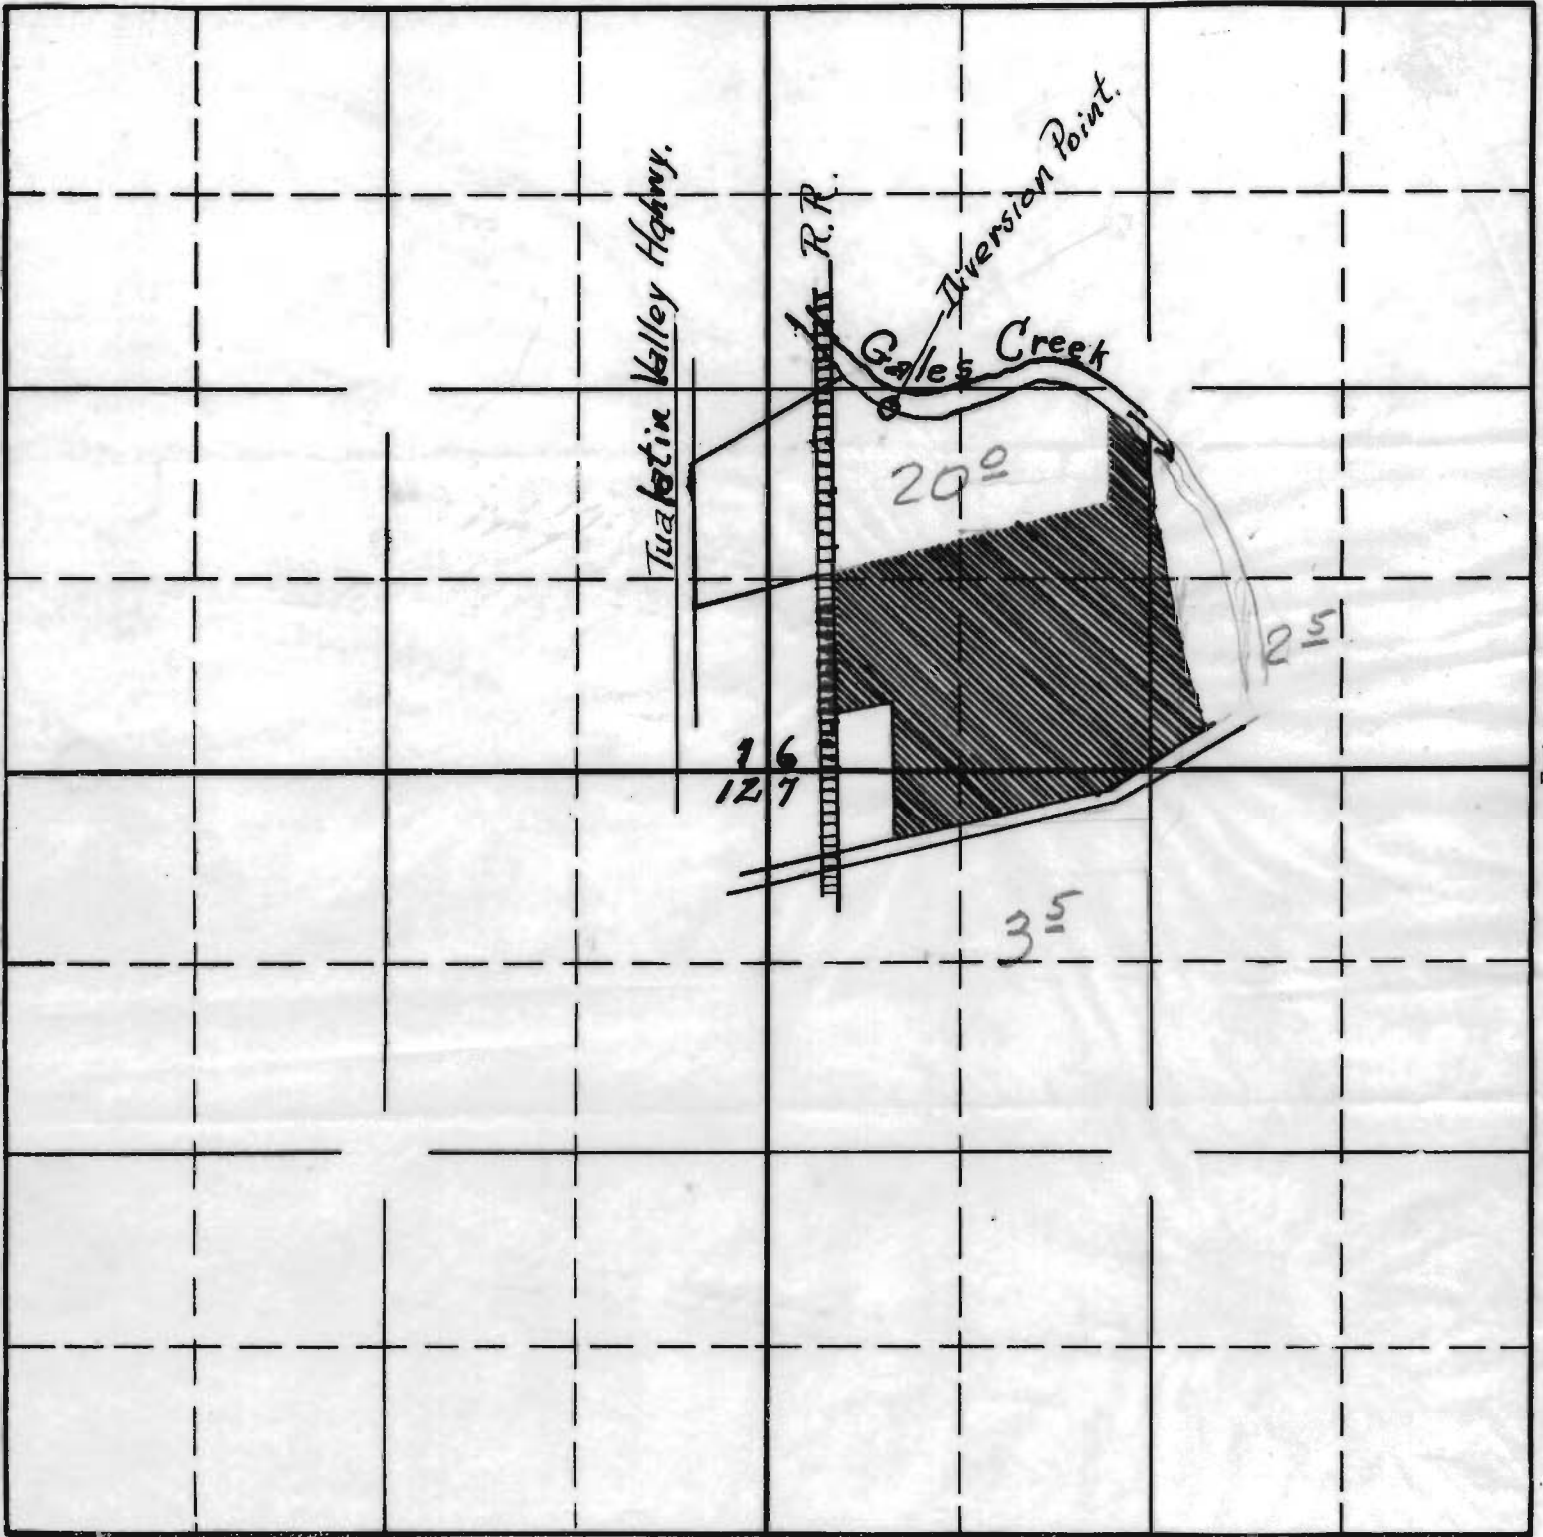

Scale - 1 inch = 660 feet South

17971 DC  
2-62E

APPLICATION No. 17971  
PERMIT No. 13646