


SECTION

4

335
TOWNSHIP 34S, RANGE 2W, W. M.

North

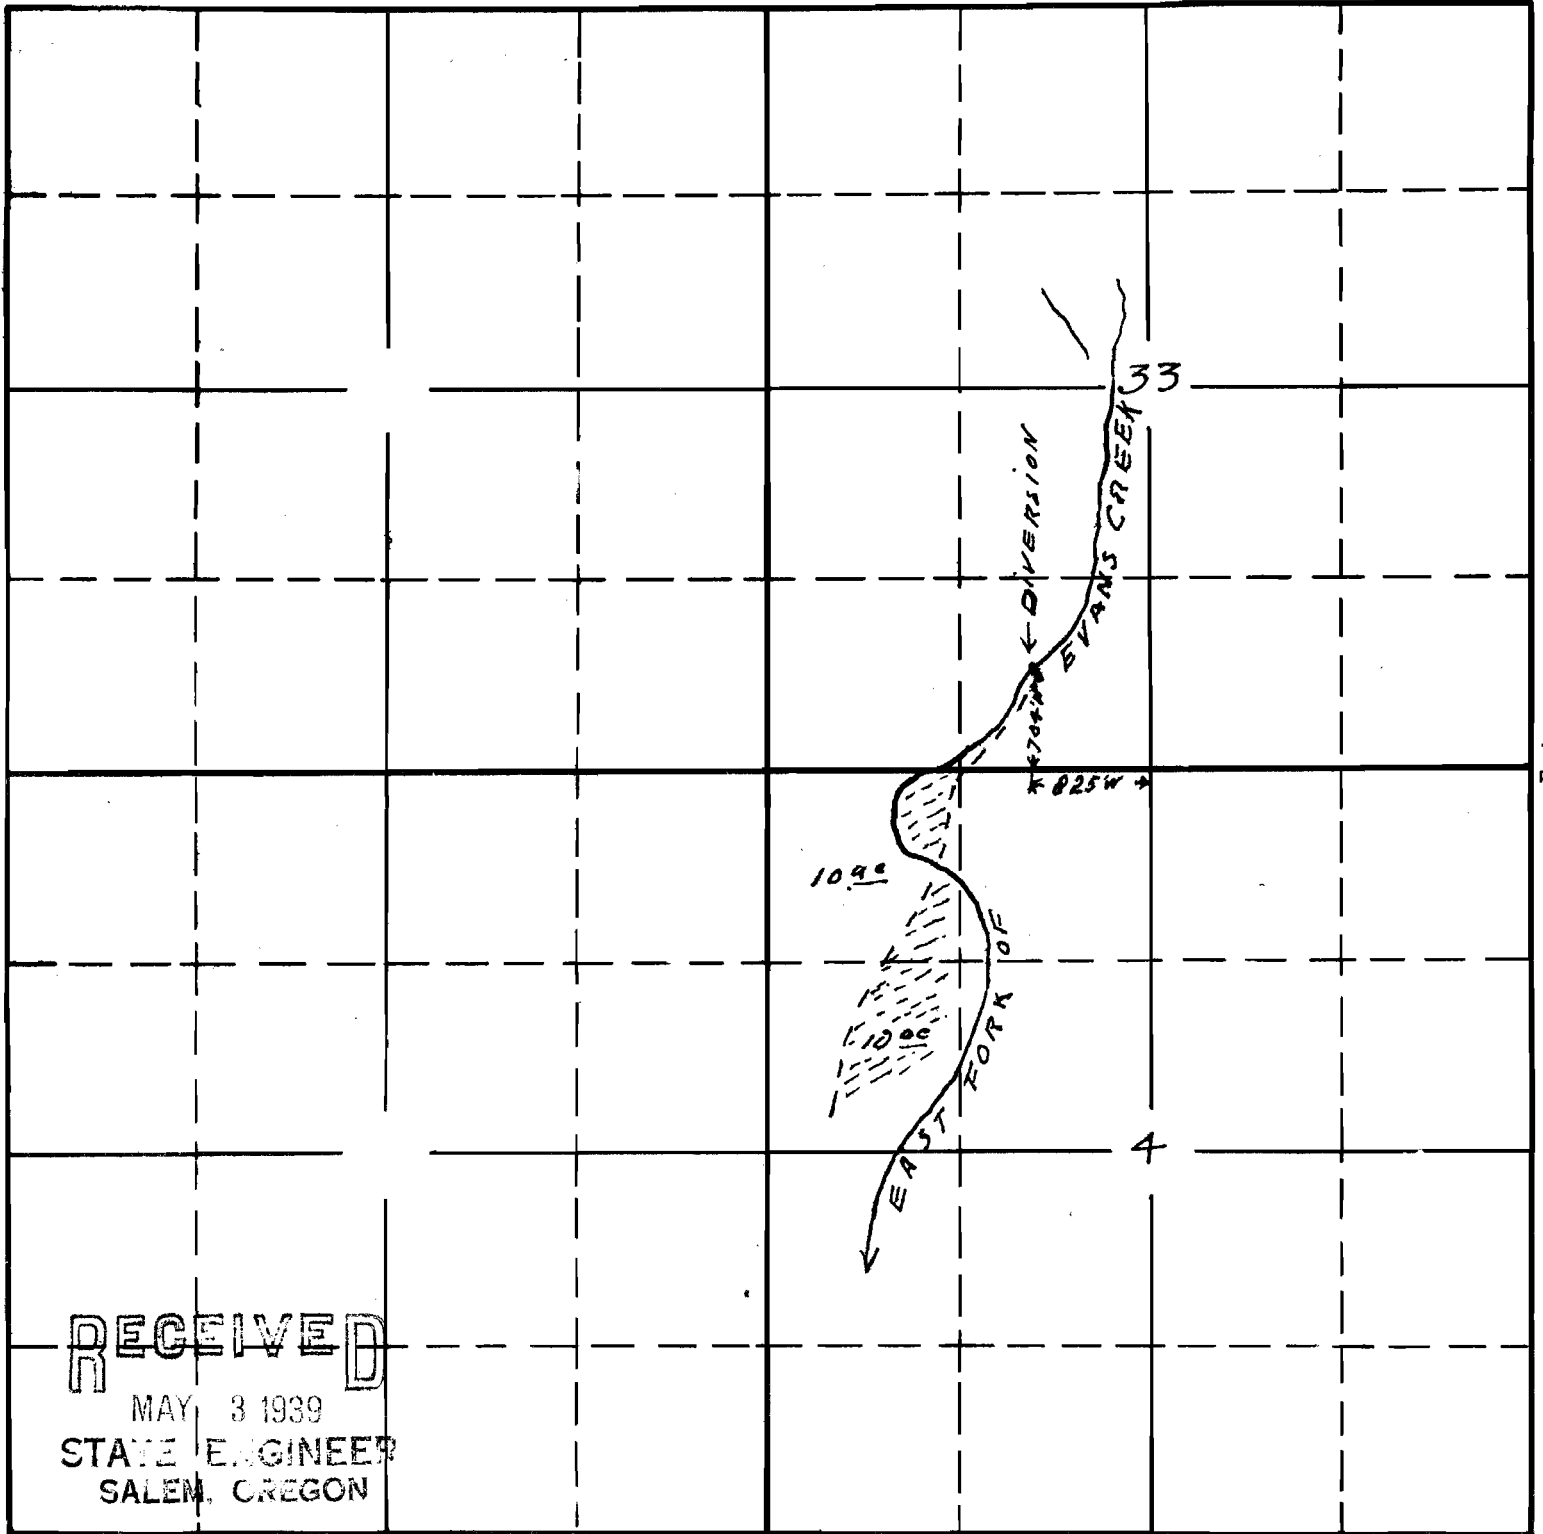

RECEIVED

MAY 3 1939
STATE ENGINEER
SALEM, OREGON

South

Map to accompany application of
A H Buckland for the use of waters
of E. Fk. of Evans creek for irrigation
purposes

17976 of
15-40

APPLICATION No. 17976
PERMIT No. 13651

This office 4/29/39 held for descriptions *[Signature]*