


TOWNSHIPS 4 & 5 S., RANGE 10 W. W. M.
TILLAMOOK COUNTY ORE.

SCALE 4 IN = 1 MILE

APPLICATION NO. _____

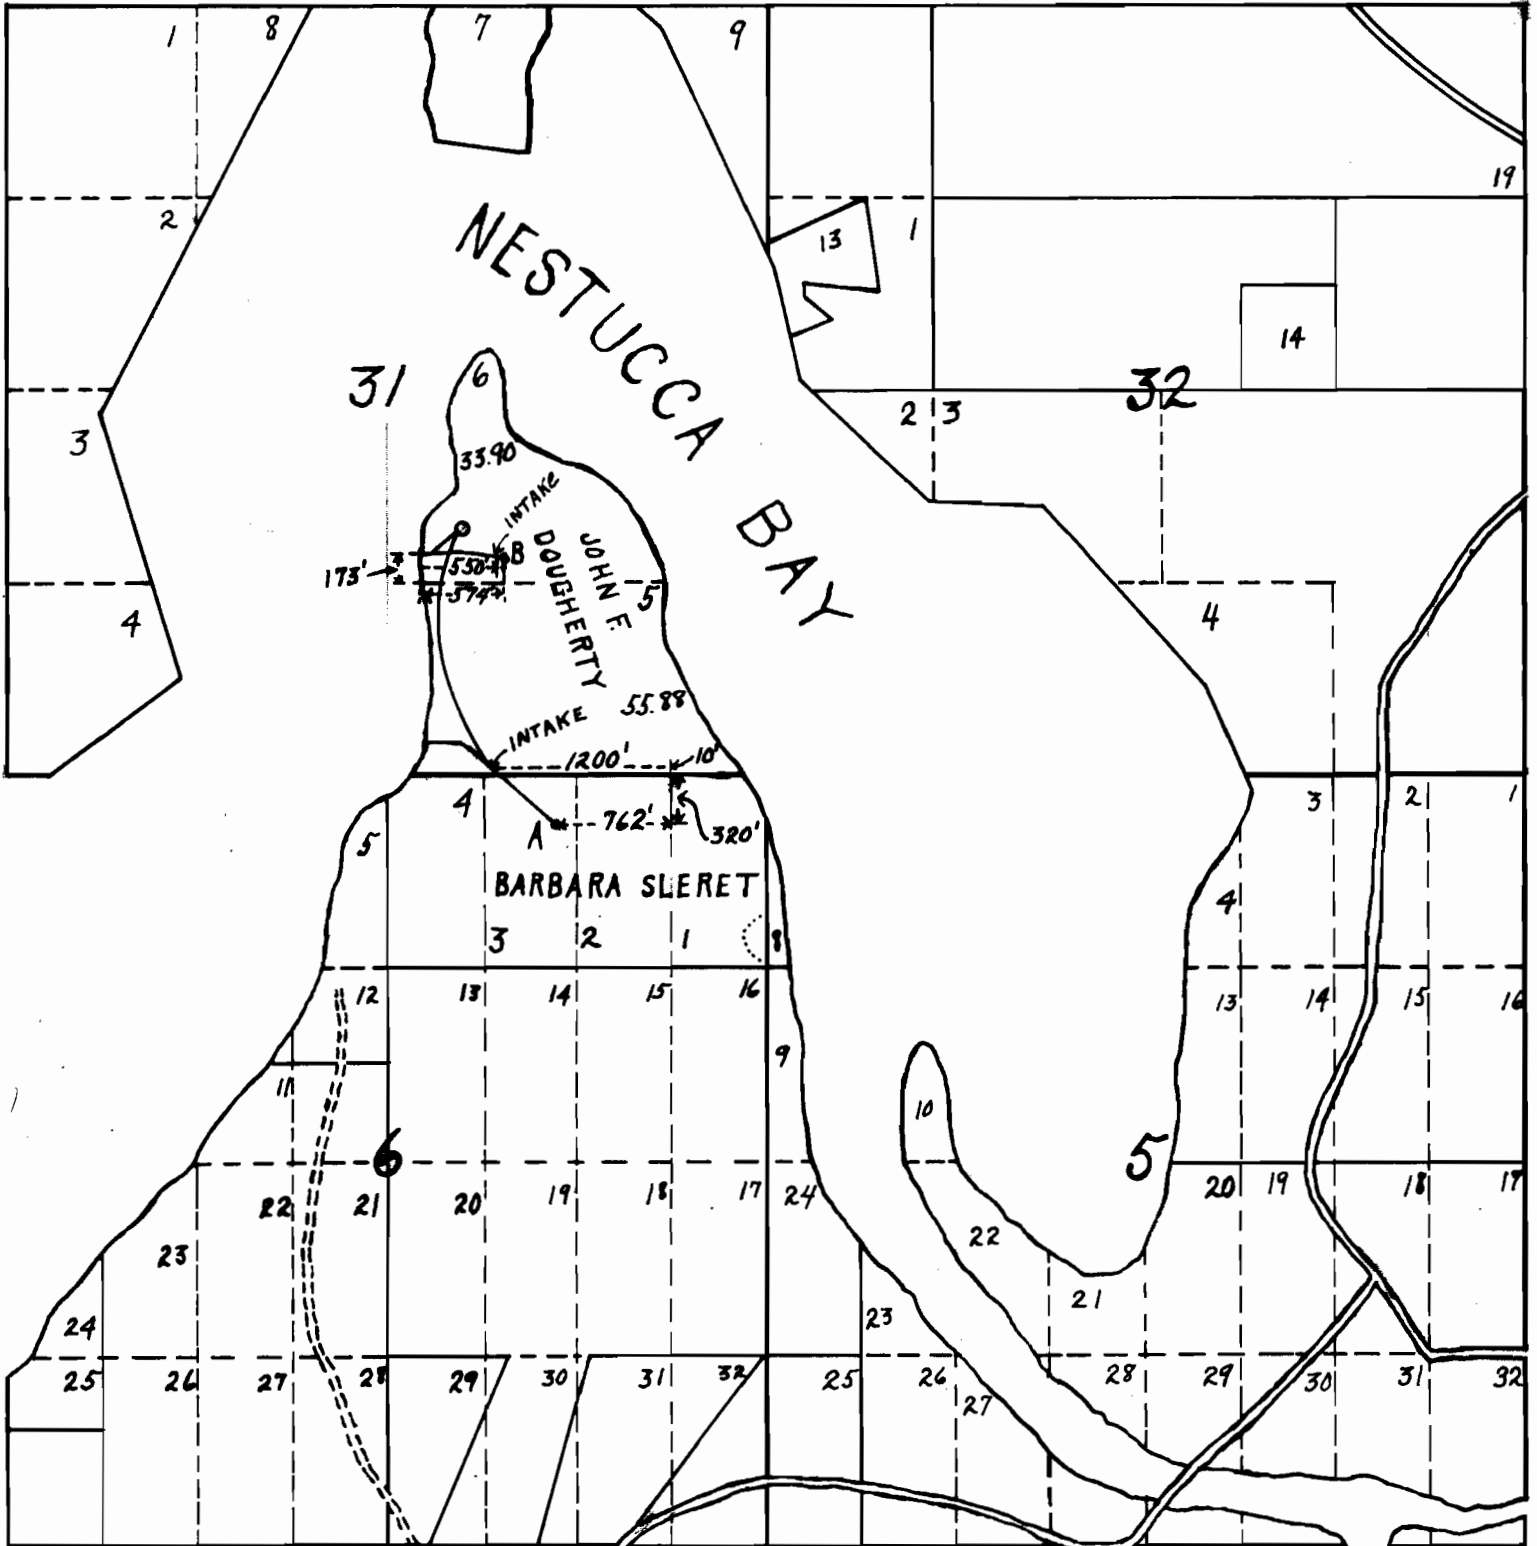

App # 17900 OK

JOHN F. DOUGHERTY Per No. 13700