


T. 6 N R. 5 W W. M.

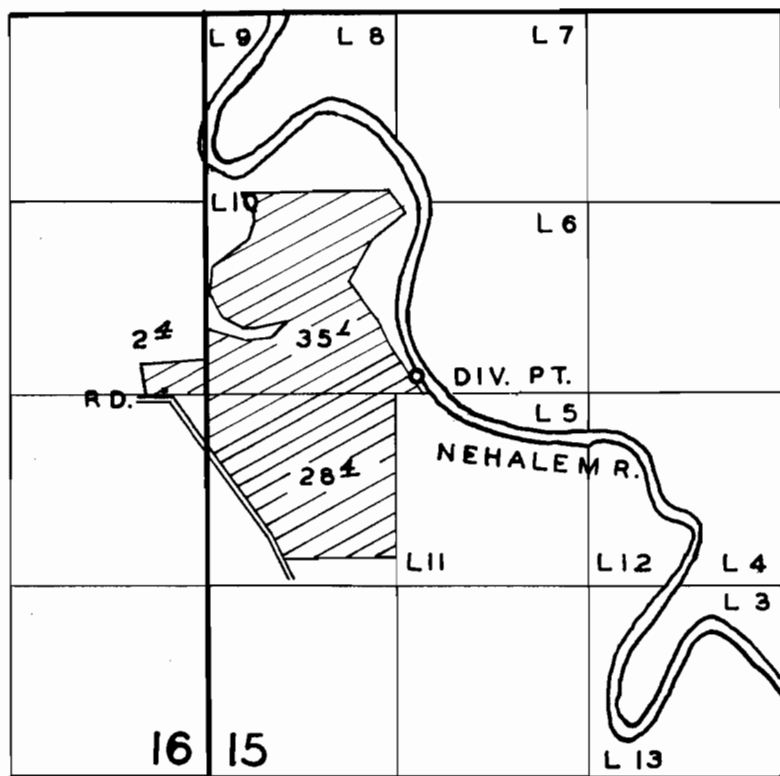

FINAL PROOF SURVEY

UNDER

Application No. 18031 .. Permit No. 3703..

IN NAME OF

W. C. JOHNSON

Surveyed SEPT. 6 1956 by R. H. WHITBY

1956V
R.H.