

SECTION


\_\_\_\_\_

\_\_\_\_\_

\_\_\_\_\_

TOWNSHIP 3/5, RANGE 15 W, W. M.

North

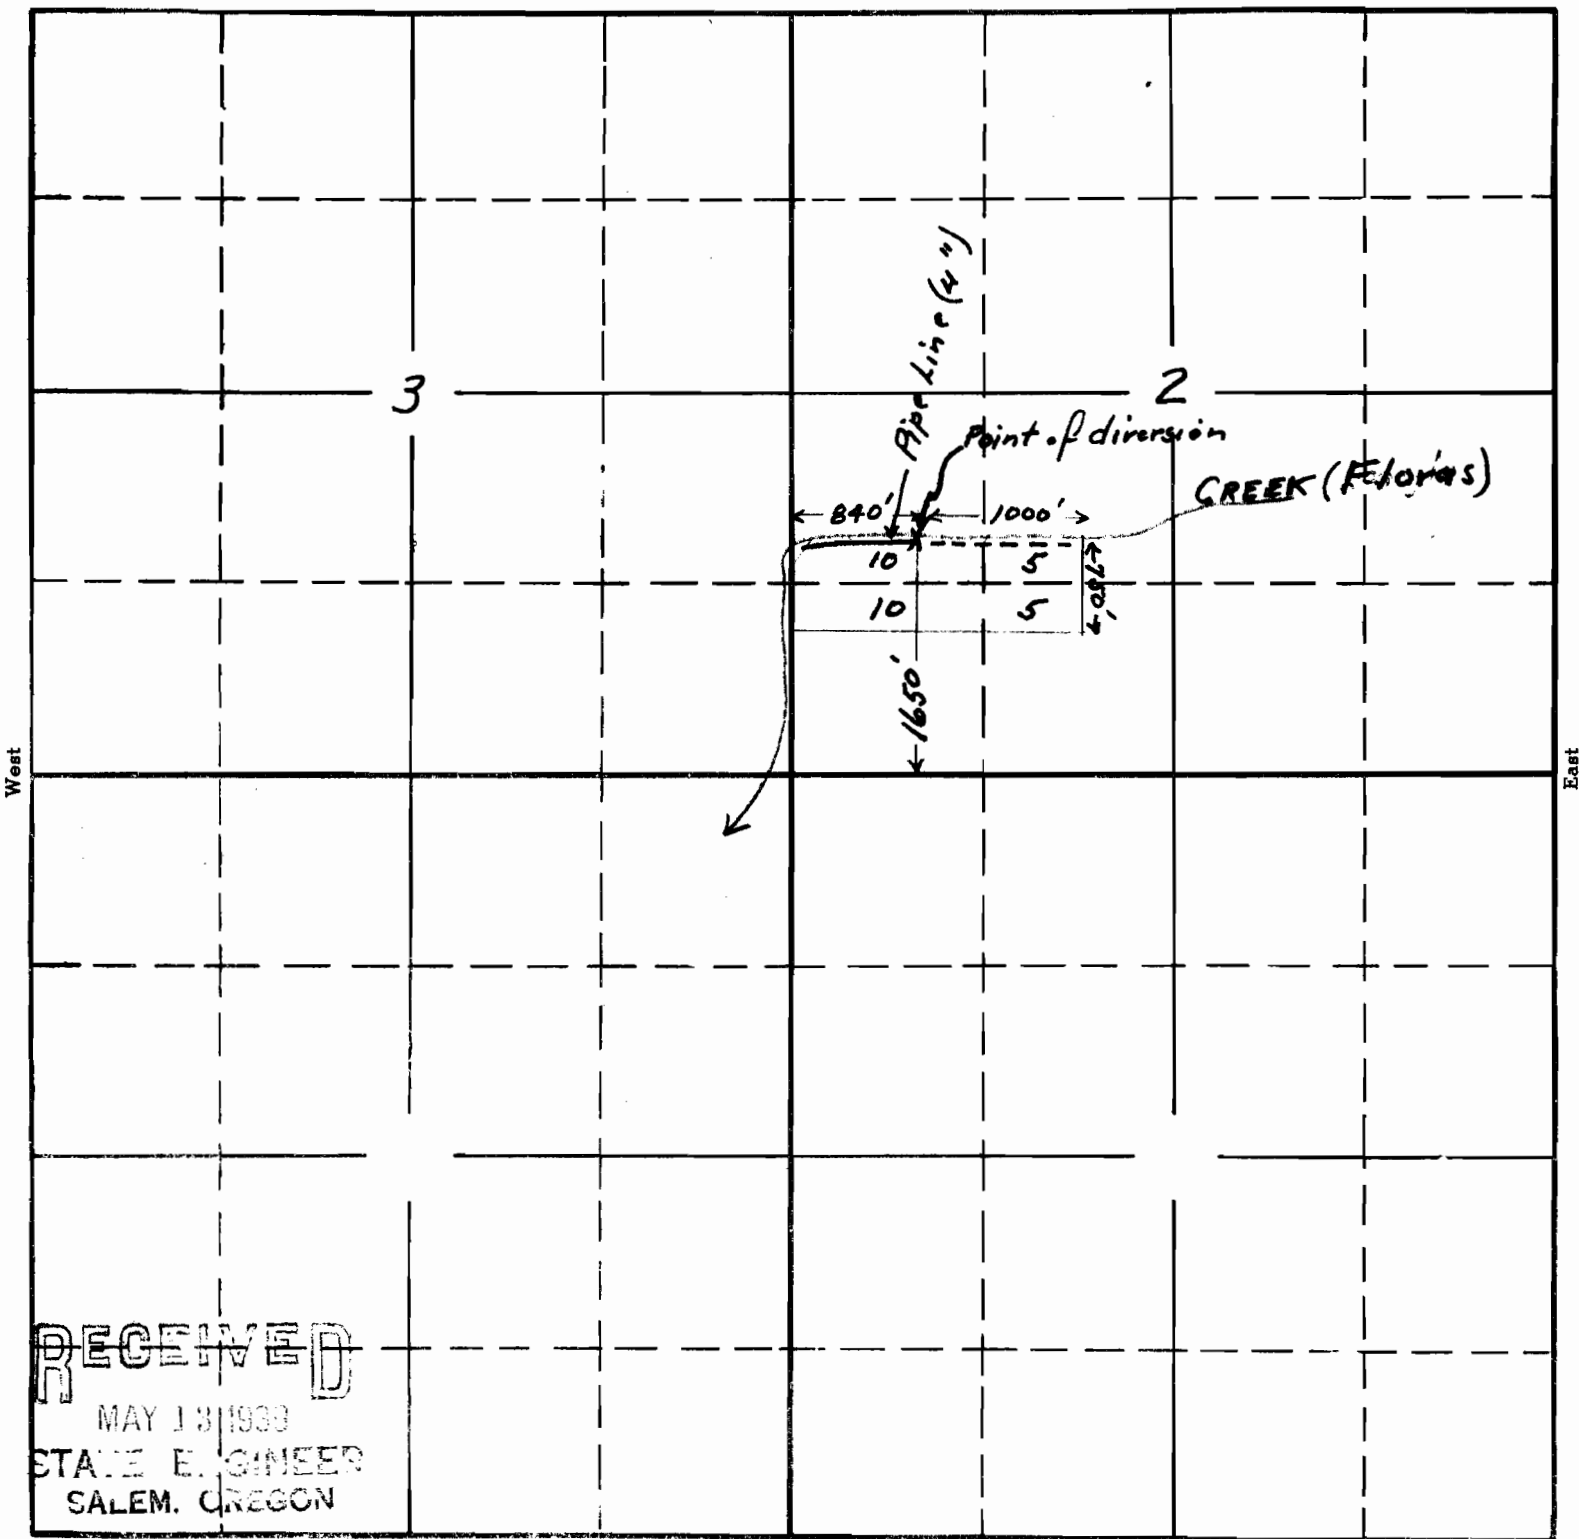

**RECEIVED**  
 MAY 13 1933  
 STATE ENGINEER  
 SALEM, OREGON


South

*Filed in the name of P.G. Cope  
 R.E. Cope & Son  
 Langlois - Curry Co*

18238  
 17-3  
 APPLICATION No.  
 PERMIT No. **13708**

TOWNSHIP 3/5 , RANGE 15W, W. M.

North

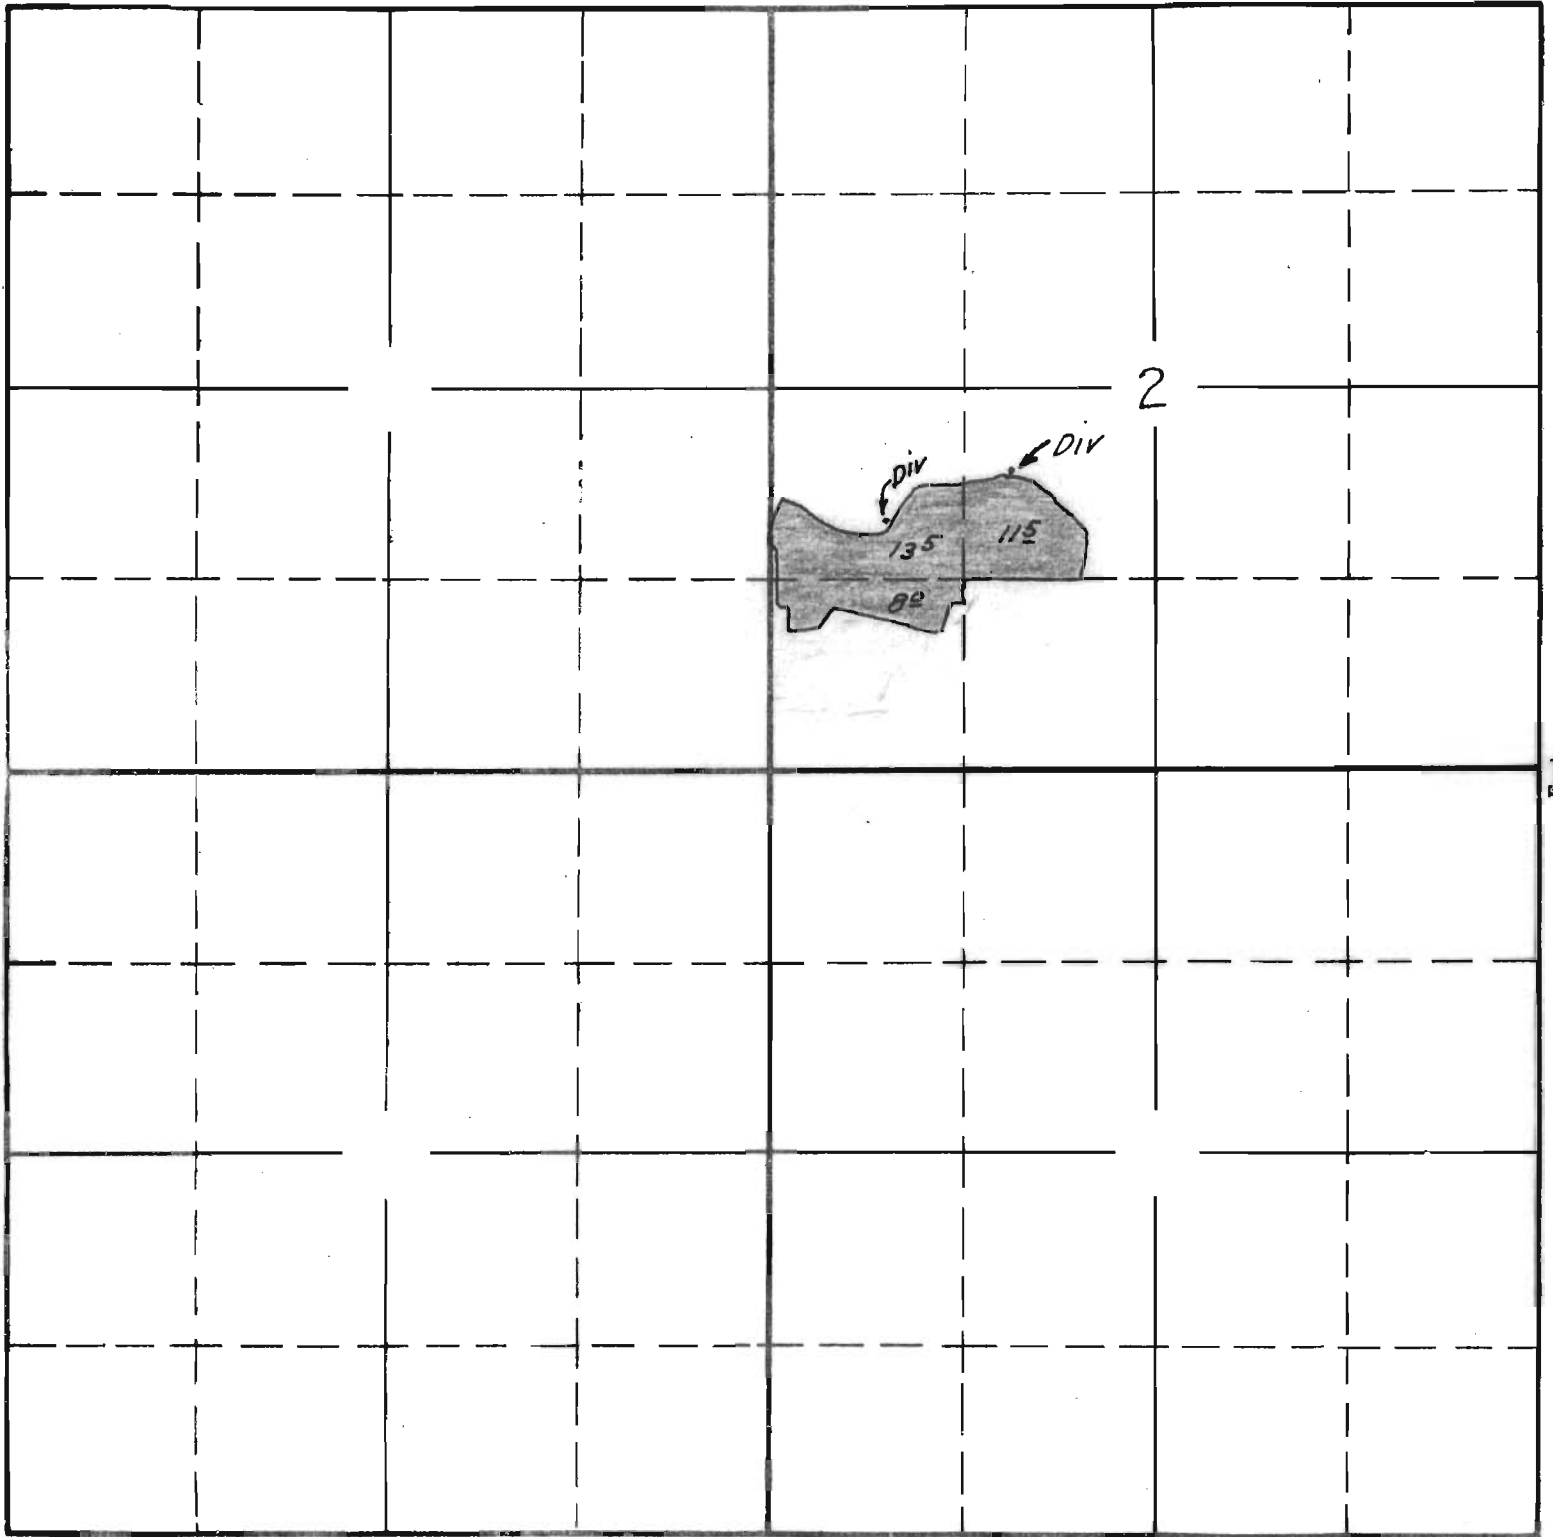

Surveyed July 5, 1940 C.A.C.

South

APPLICATION No. 18038

PERMIT No. 13708