


25

TOWNSHIP 36 S, RANGE 3 W, W. M.

North

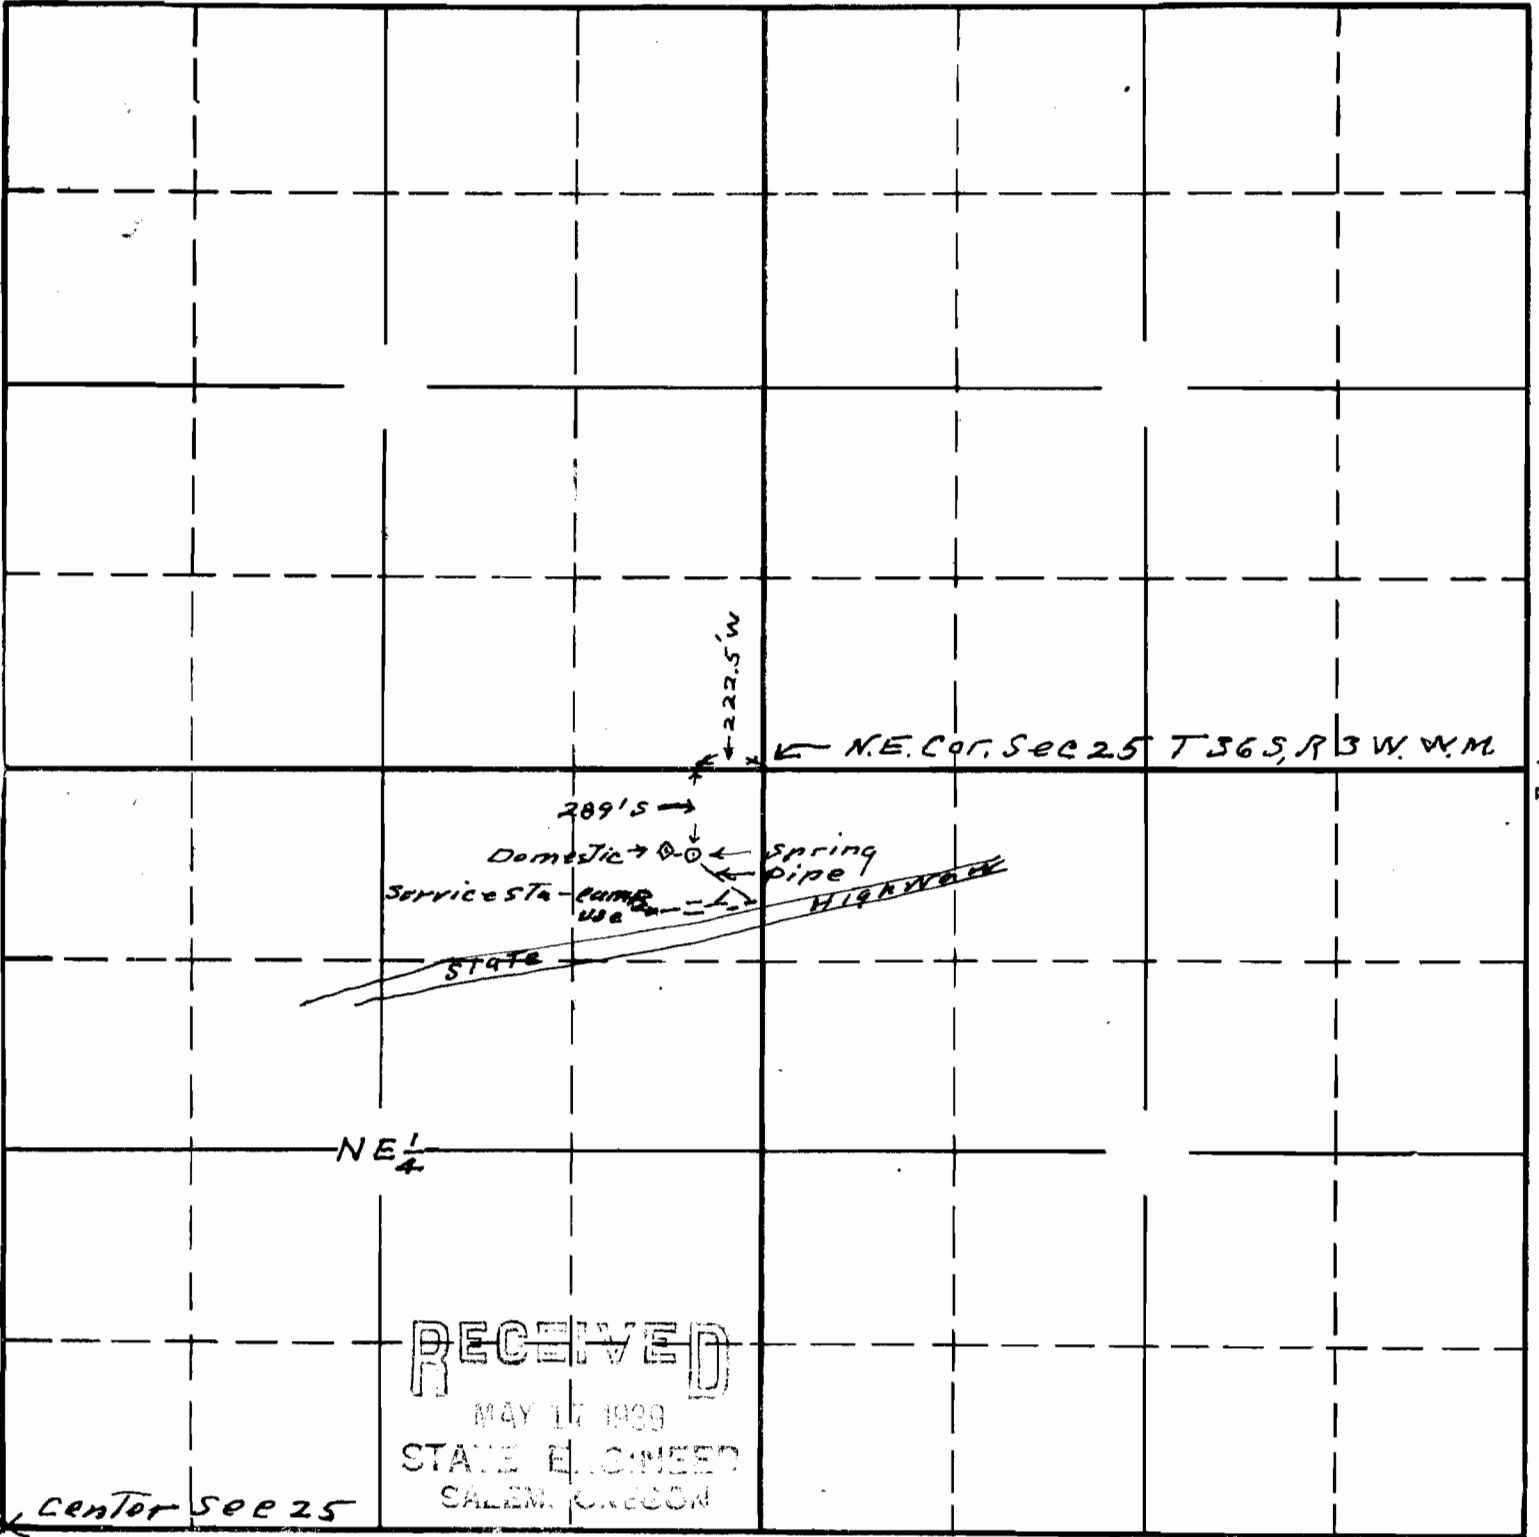

RECEIVED
 MAY 17 1939
 STATE ENGINEER
 SALEM, OREGON

Map to accompany application of
 Chester A Ginks and wife for use
 of unnamed spring on their property
 for domestic and camp cottage use

18074 DC
 15-16
 APPLICATION No. 18074
 PERMIT No. 13740

This office 5/13/39 *[Signature]*