


SECTION

TOWNSHIP 65 , RANGE 7W , W. M.

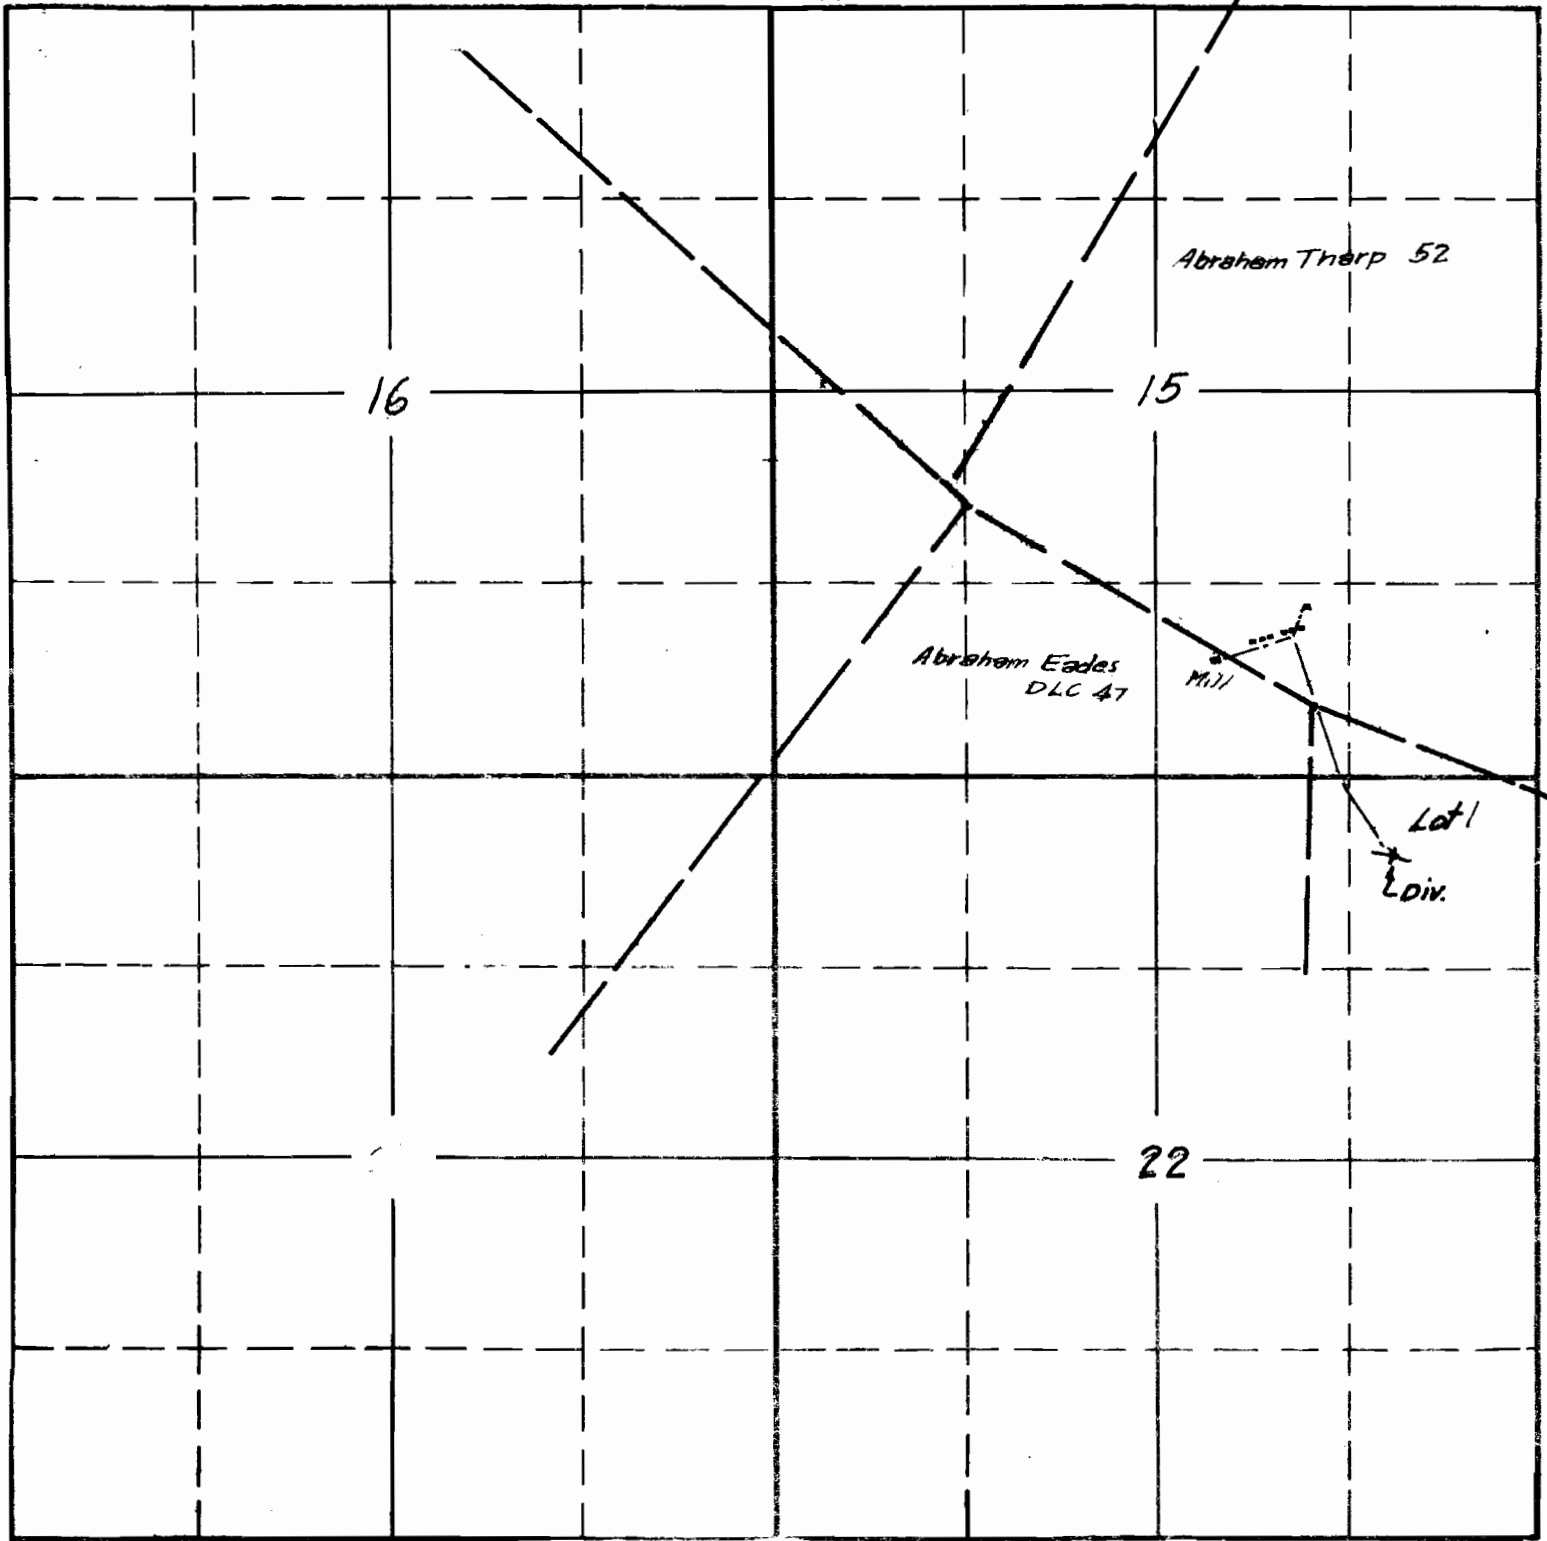


APPLICATION No. 18093  
PERMIT No. 13753

SECTION

15  
22

TOWNSHIP 65, RANGE 7W, W. M.

North

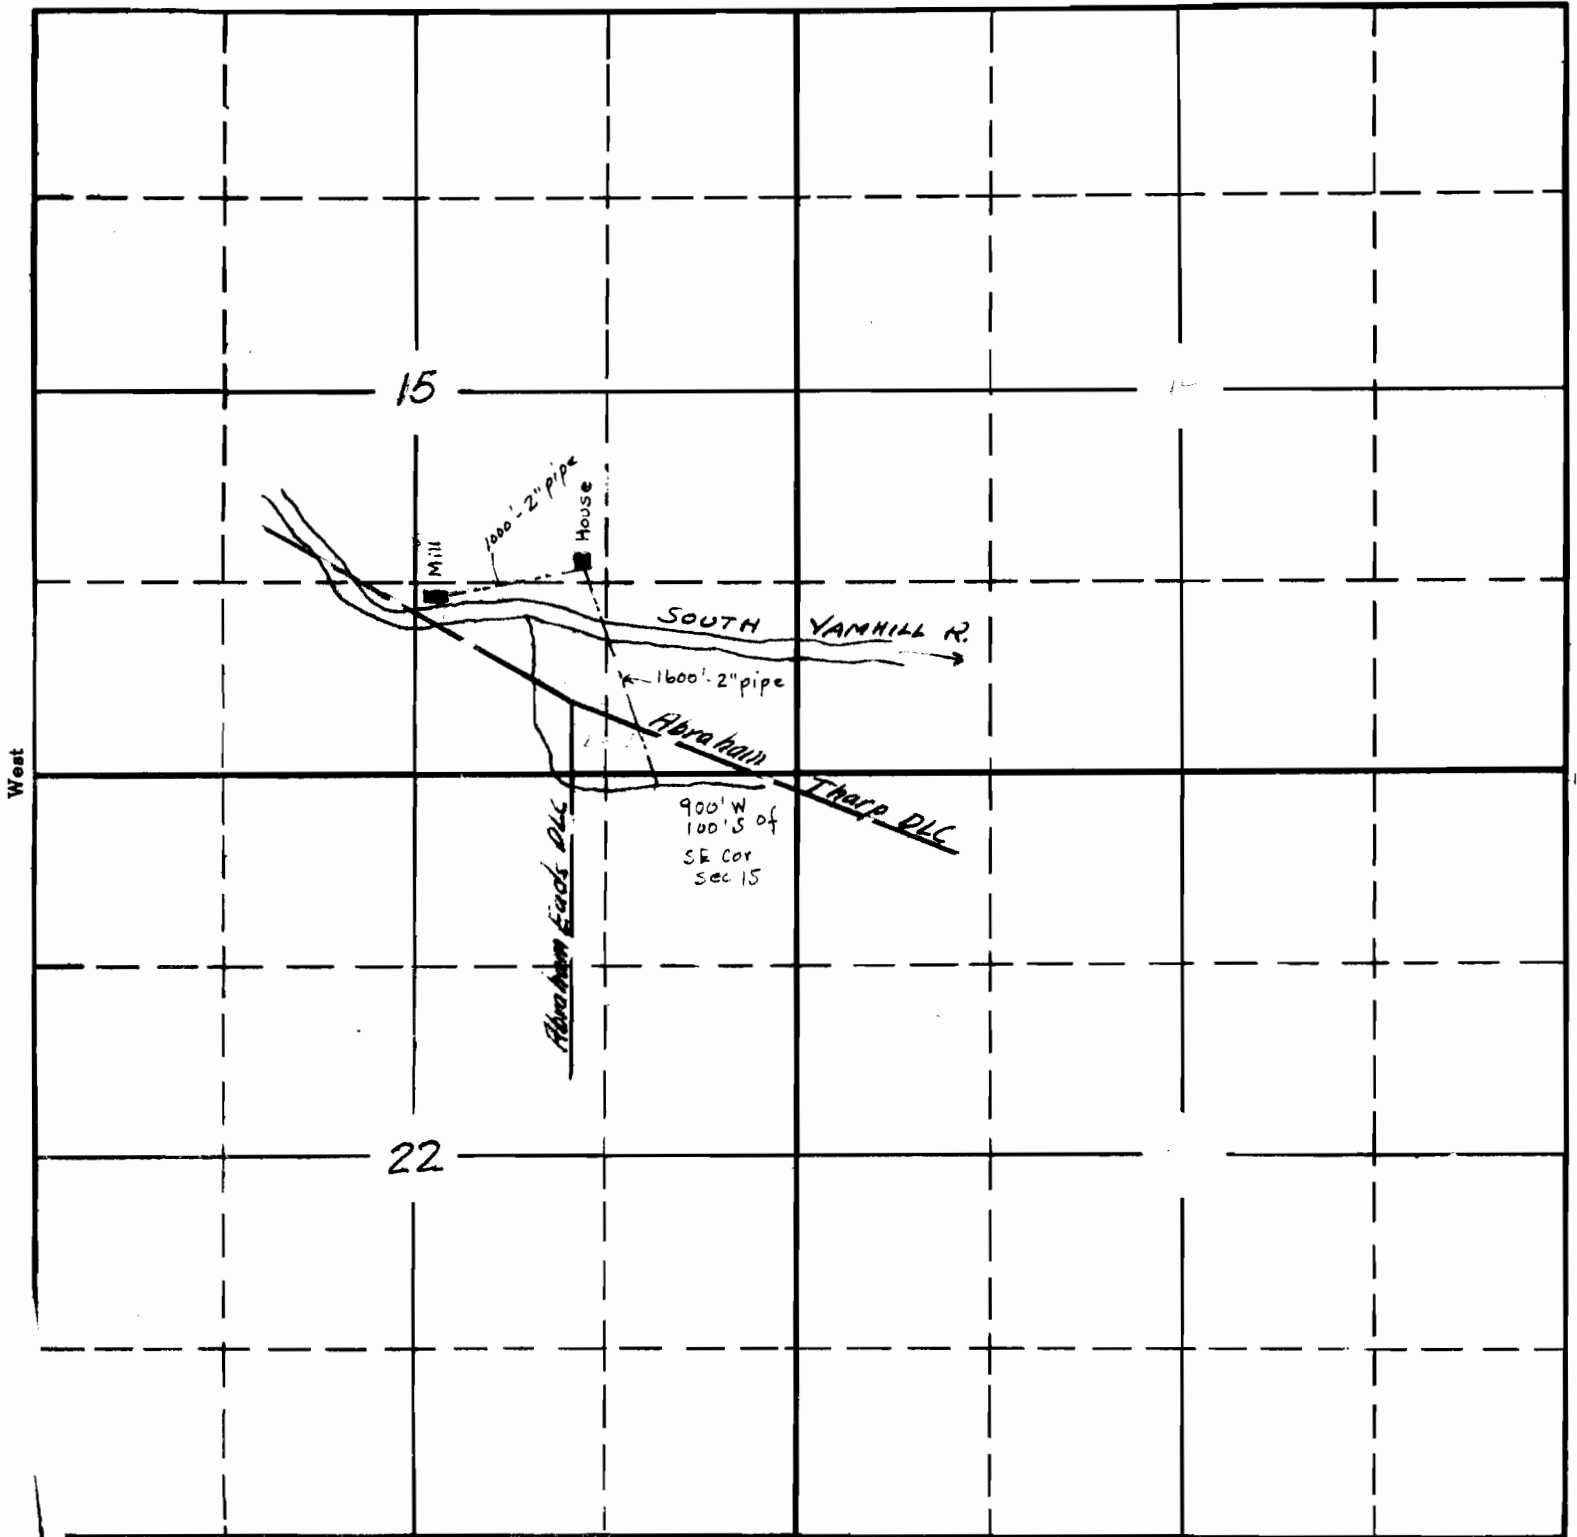

APPLICATION No. 18093  
PERMIT No. 13753

sketched in office of State Engr. from  
Metskers Map and information by applicant.

5-19-39