


SECTION

TOWNSHIP 36 S, RANGE 7 W

Permit: S 13761
Volume: 1
Strm: ROGUE R
Trib: PACIFIC OCEAN
Priority: 5/23/39

North

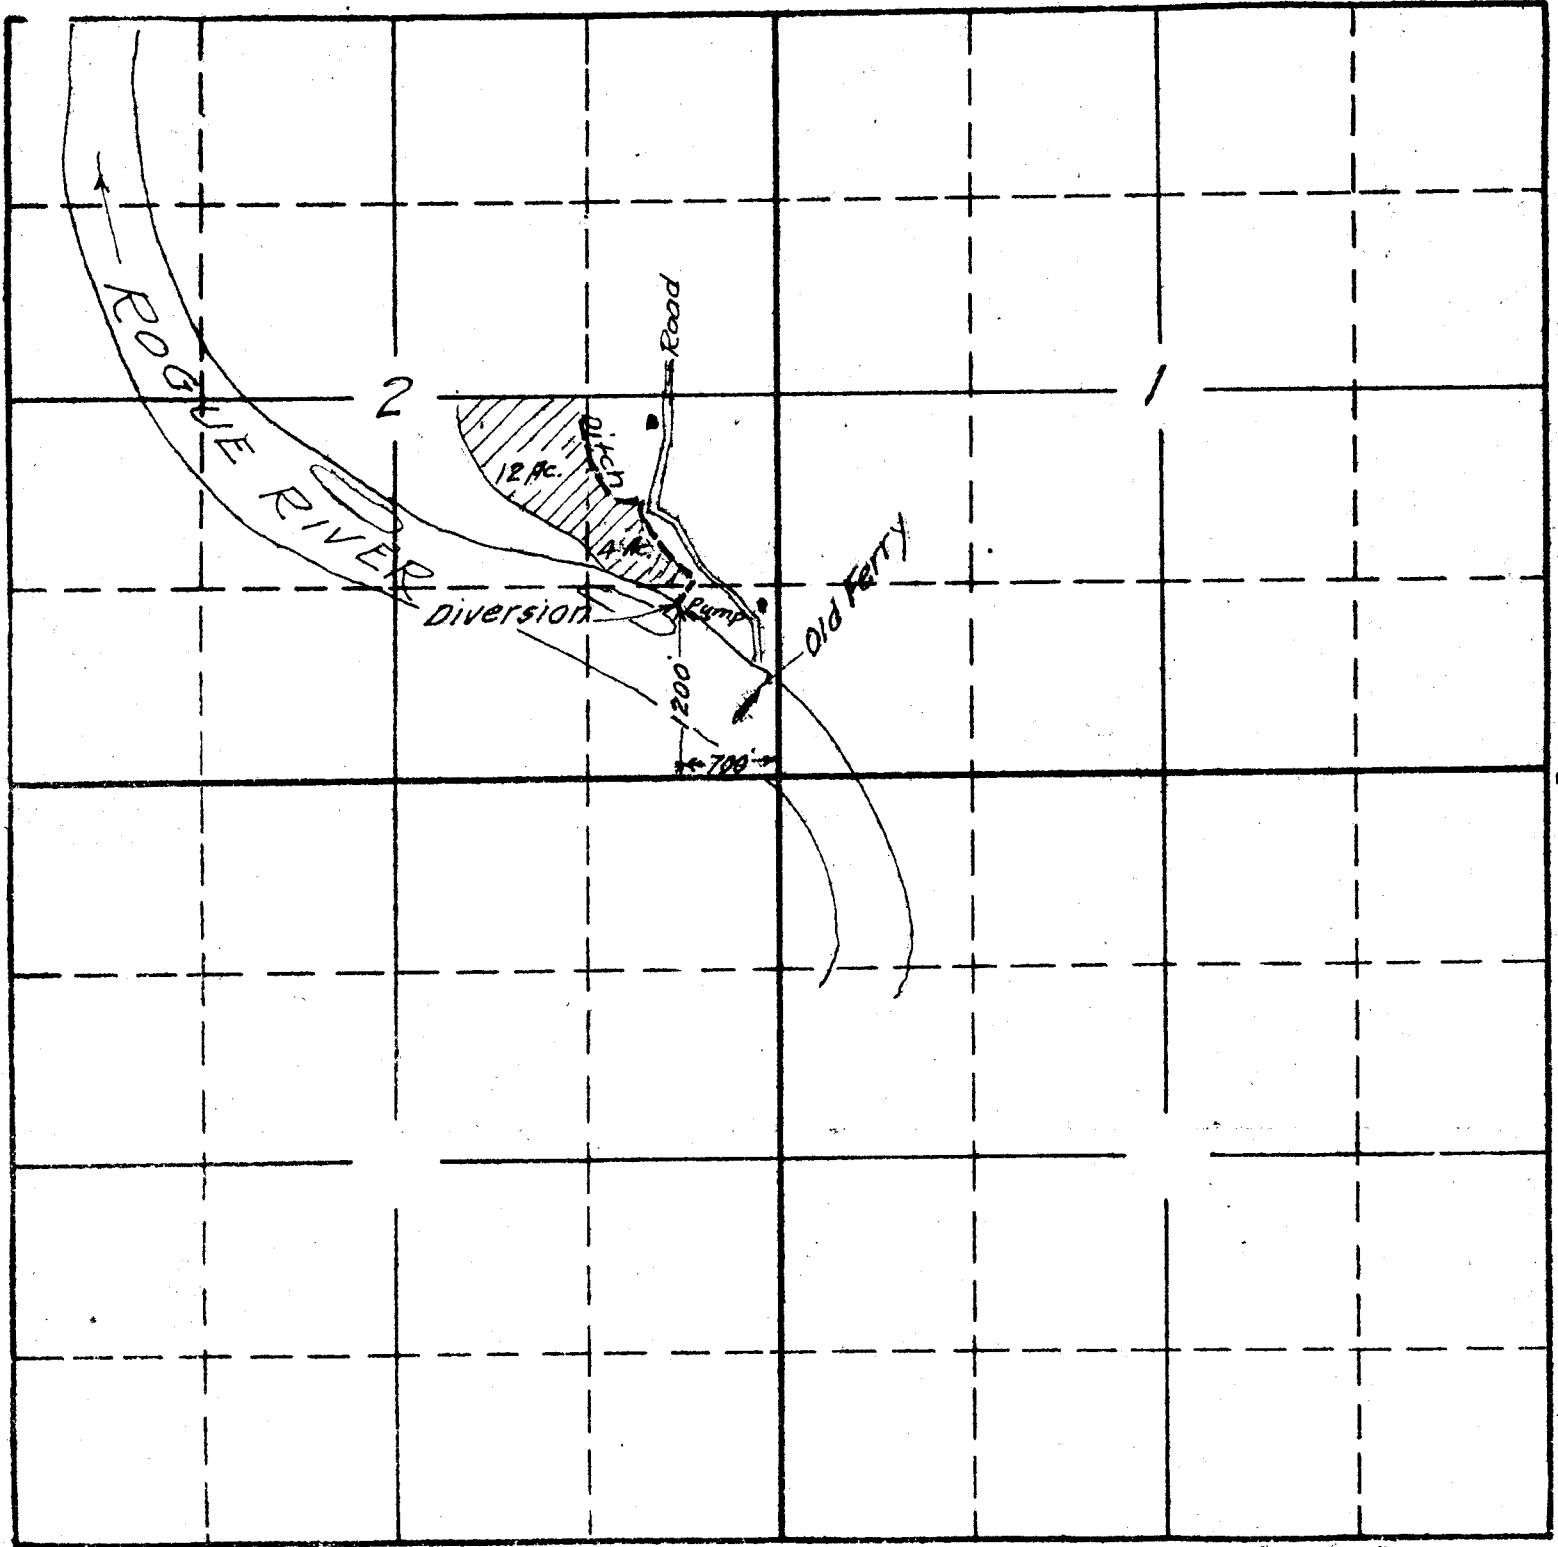

South

18106
3/30

Maud G Kerr
May 1939

APPLICATION No. 18106
PERMIT No. 13761