


# SNAKE RIVER DISTRICT IMPROVEMENT CO. (INC.)

MALHEUR COUNTY,  
OREGON.

OFFICE OF STATE ENGINEER  
RECEIVED  
NOV 25 1912

Application No. 2668  
Permit No. 1380

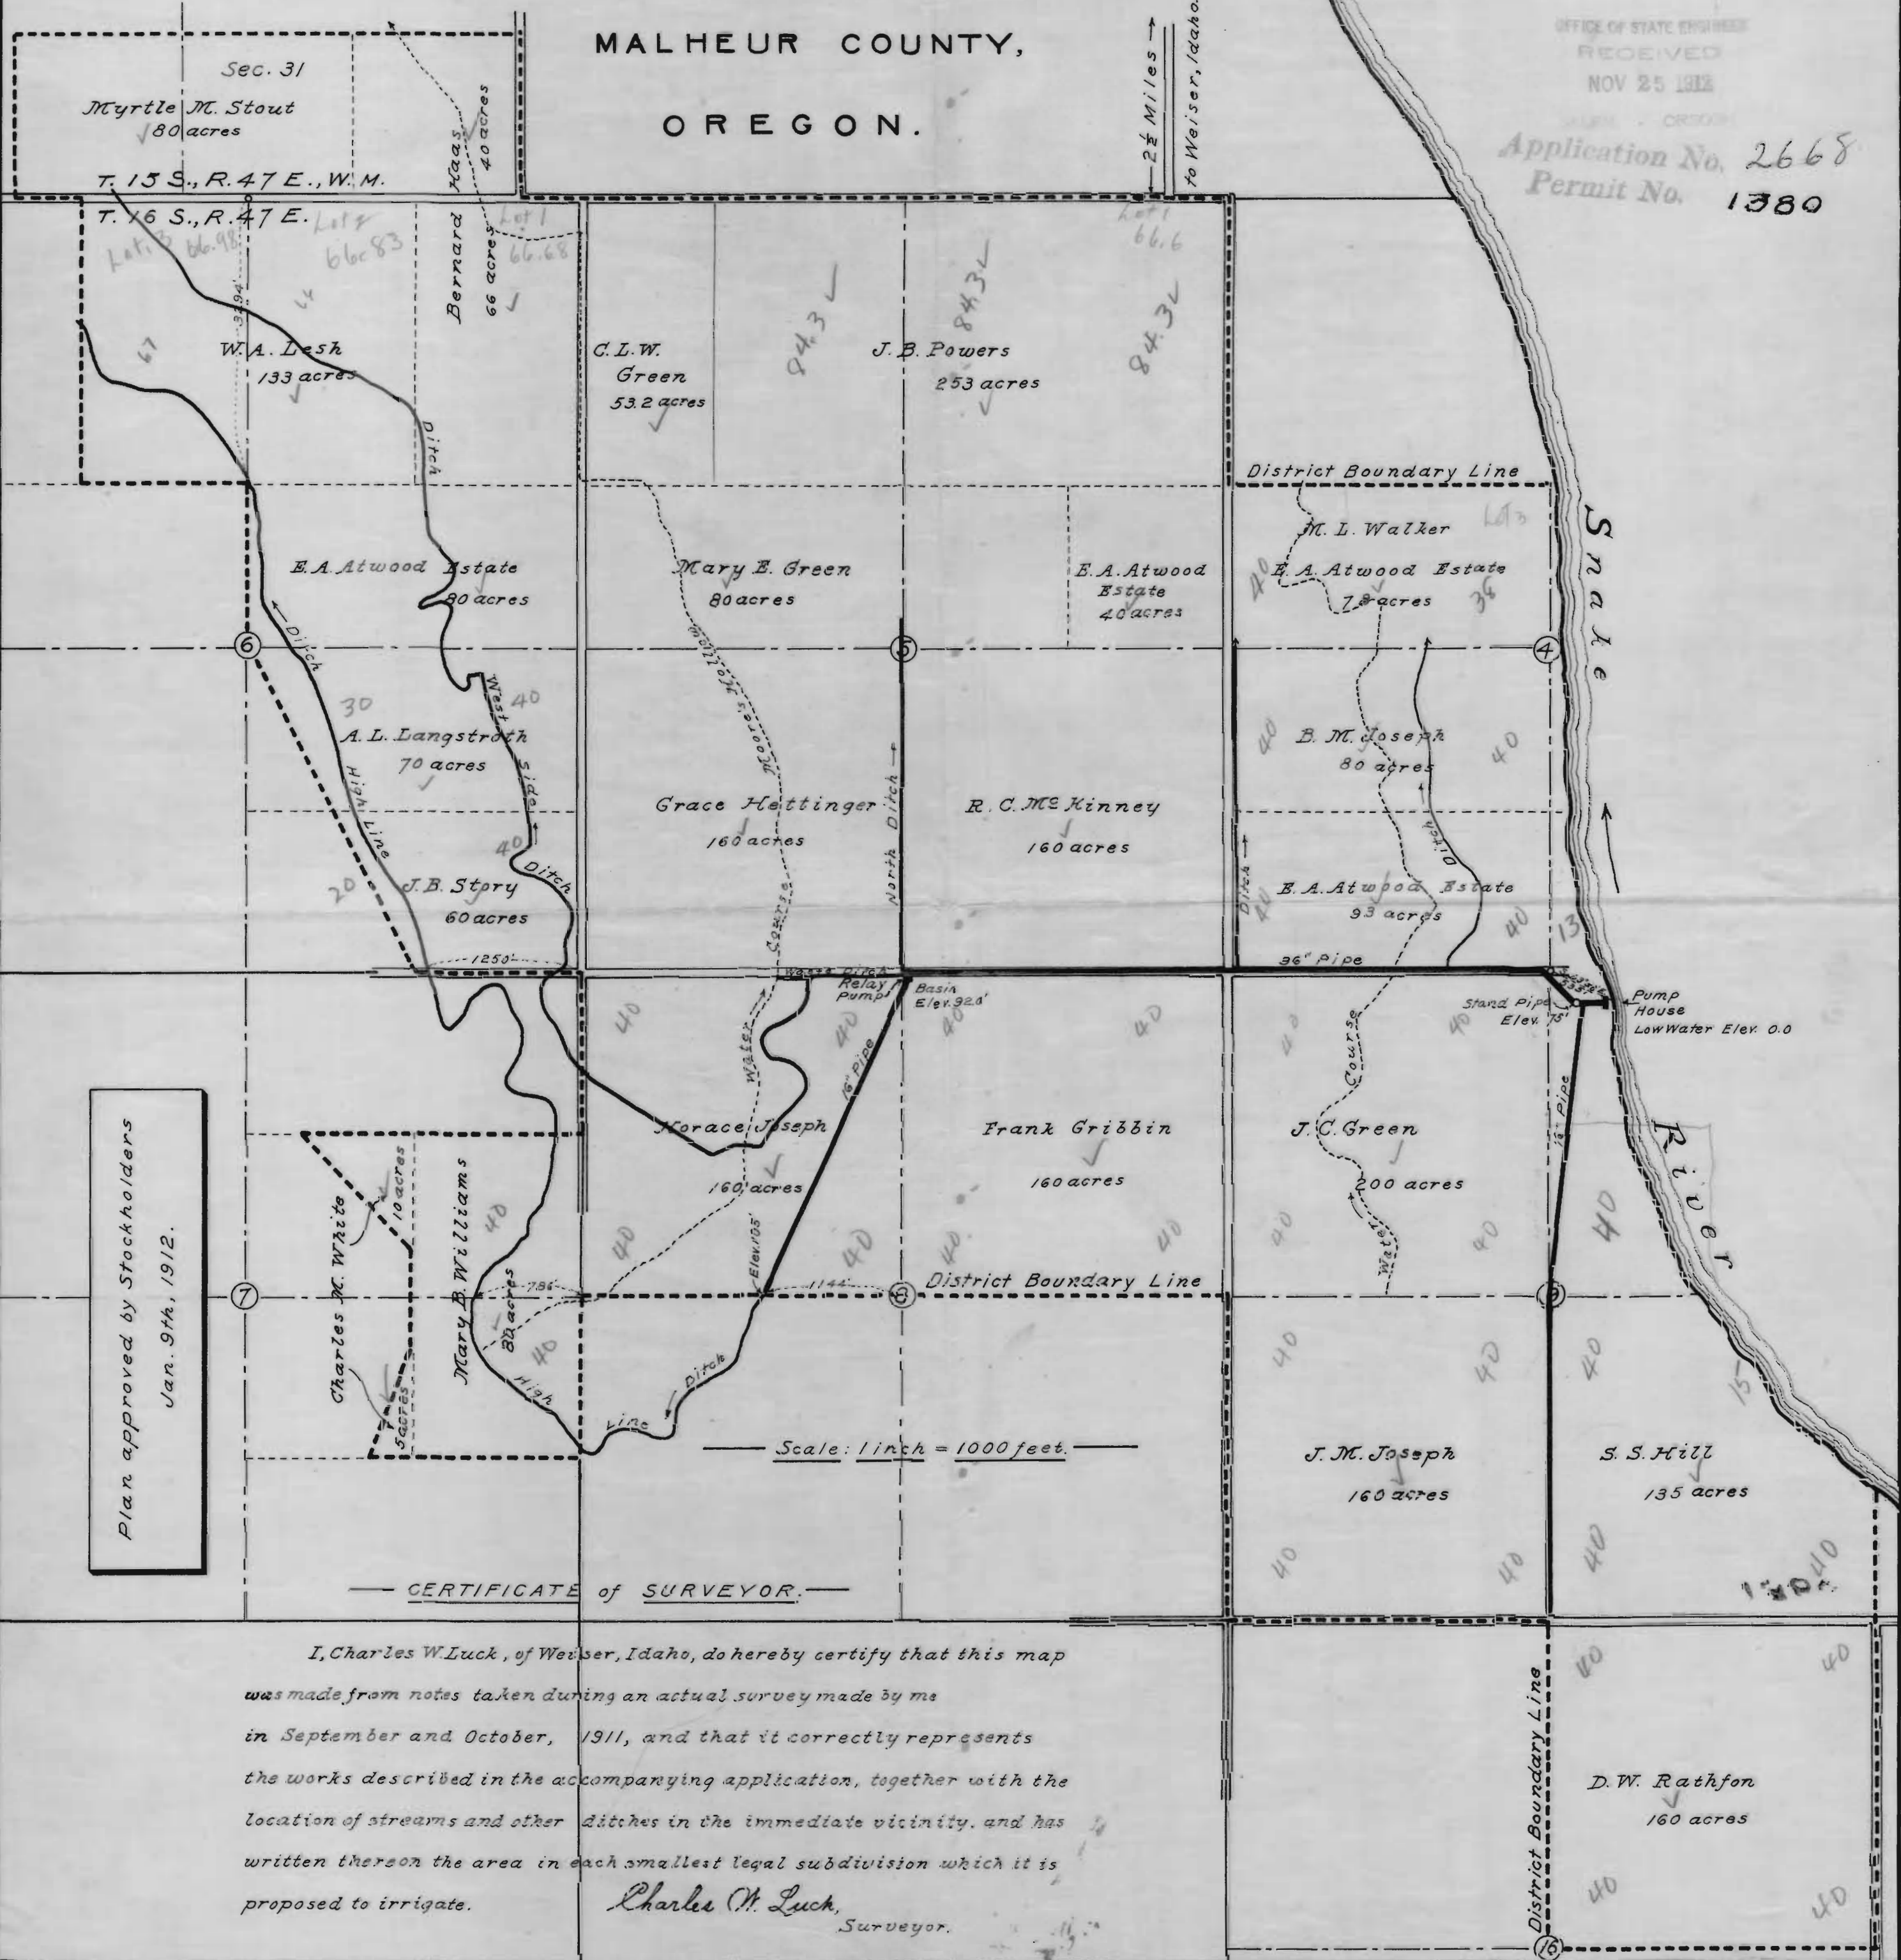

Plan approved by Stockholders  
Jan. 9th, 1912.

**CERTIFICATE of SURVEYOR.**

I, Charles W. Luck, of Weiser, Idaho, do hereby certify that this map was made from notes taken during an actual survey made by me in September and October, 1911, and that it correctly represents the works described in the accompanying application, together with the location of streams and other ditches in the immediate vicinity, and has written thereon the area in each smallest legal subdivision which it is proposed to irrigate.

Charles W. Luck,  
Surveyor.

8000




