


SECTION

7

TOWNSHIP 7S., RANGE 5W., W. M.

North

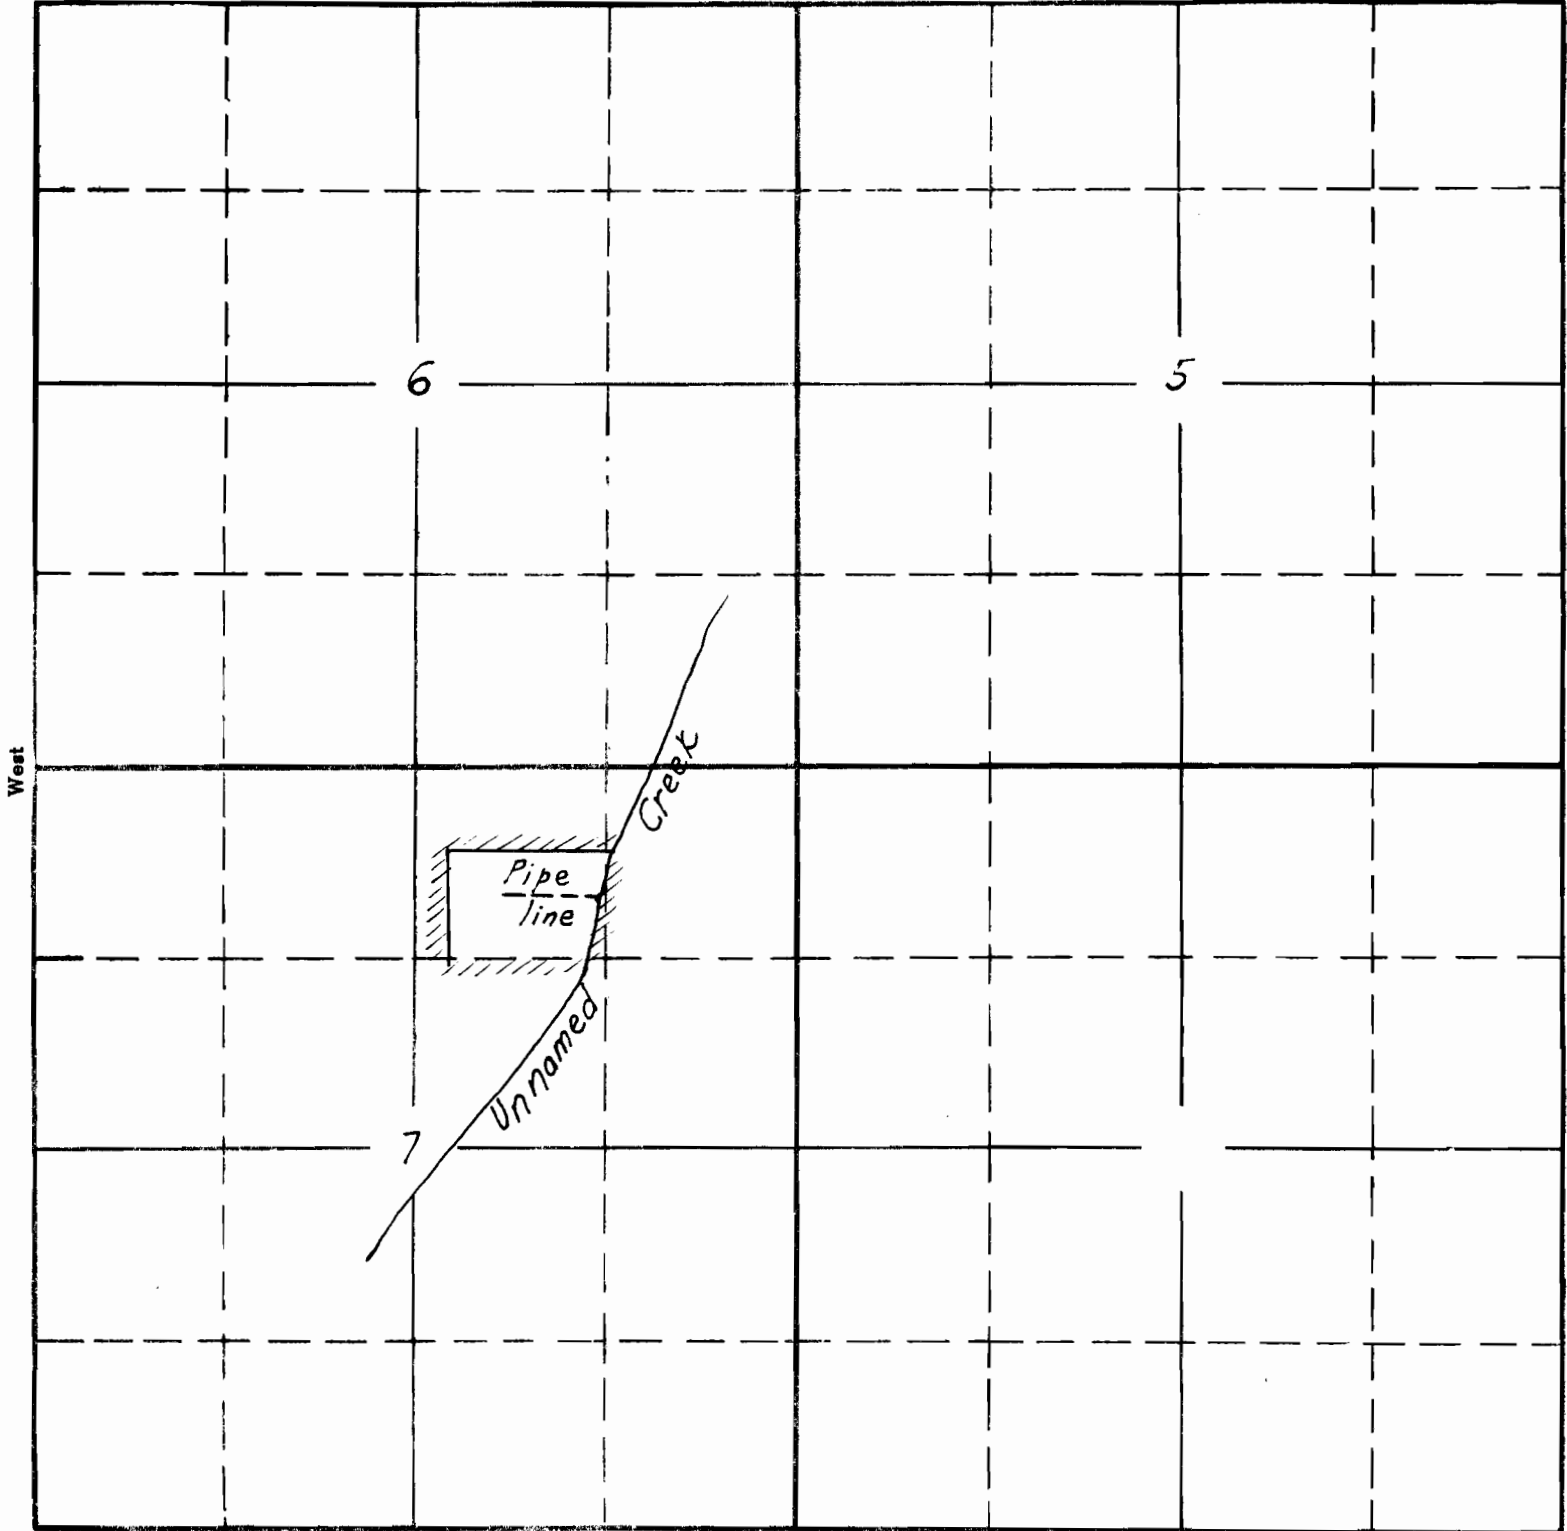

West

East


South

2-10-E
APPLICATION No. 18187
PERMIT No. 13816

SECTION

TOWNSHIP 75 , RANGE 5W , W. M.

North

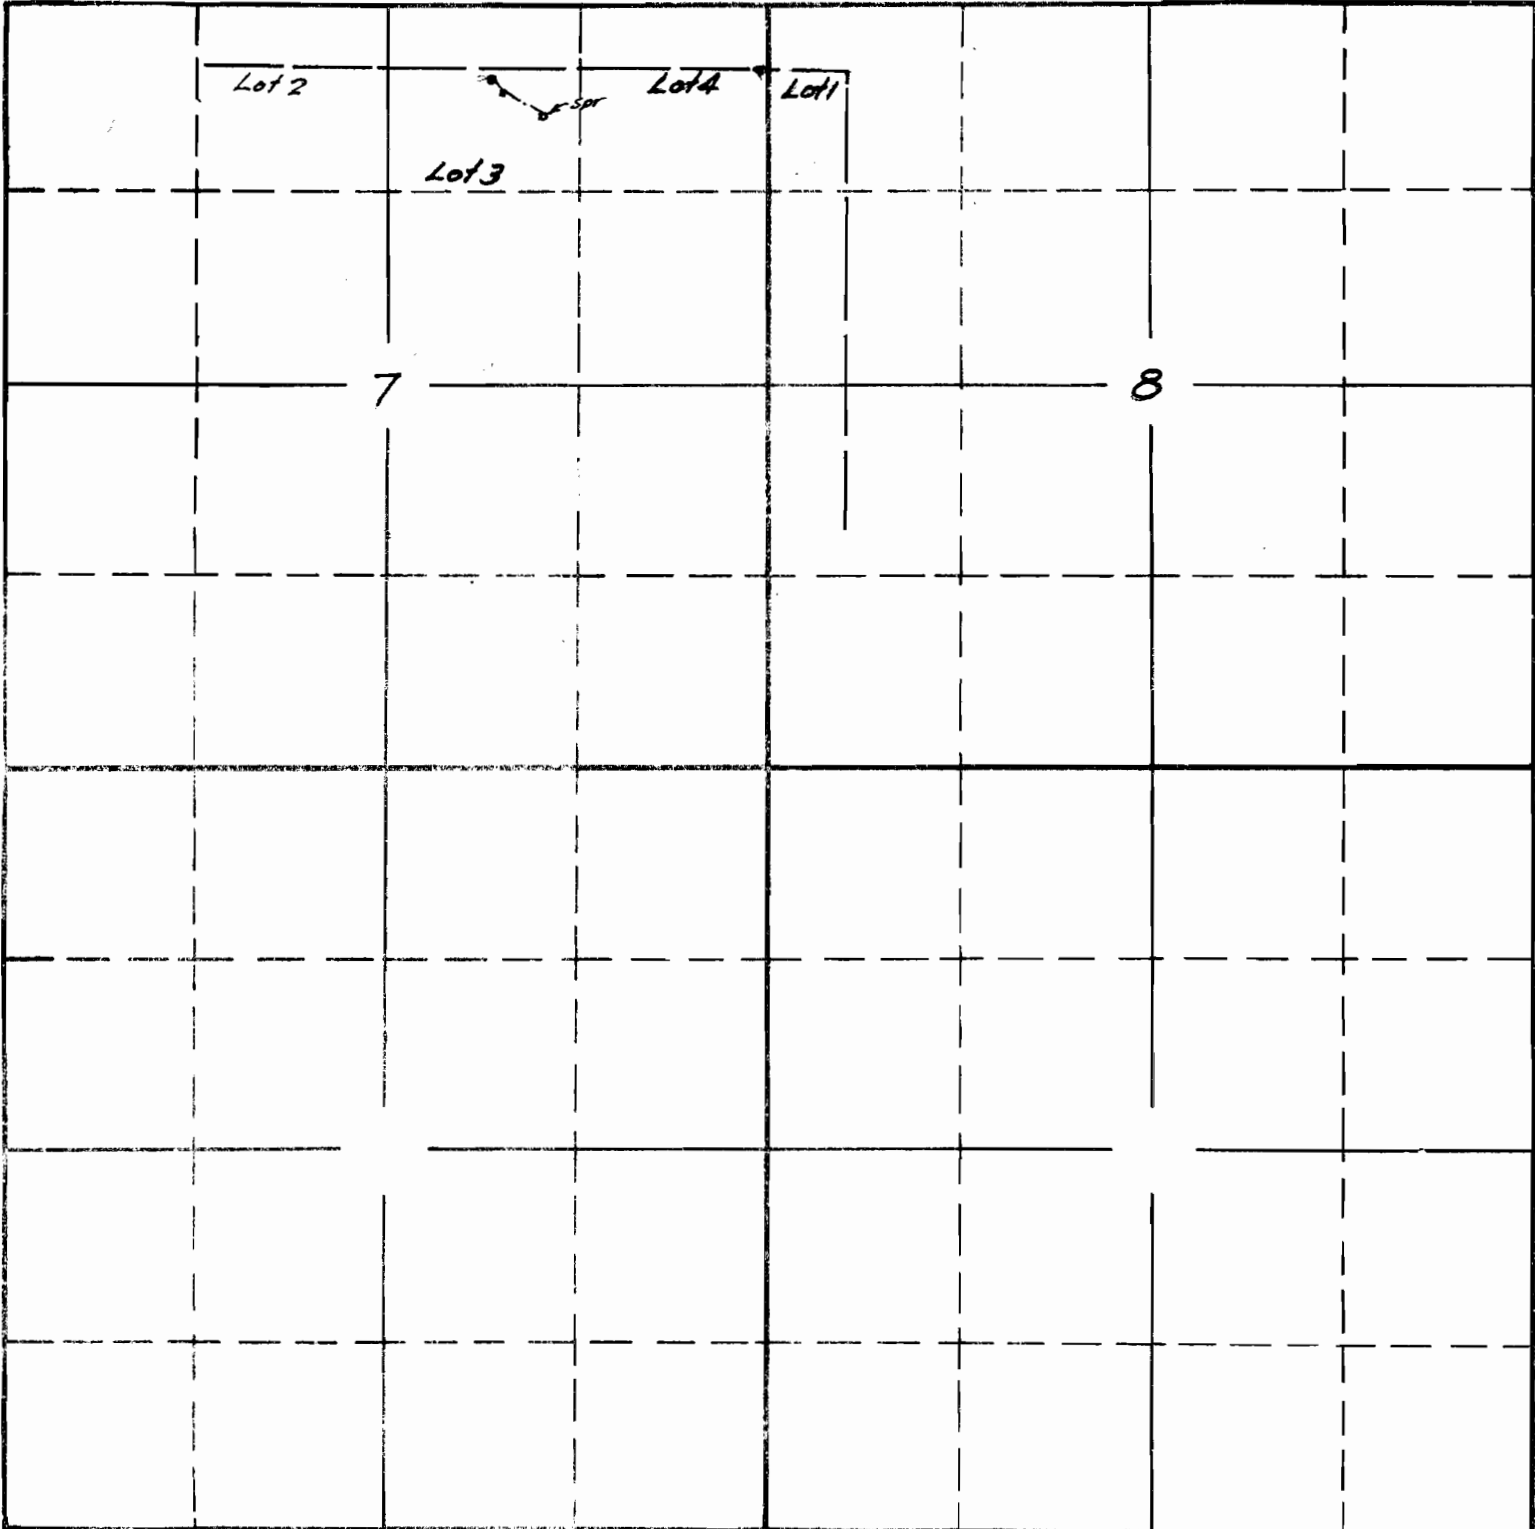

Surveyed May 31 1940 C.A.C.

South

APPLICATION No. 18187

PERMIT No. 13816