


10

TOWNSHIP 33 S, RANGE 2 E, W. M.

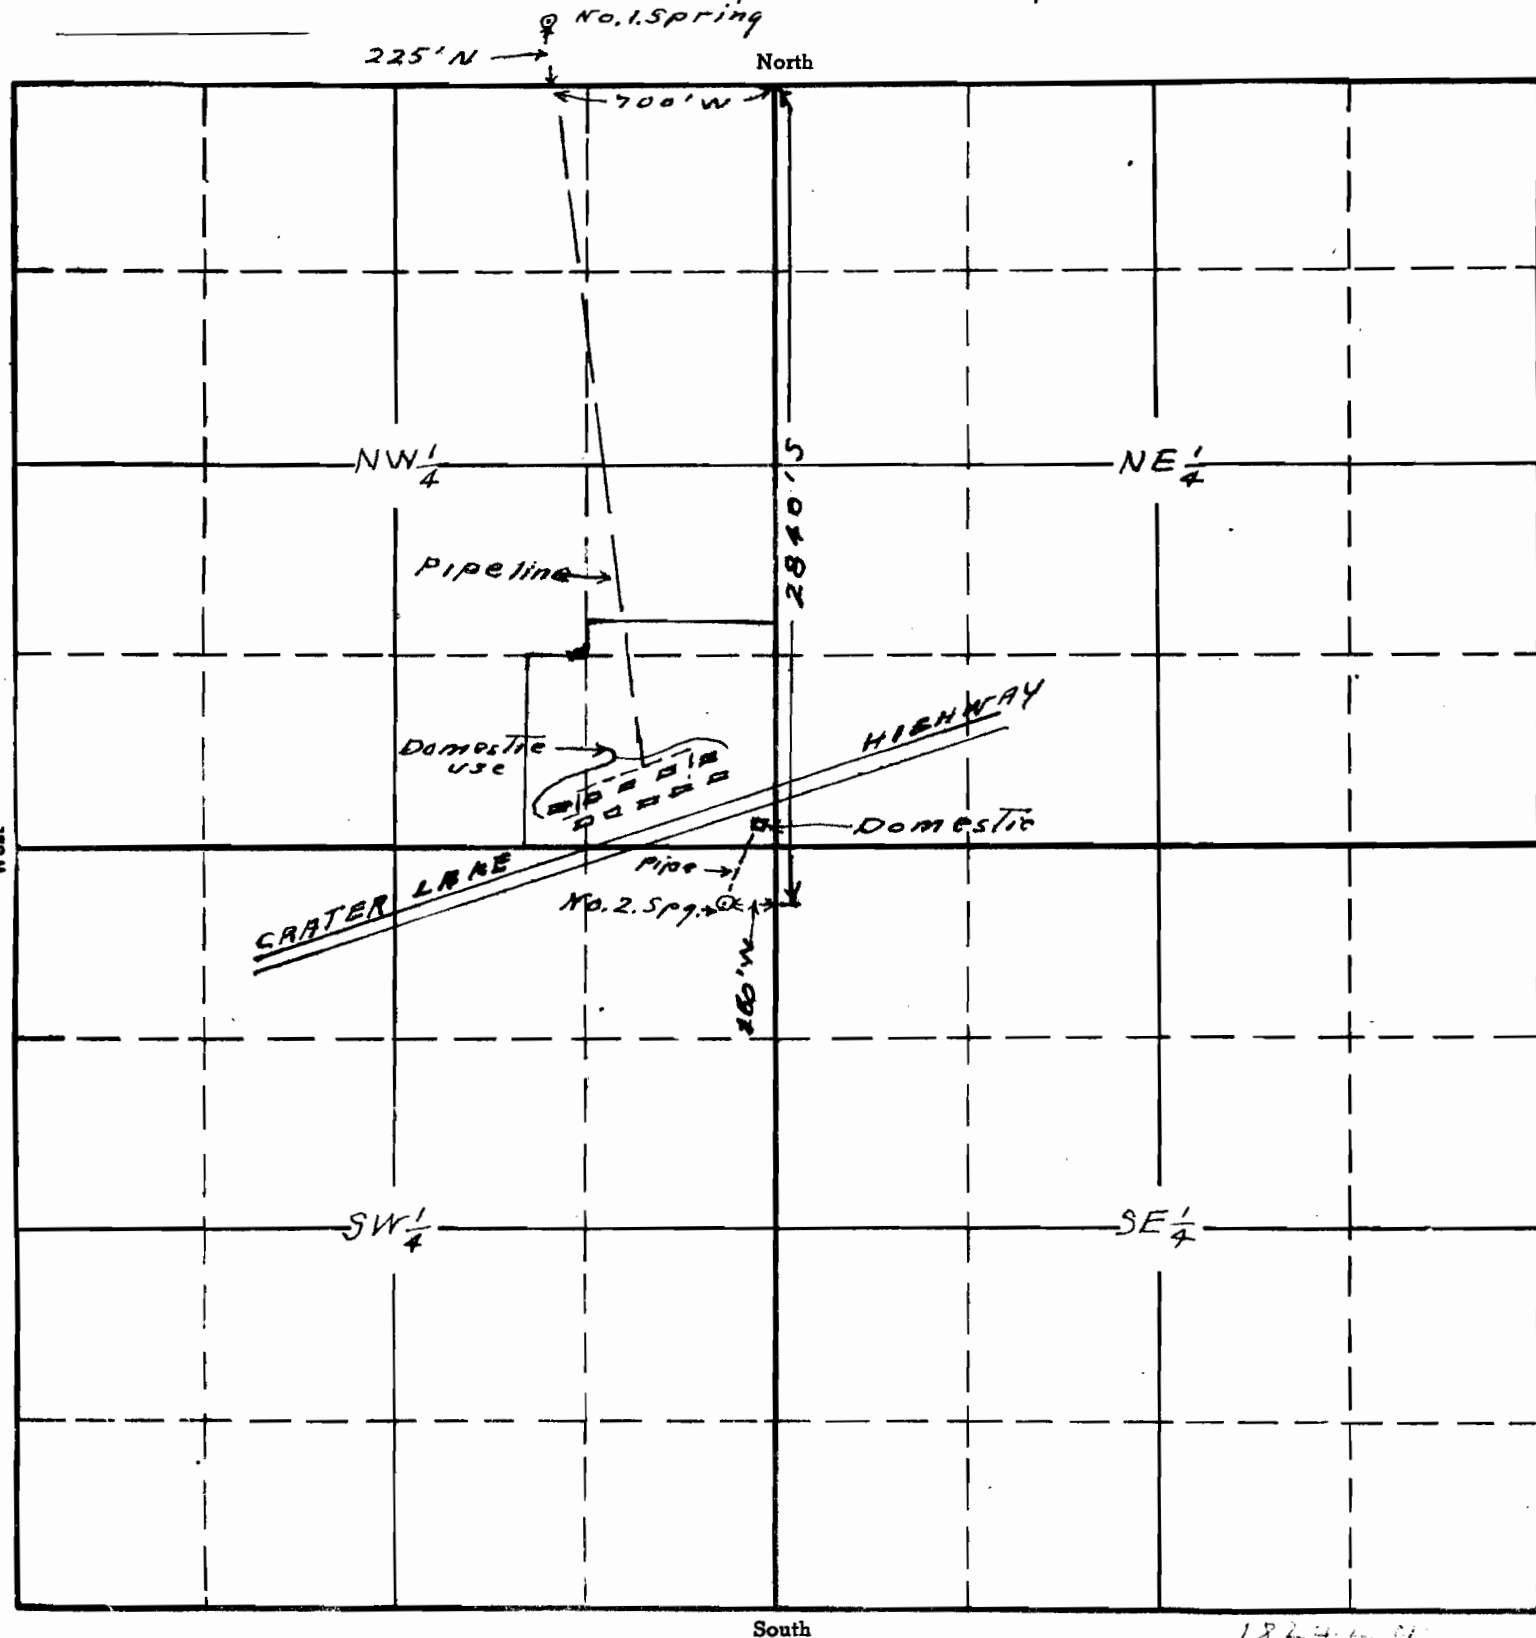

1824-10-11

APPLICATION No. 18242

PERMIT No. 13901