


SECTION

TOWNSHIP 355, RANGE 11W, W. M.

North

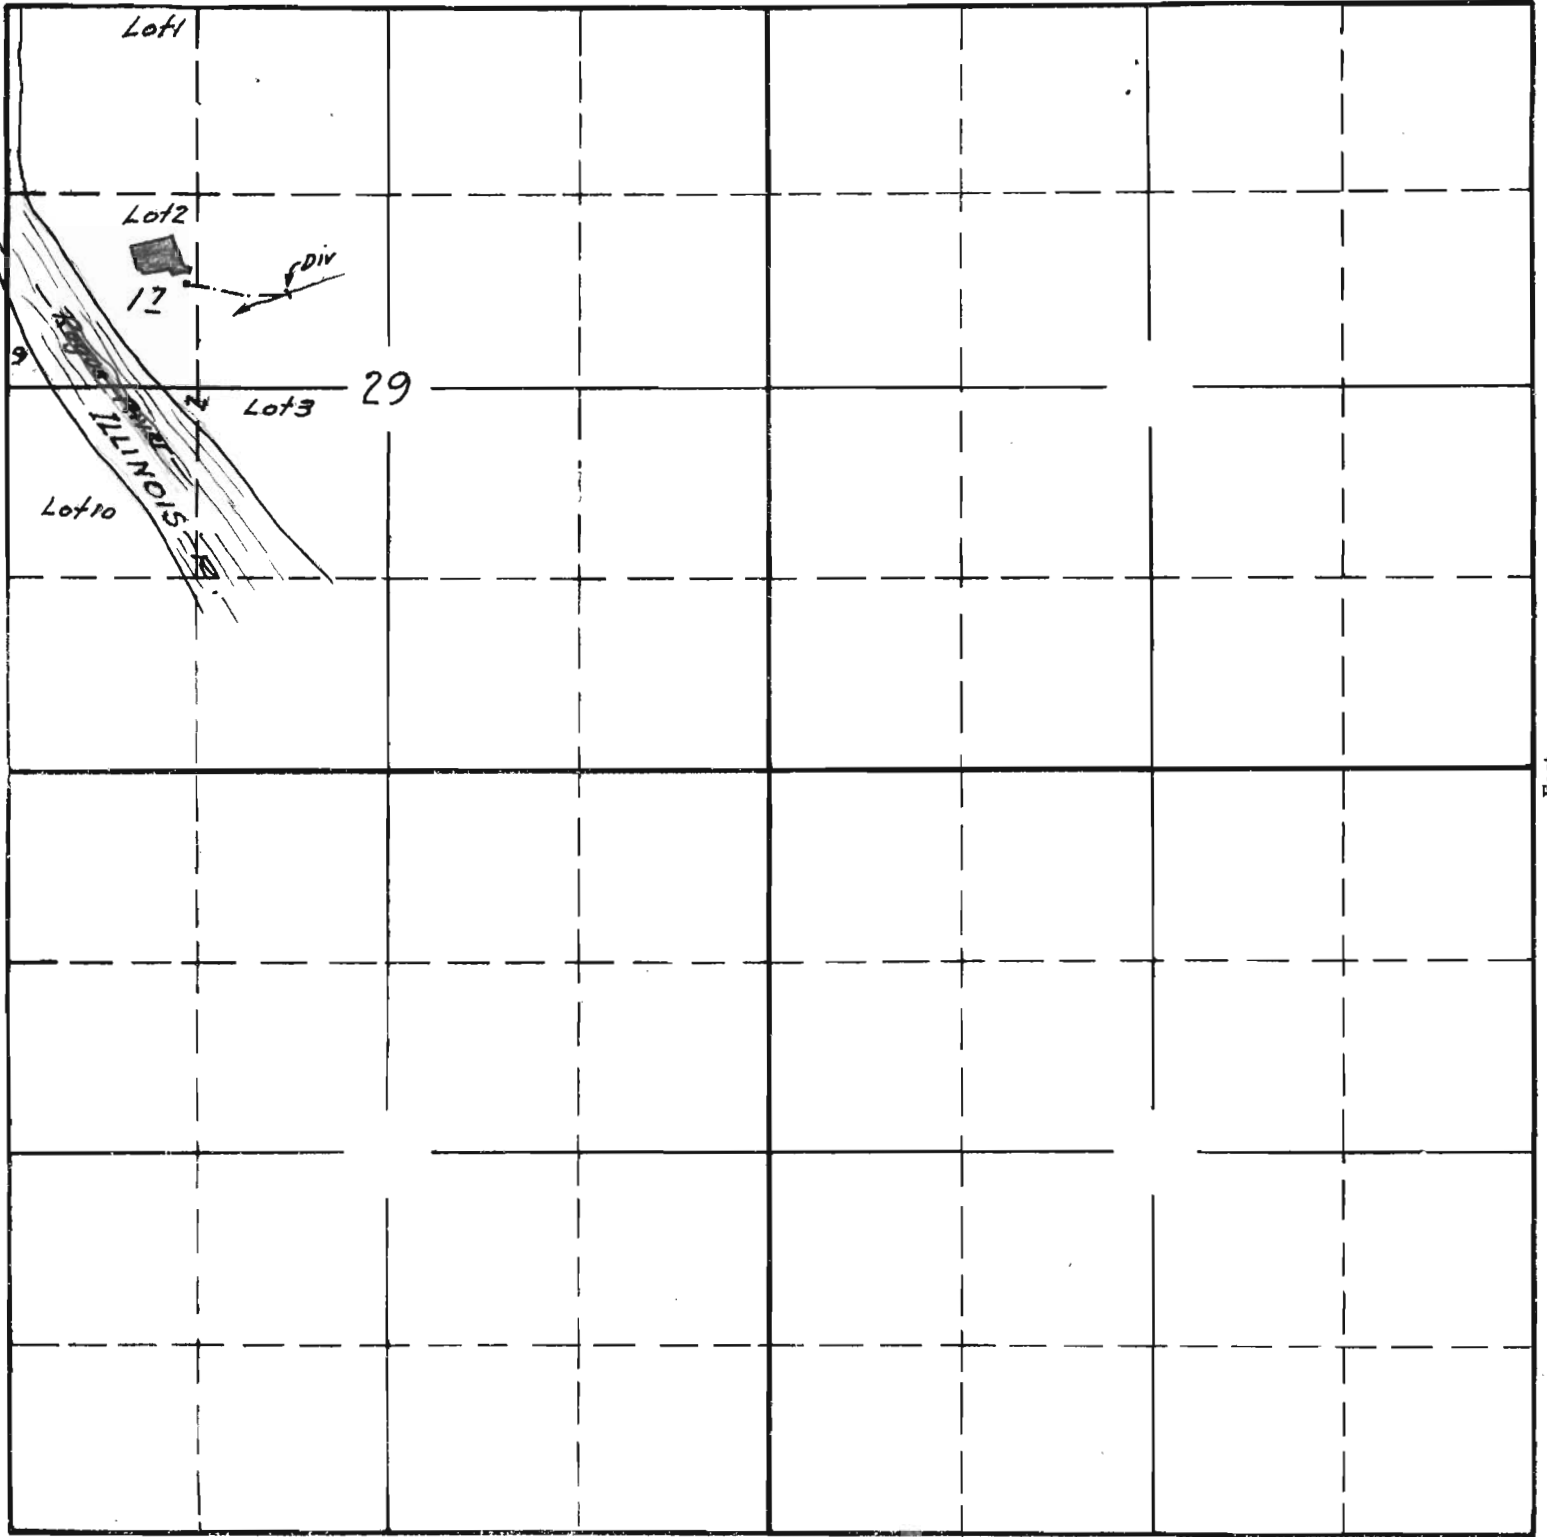

Surveyed July 3, 1940 C.A.C.

South

APPLICATION No. 18308

PERMIT No. 13950