


4

TOWNSHIP 34S , RANGE 4W , W. M.

North

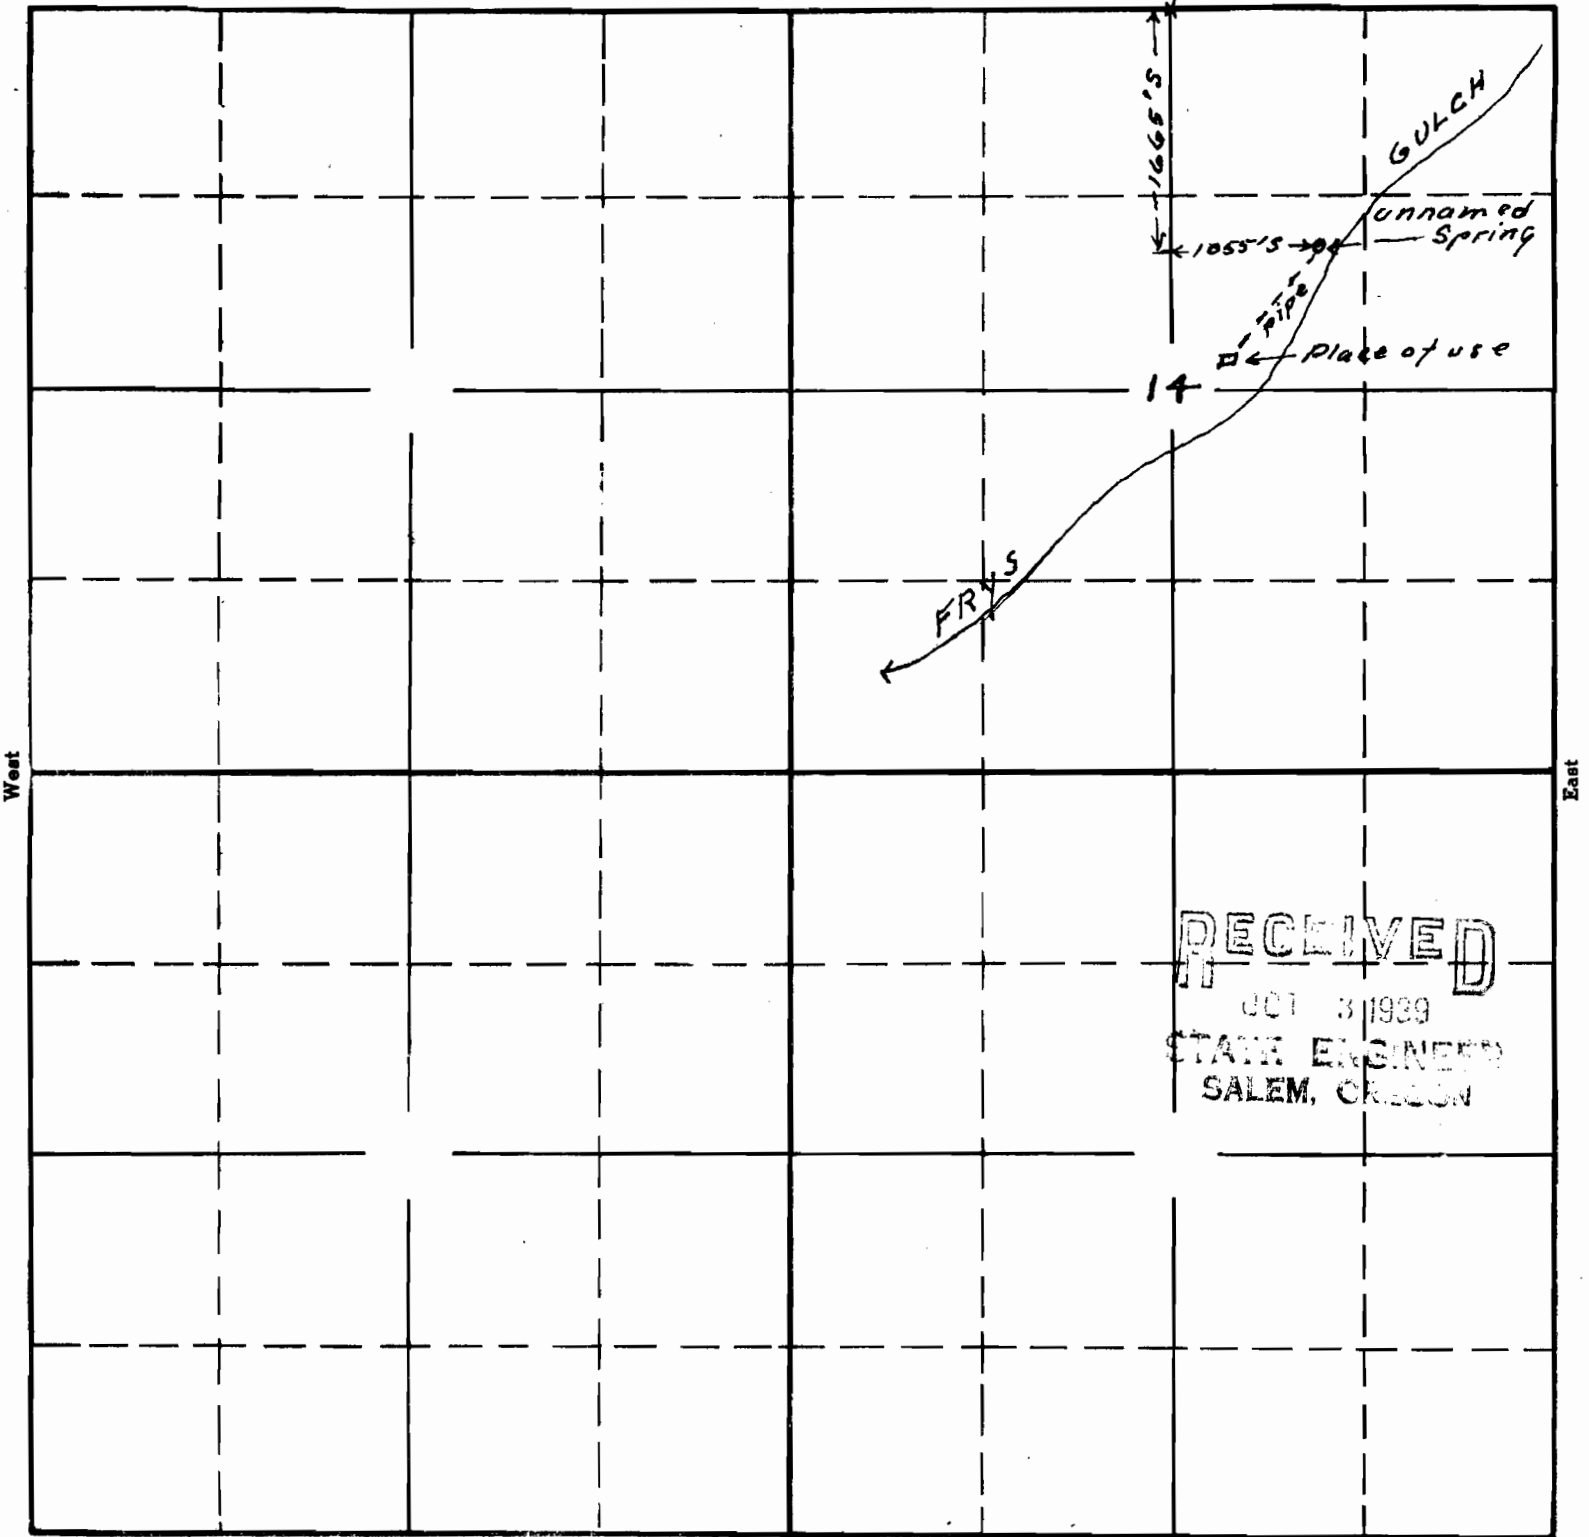

RECEIVED
 OCT 3 1939
 STATE ENGINEER
 SALEM, OREGON

Sketch to accompany application of J.C. Smith for use of the waters of unnamed spring for domestic purposes - spring on property of applicant - J.C. Smith

18404 01L
 15-40
 APPLICATION No. 18404
 PERMIT No. 14041

This office Oct 2, 1939 *Attorney*