


4

TOWNSHIP 36 S , RANGE 1 W , W. M.

North

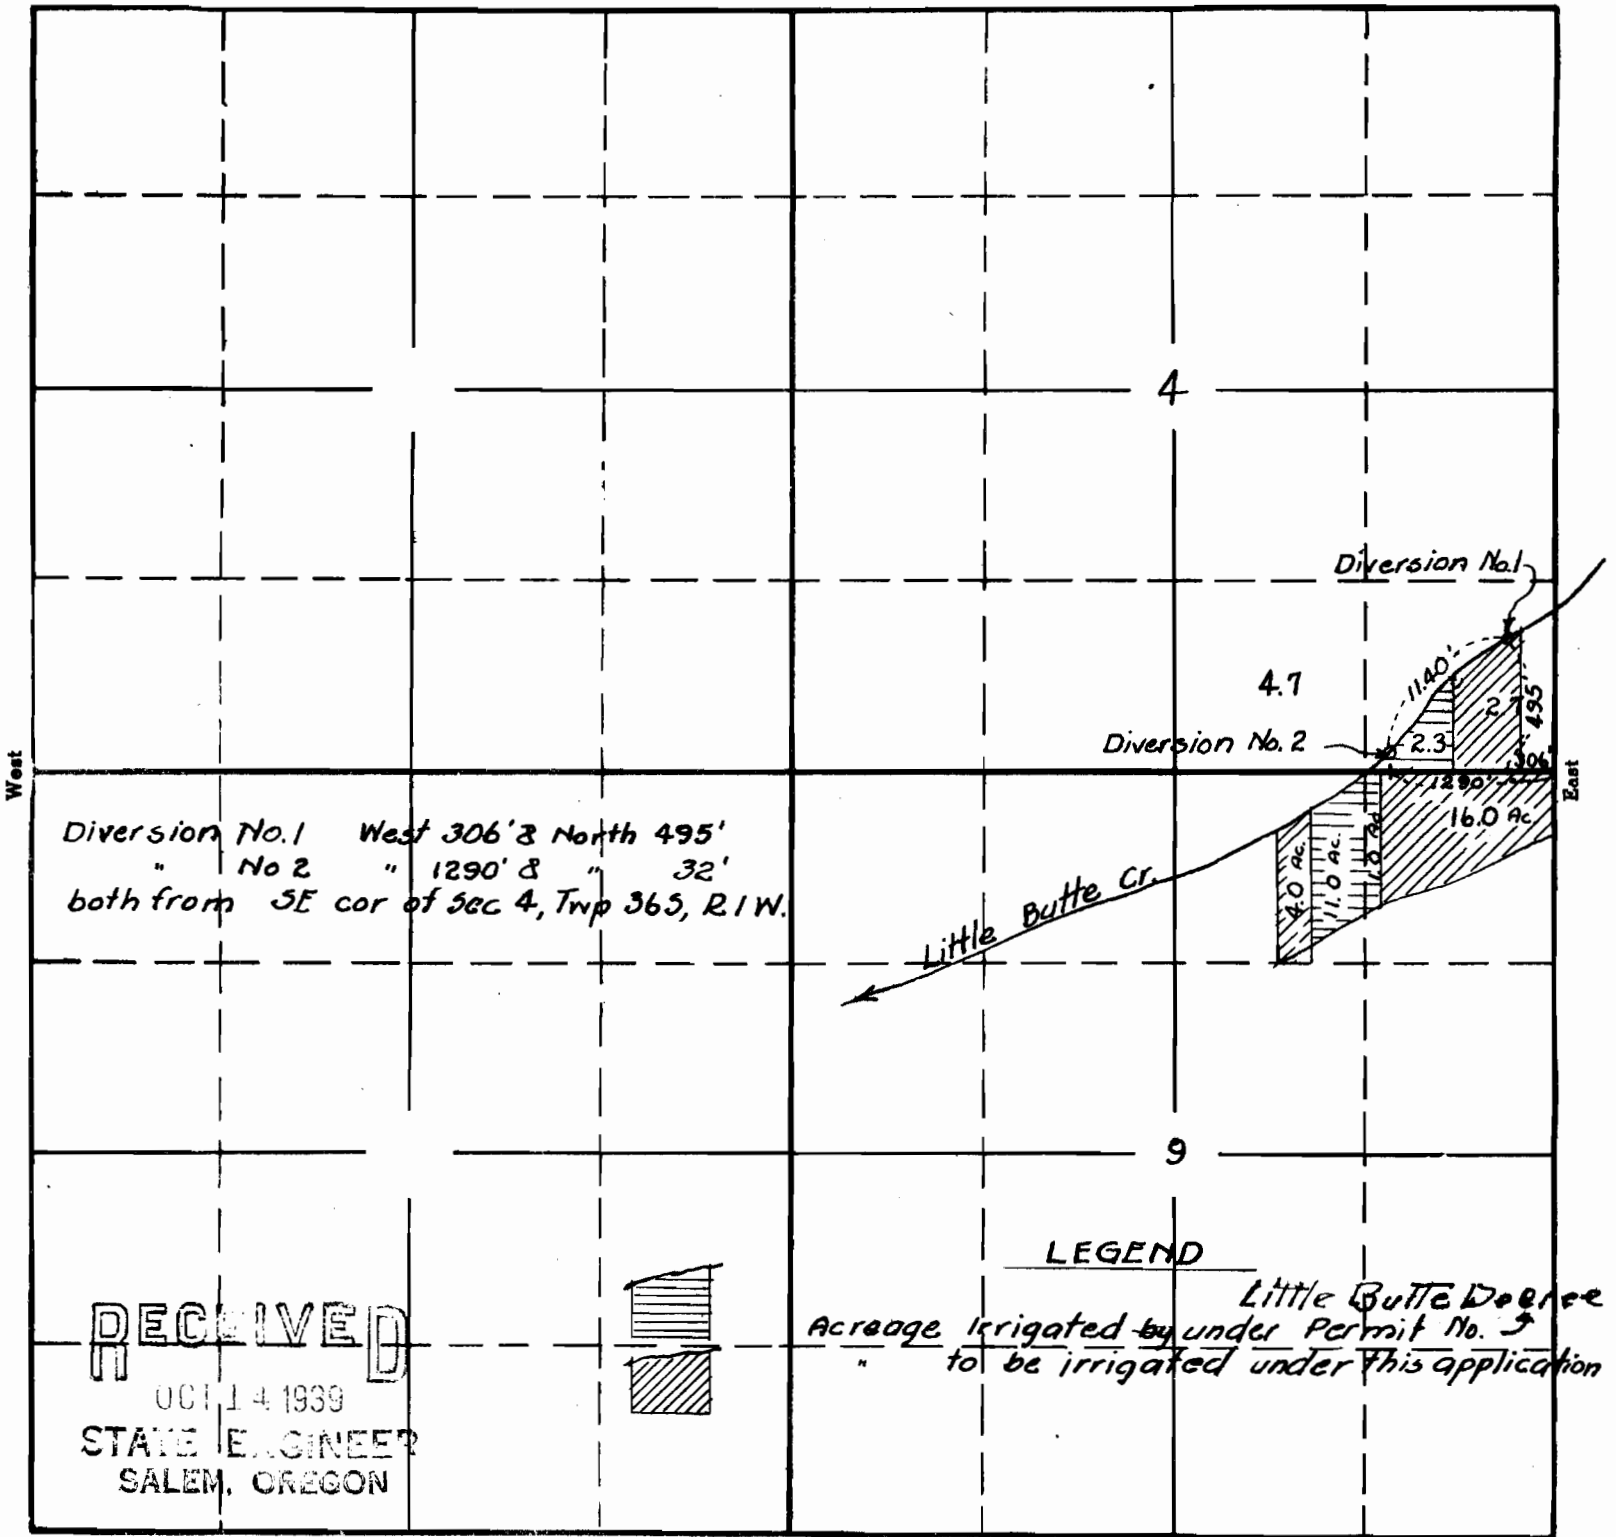

Map to accompany the application of W.F. & Lula M. Martin of Eagle Point, Oregon, for the use of .29 c.f.s. of the waters of Little Butte Creek for irrigation purposes.

18422 OK  
15-29  
APPLICATION No. 18422  
PERMIT No. 14055