


SECTION

TOWNSHIP 15, RANGE 3W, W. M.

North

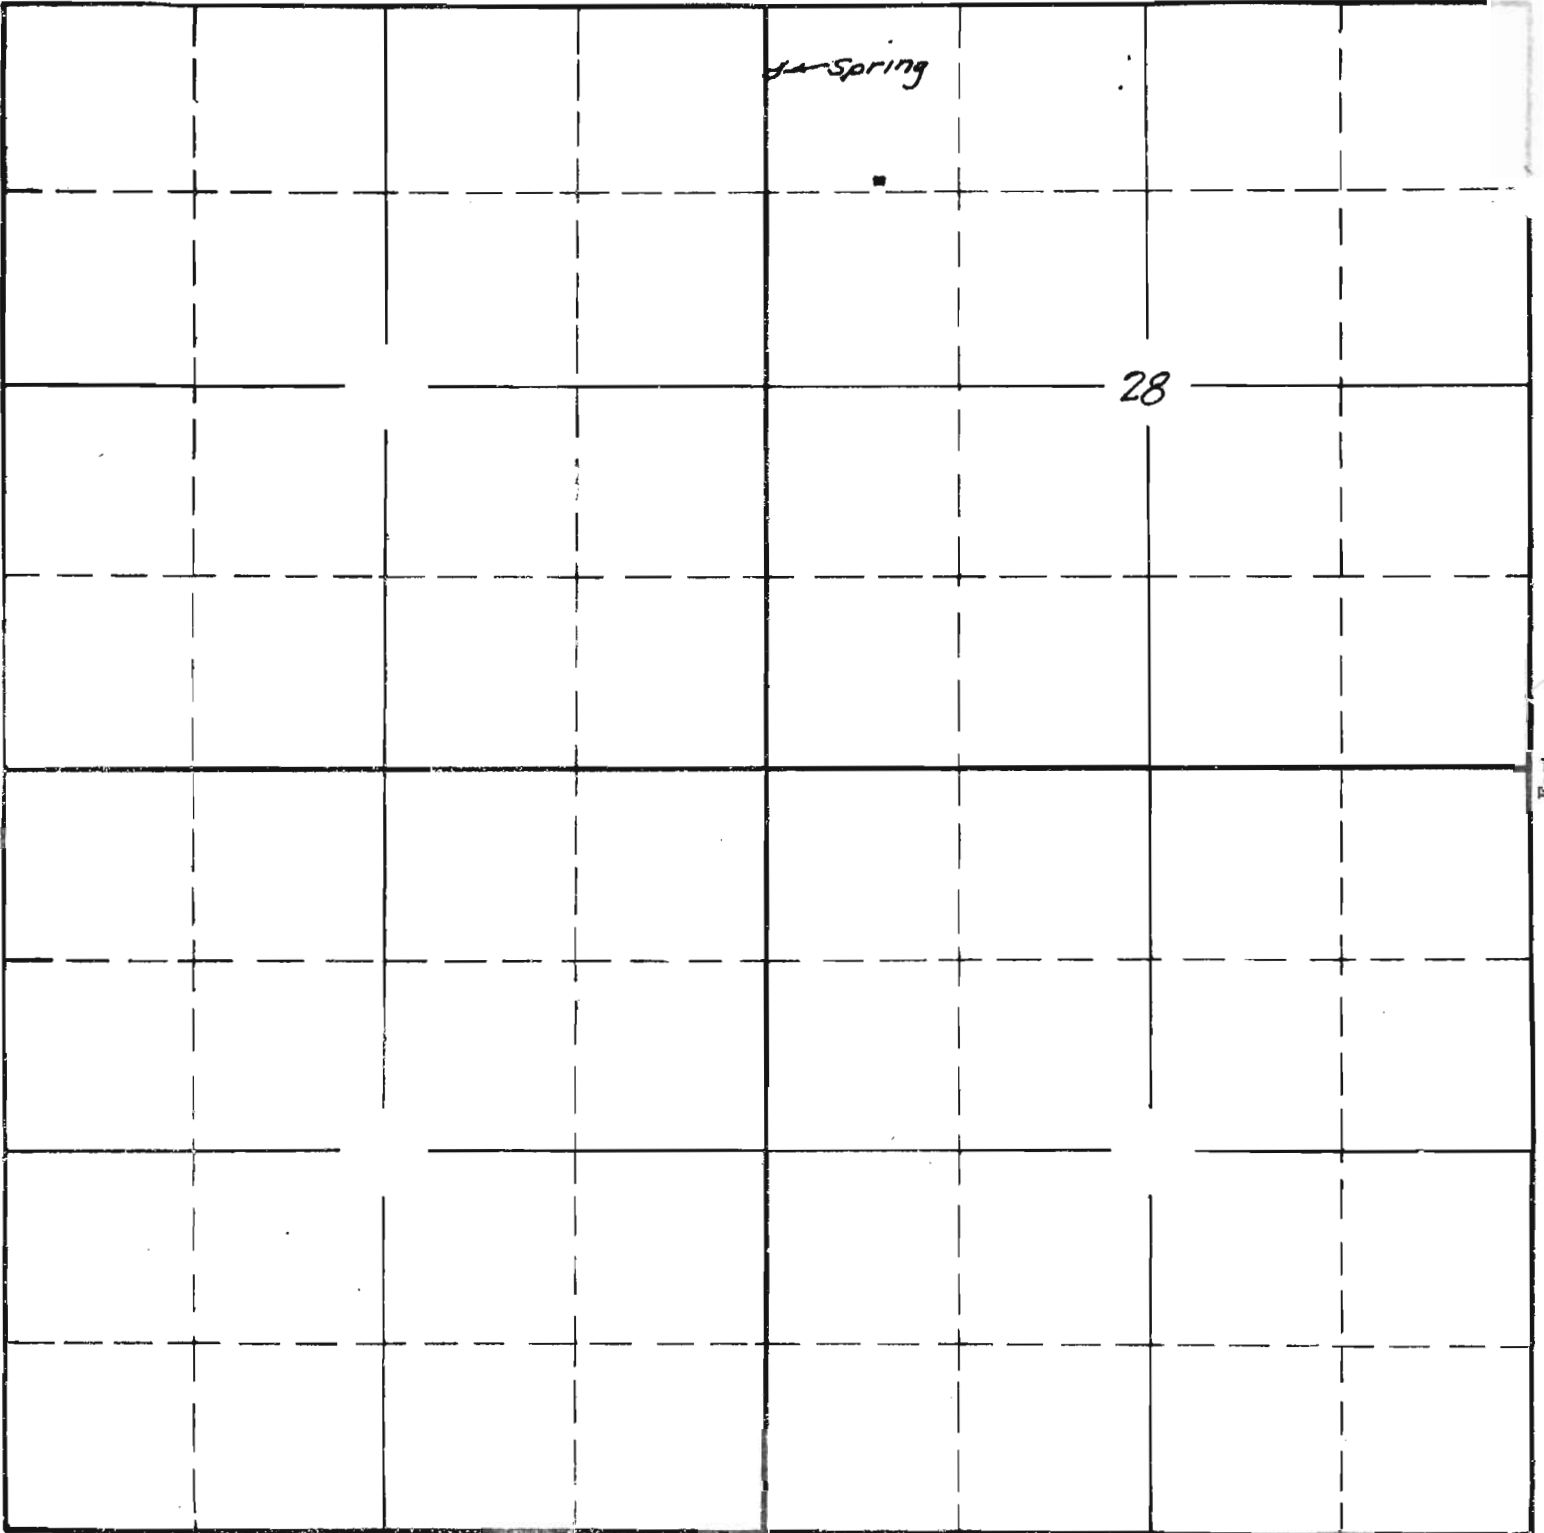

28

Spring

West

East

Surveyed June 10, 1940 C.A.C.

South


APPLICATION No. 18426

PERMIT No. 14057

SECTION

TOWNSHIP 15 , RANGE 3W , W. M.

North

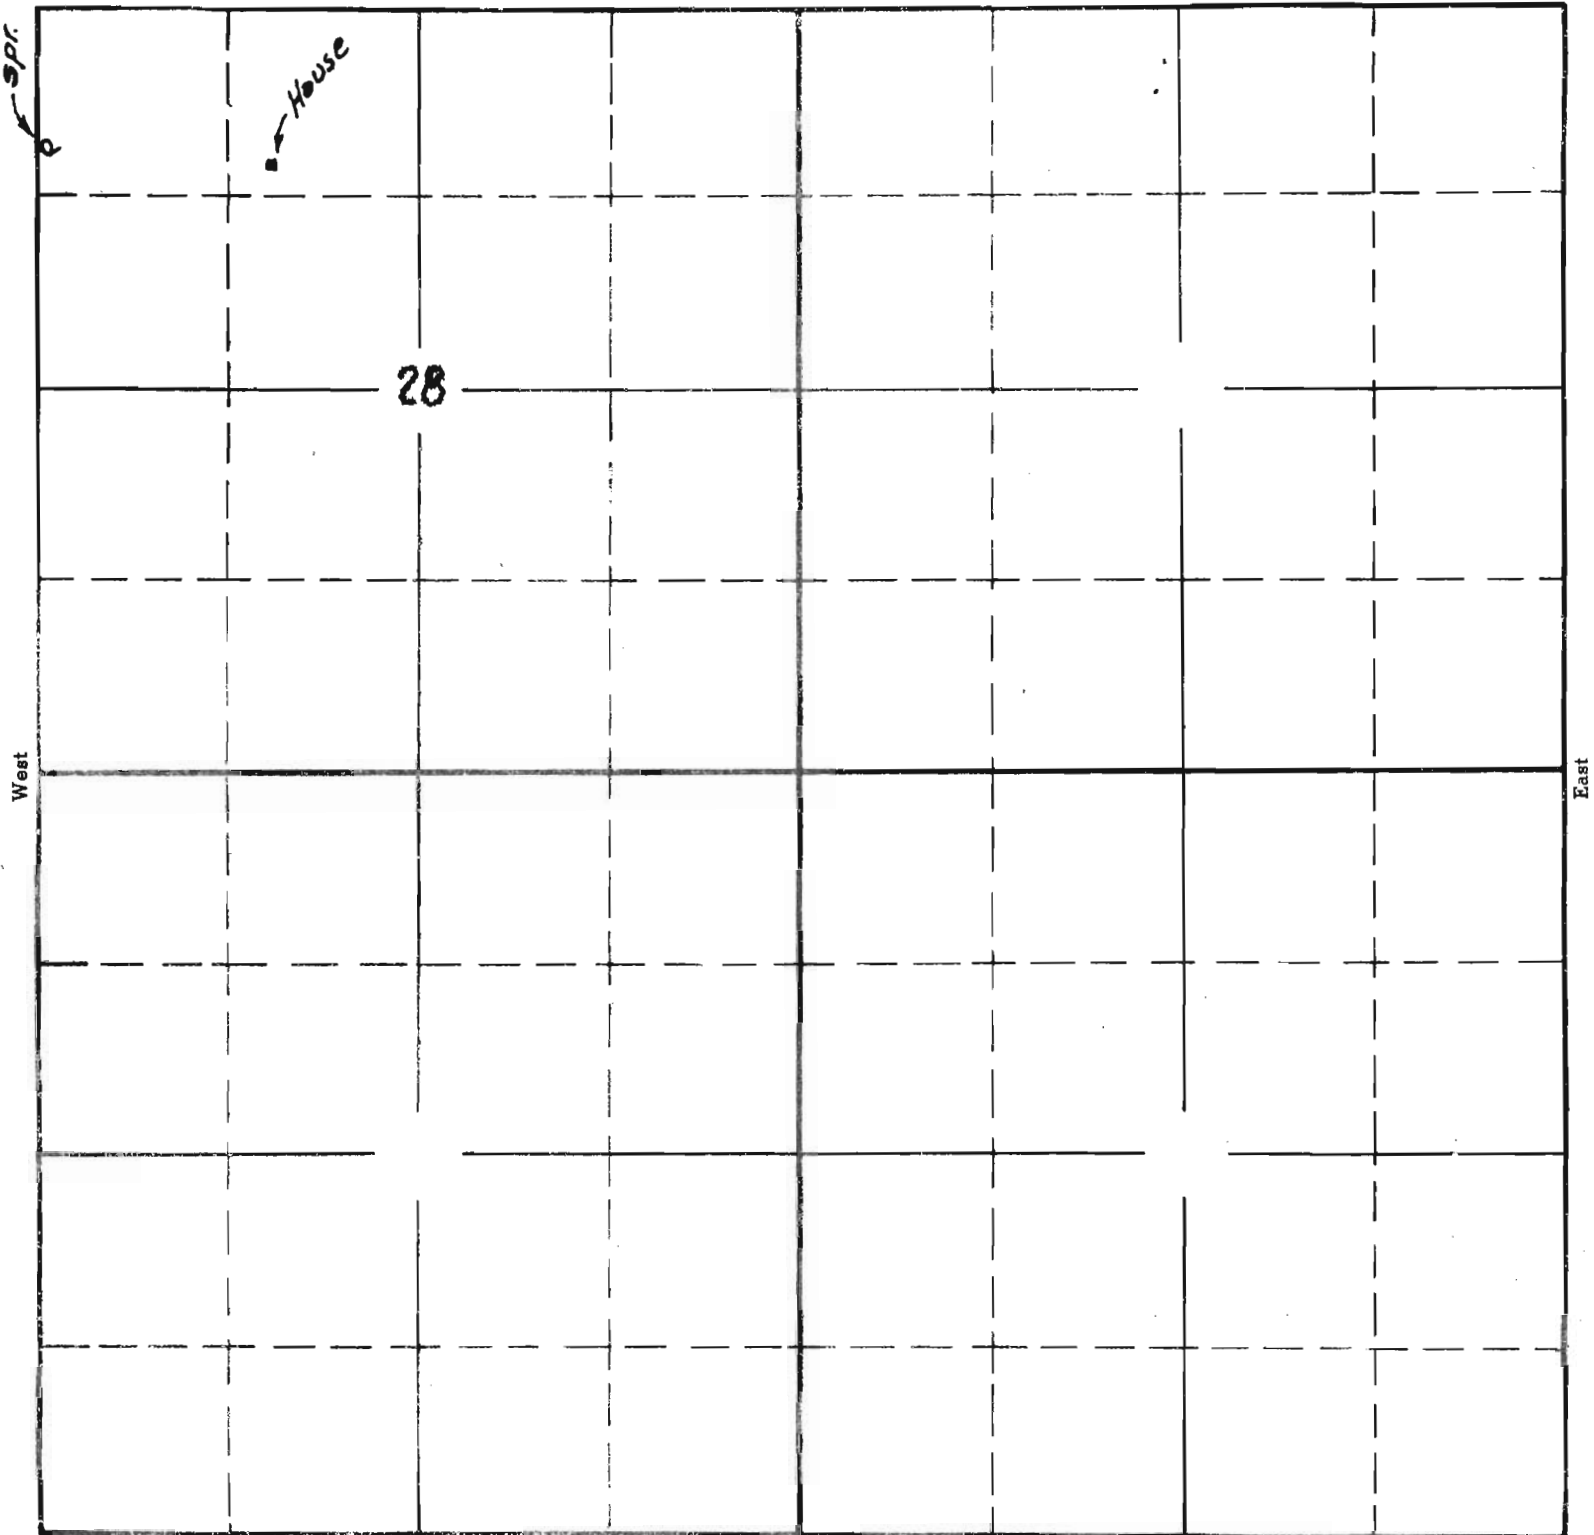

South

18426 OK
2-62F

APPLICATION No. 18426

PERMIT No. 14057