


SECTION

TOWNSHIP 75, RANGE 5W, W. M.

North

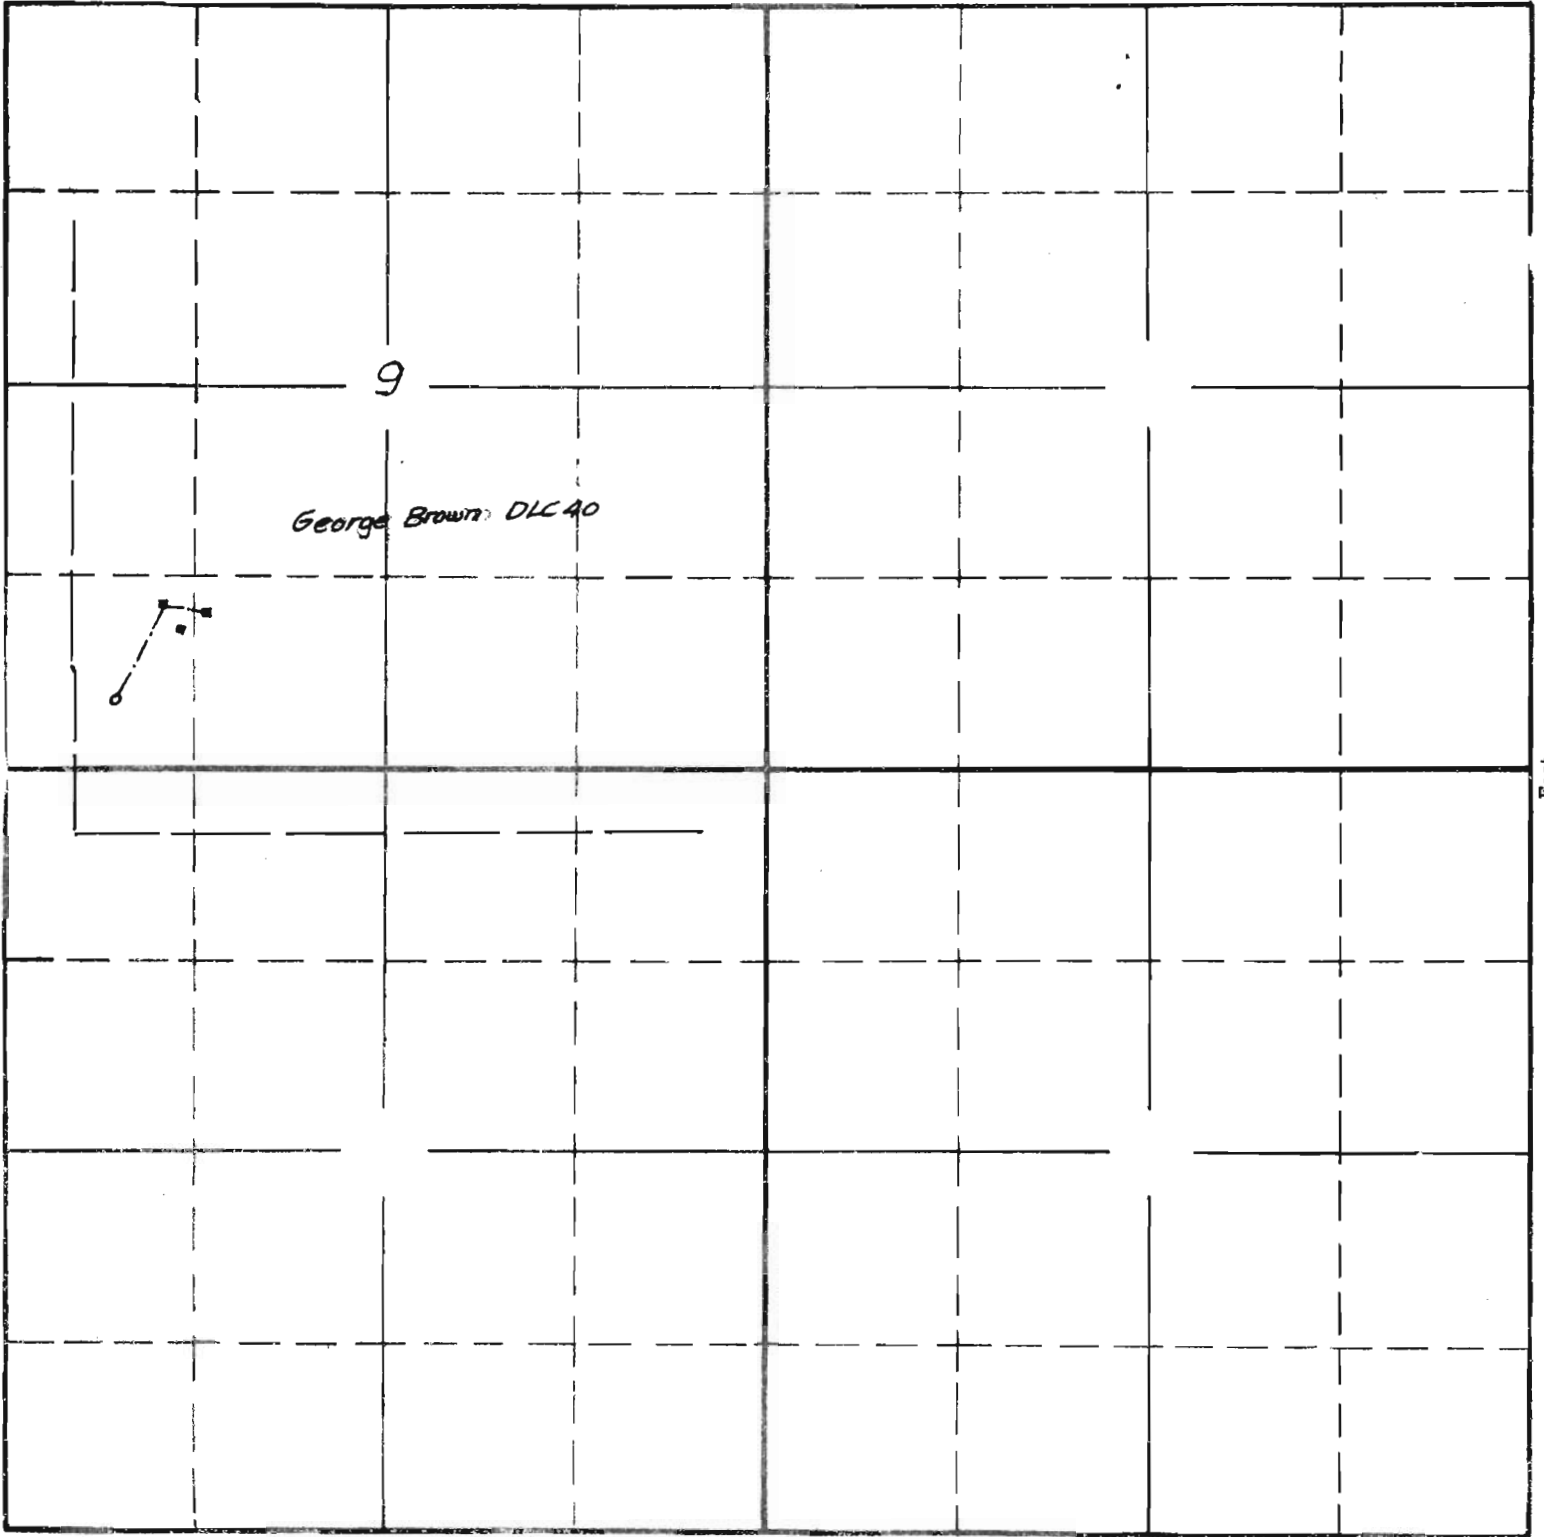

9

George Brown DLC 40

Surveyed May 31 1940 C.A.C.

South

APPLICATION No. 18452

PERMIT No. 14074


SECTION

TOWNSHIP 7 S, RANGE 5 W, W. M.

North

West

East

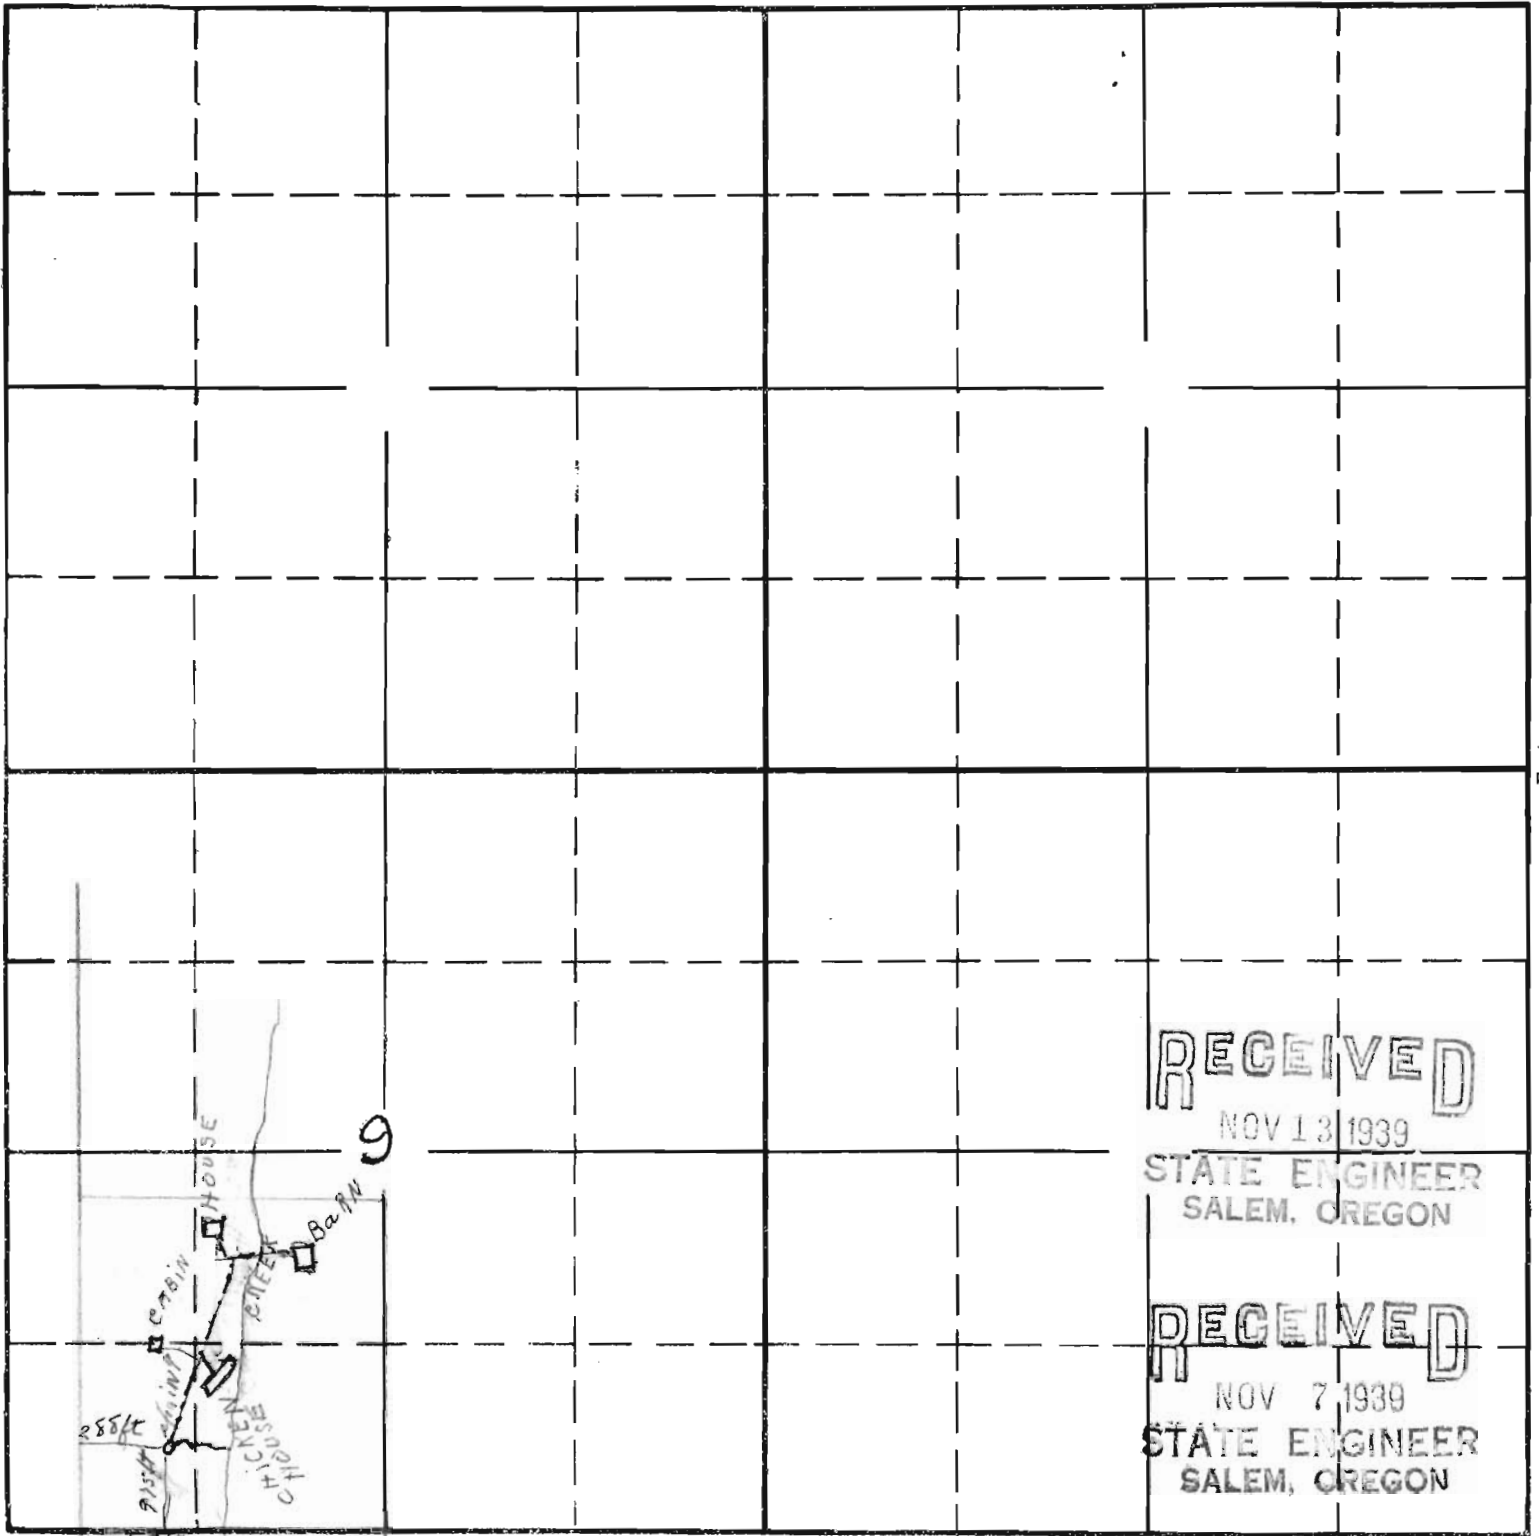

RECEIVED

NOV 13 1939

STATE ENGINEER
SALEM, OREGON

RECEIVED

NOV 7 1939

STATE ENGINEER
SALEM, OREGON

South

18452 OK
2-76H

APPLICATION No. 18452
PERMIT No. 14074

4 in. = 1 mile
1 in. = 1320 ft