

SECTION

TOWNSHIP 30S , RANGE 2W , W. M.

North

27

Spring

West

East

Surveyed July 8, 1940 C.A.C.

South

APPLICATION No. 18374


PERMIT No. 14111

SECTION

27  
28  
33  
34

TOWNSHIP 30<sup>S</sup>, RANGE 2<sup>W</sup>, W. M.

North

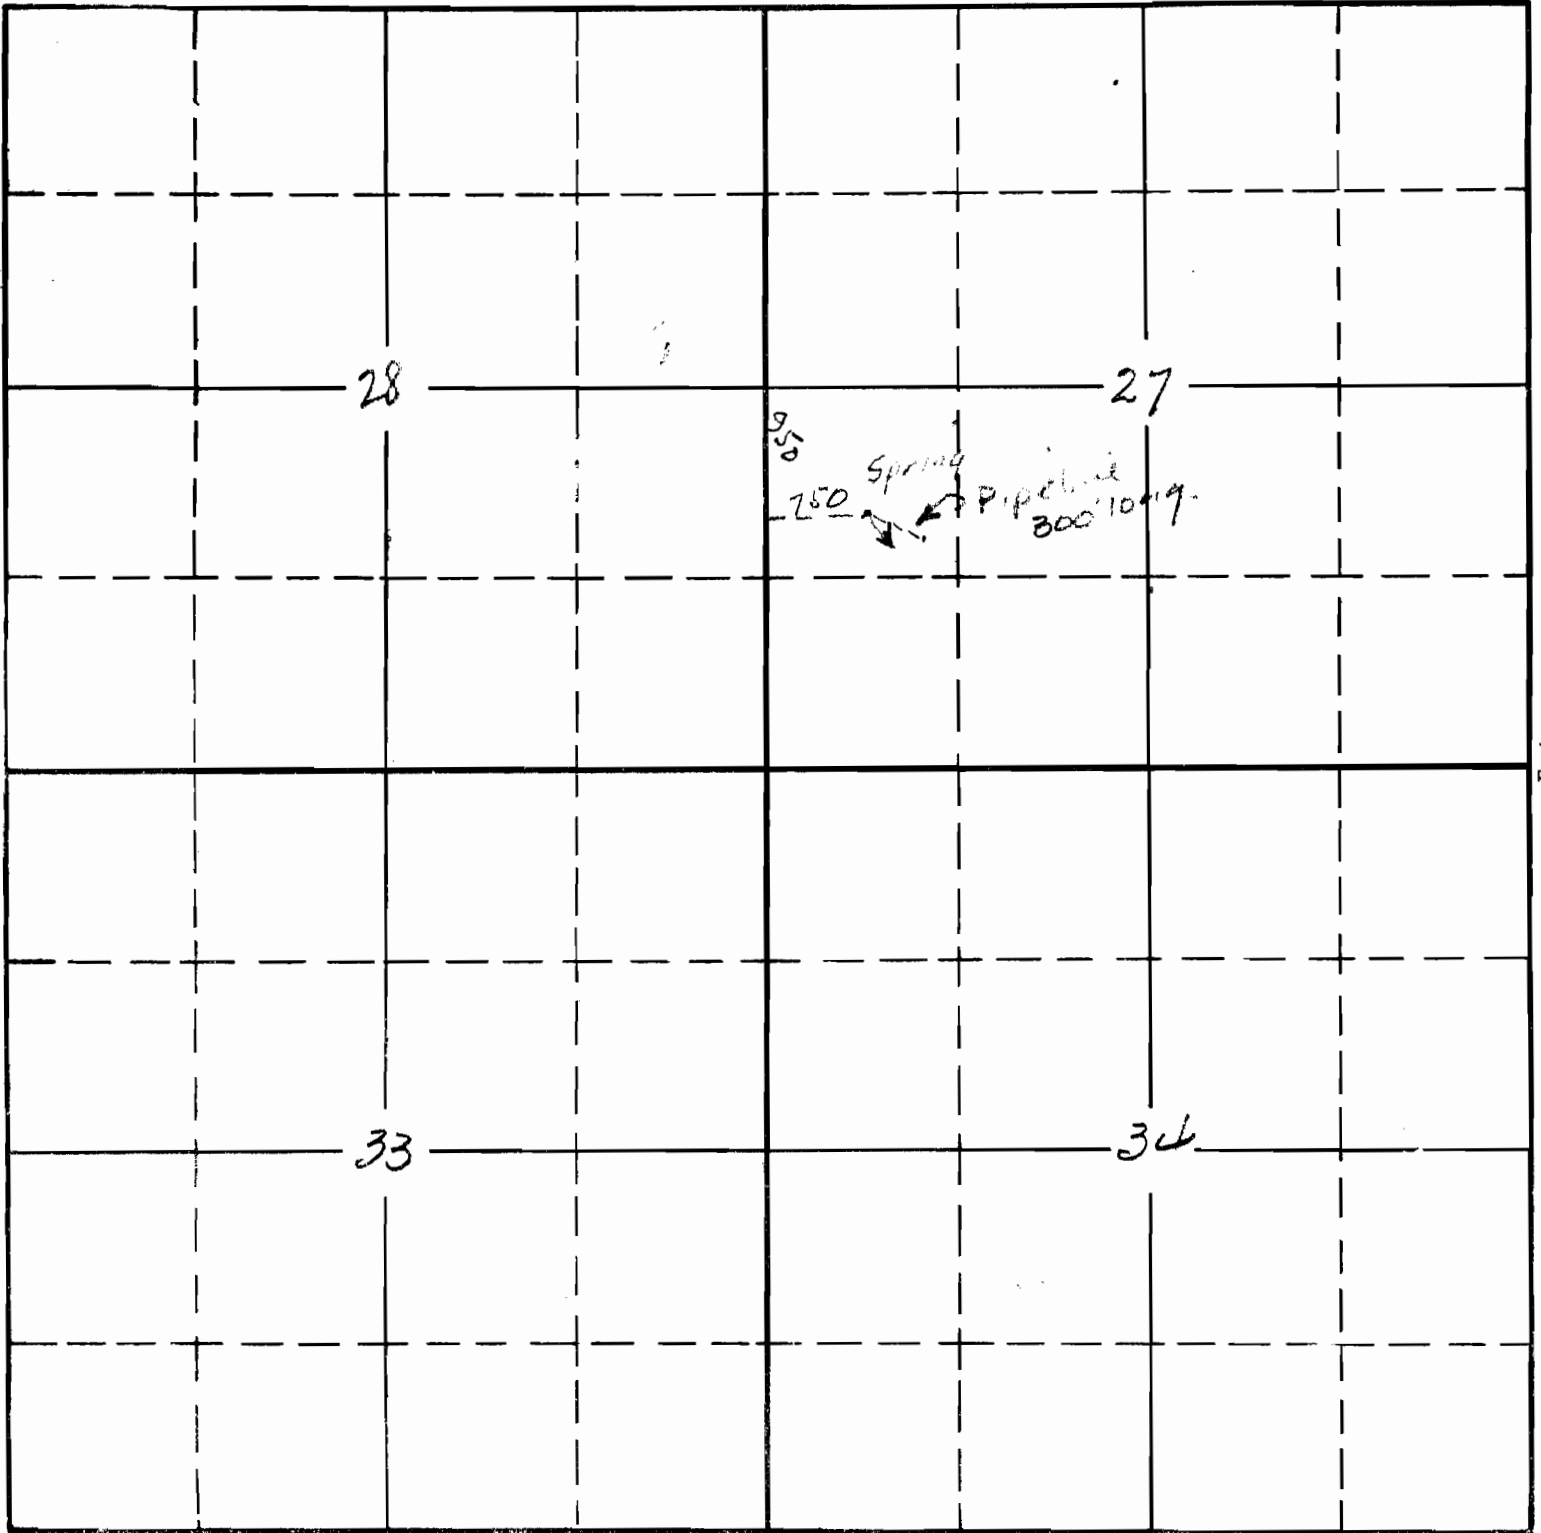

West

East

South

RECEIVED  
AUG 29 1933  
STATE ENGINEER  
SALEM, OREGON

18374 C.P.  
-25  
APPLICATION No. 18374  
PERMIT No. 14111