


SECTION

TOWNSHIP 9S, RANGE 10W, W. M.

North

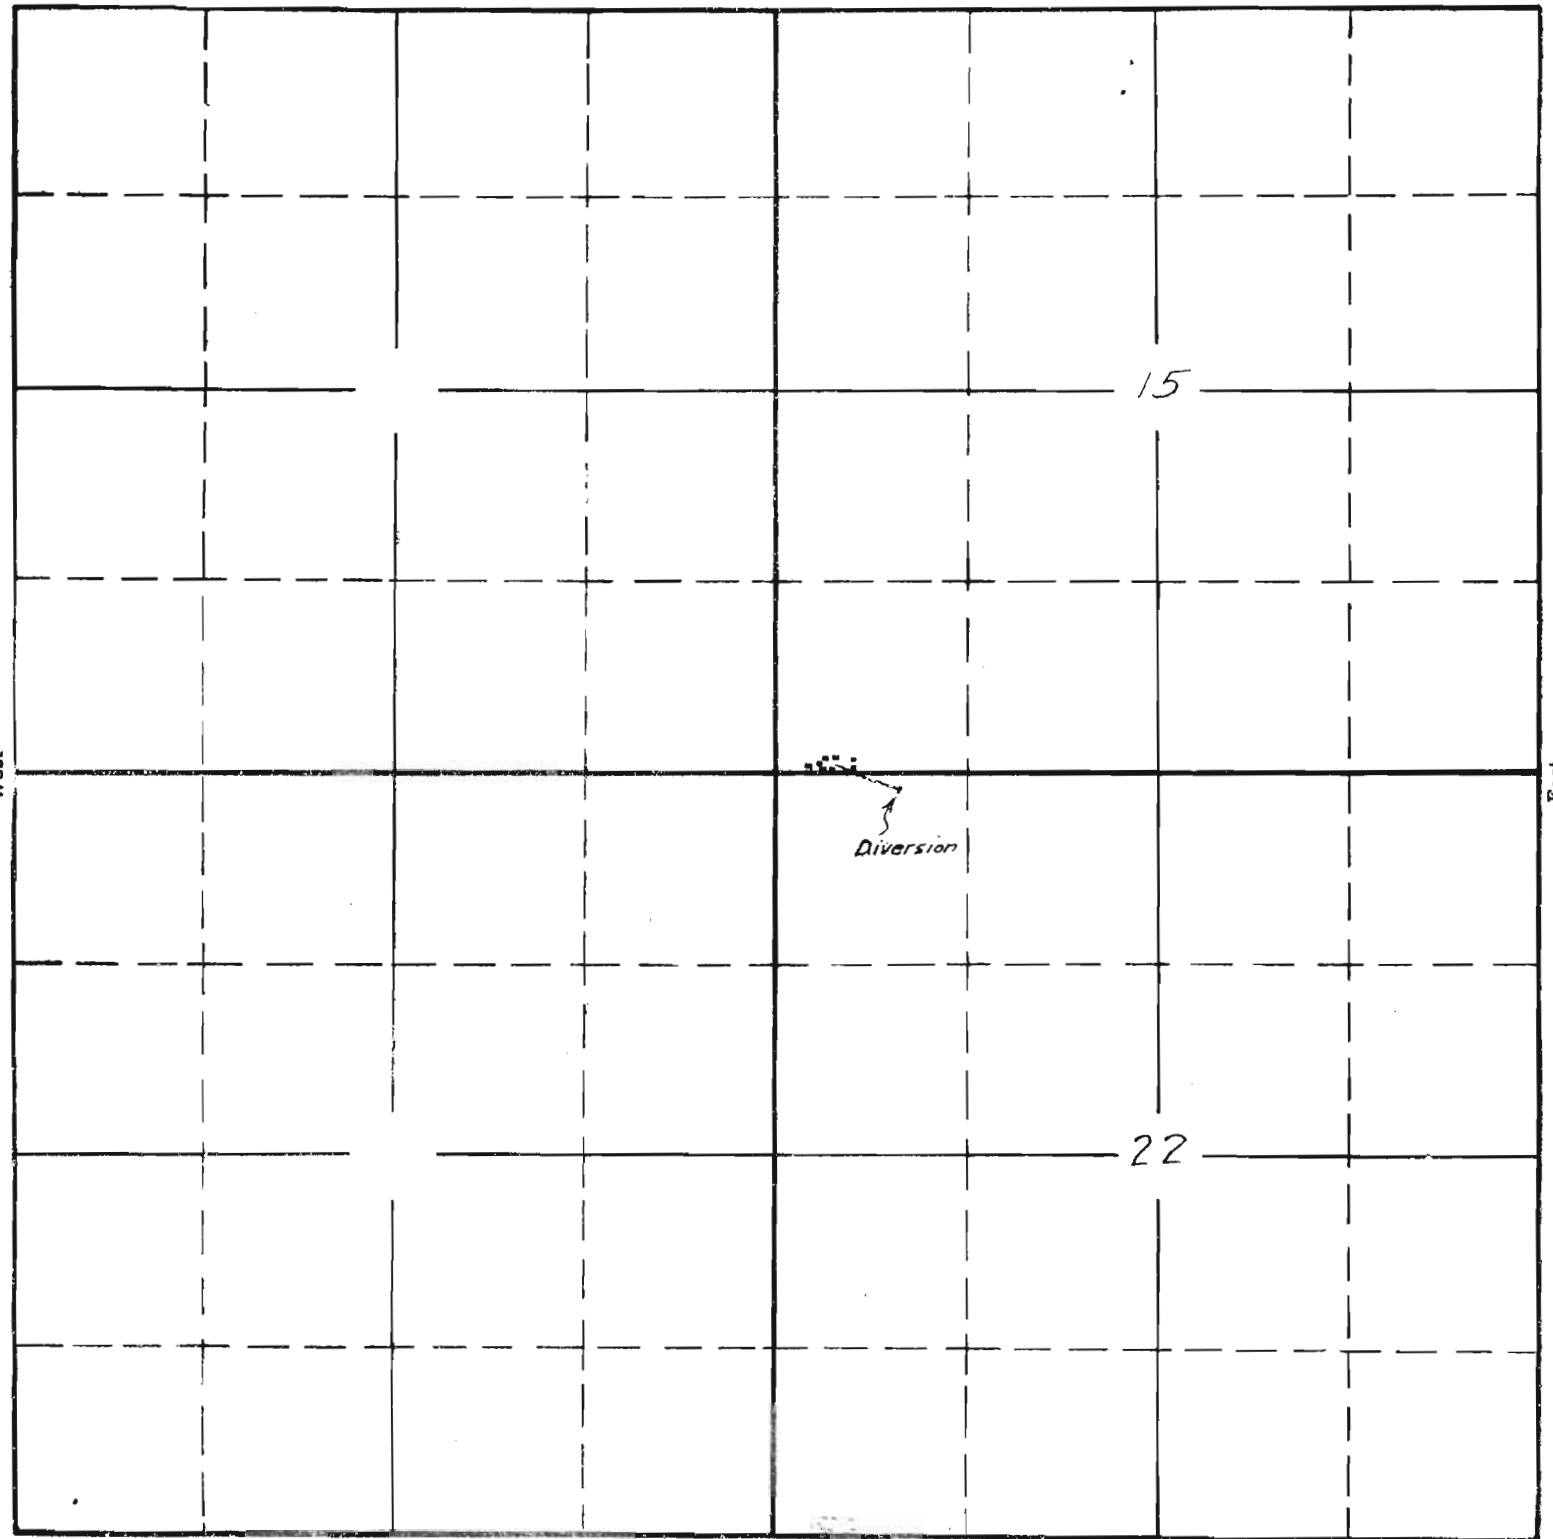

Surveyed June 27, 1940 *W.L.G.*

South

APPLICATION No. *18461*

PERMIT No. *14115*