


SECTION

TOWNSHIP 7.S., RANGE 11.W., W. M.

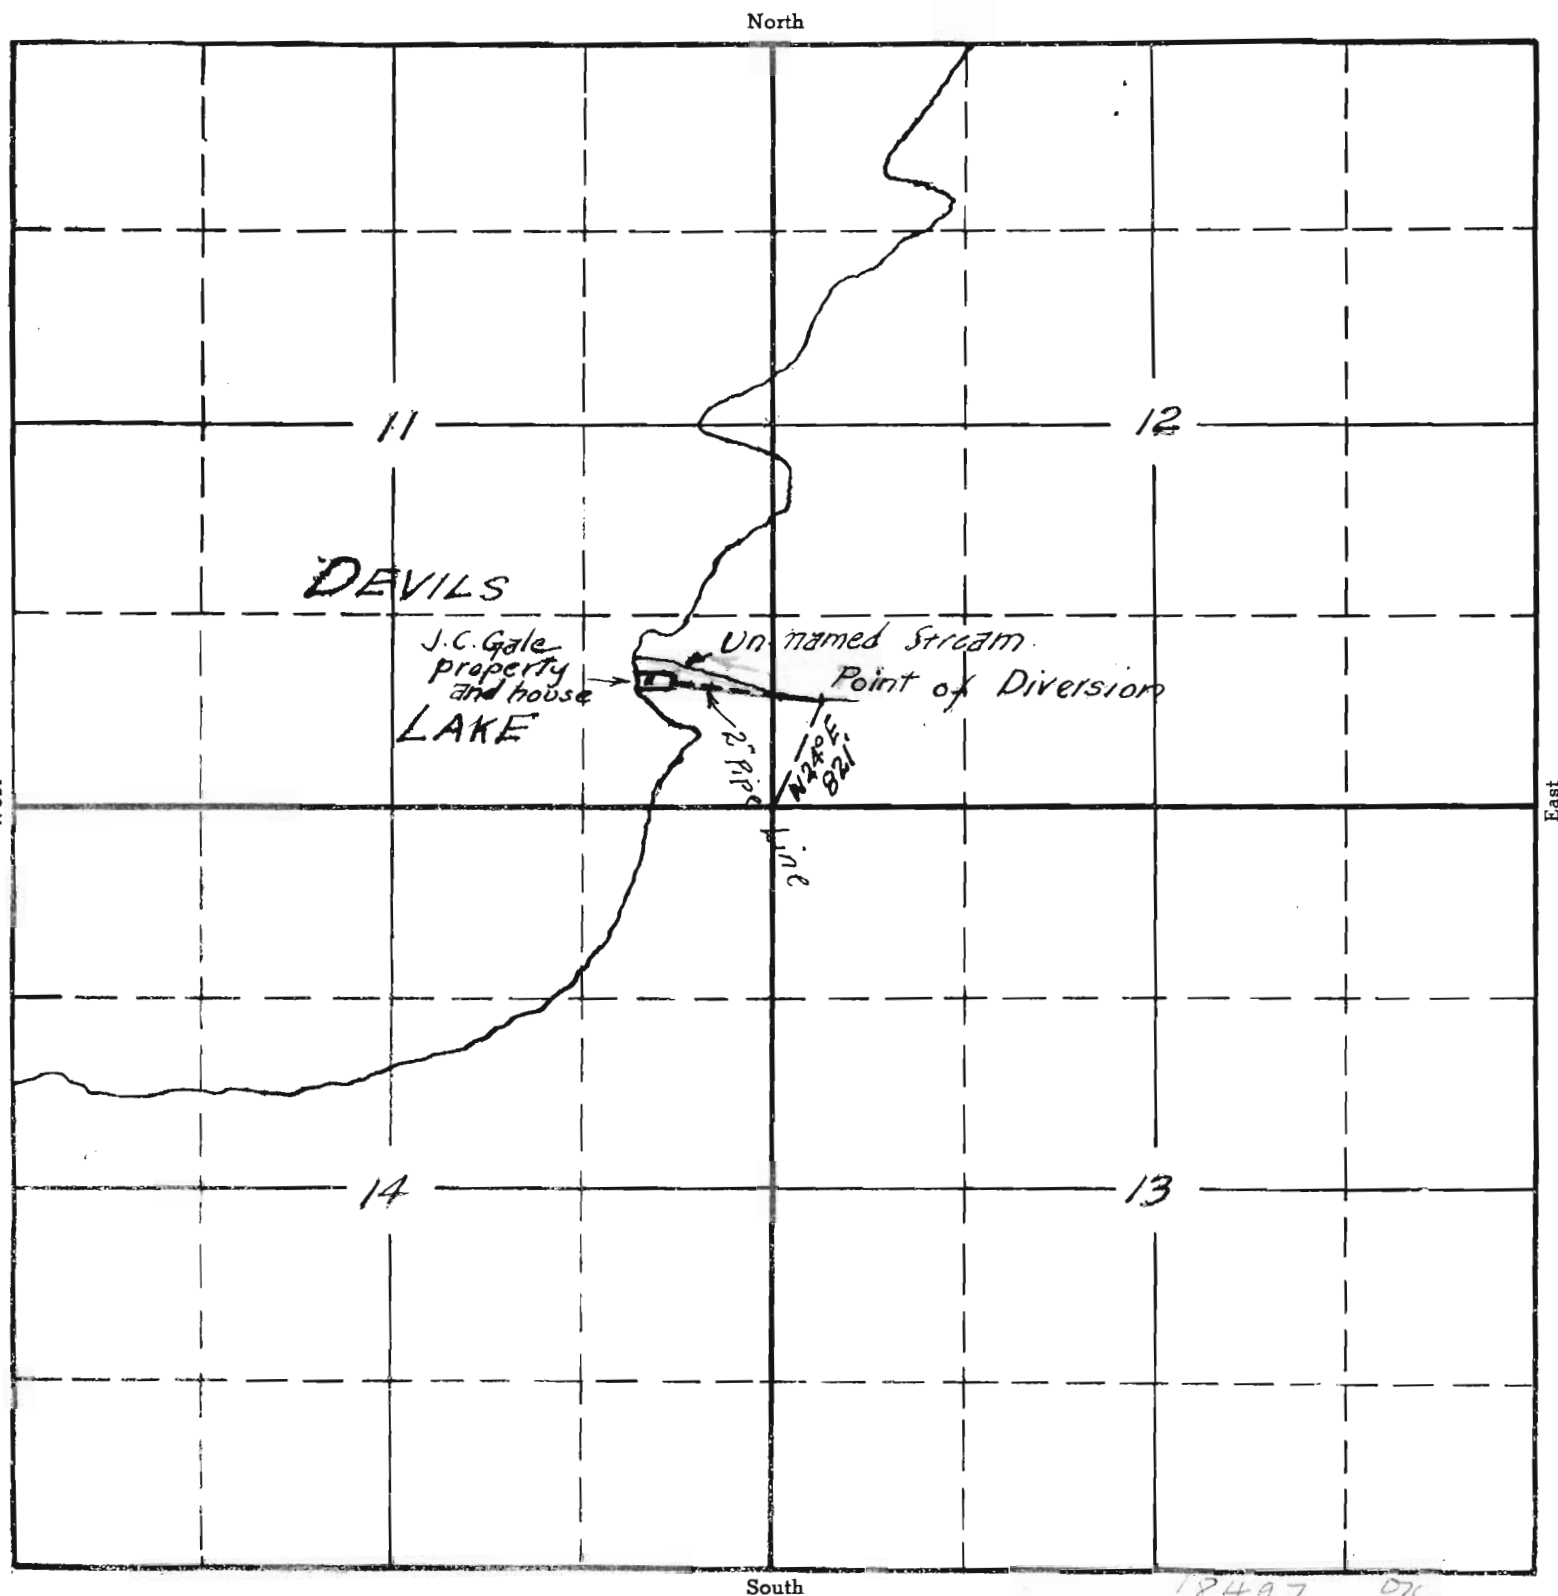

18497 OK
18-6
APPLICATION No. 18497
PERMIT No. 14117