


SECTION

TOWNSHIP 40 S, RANGE 7 W, W. M.

North

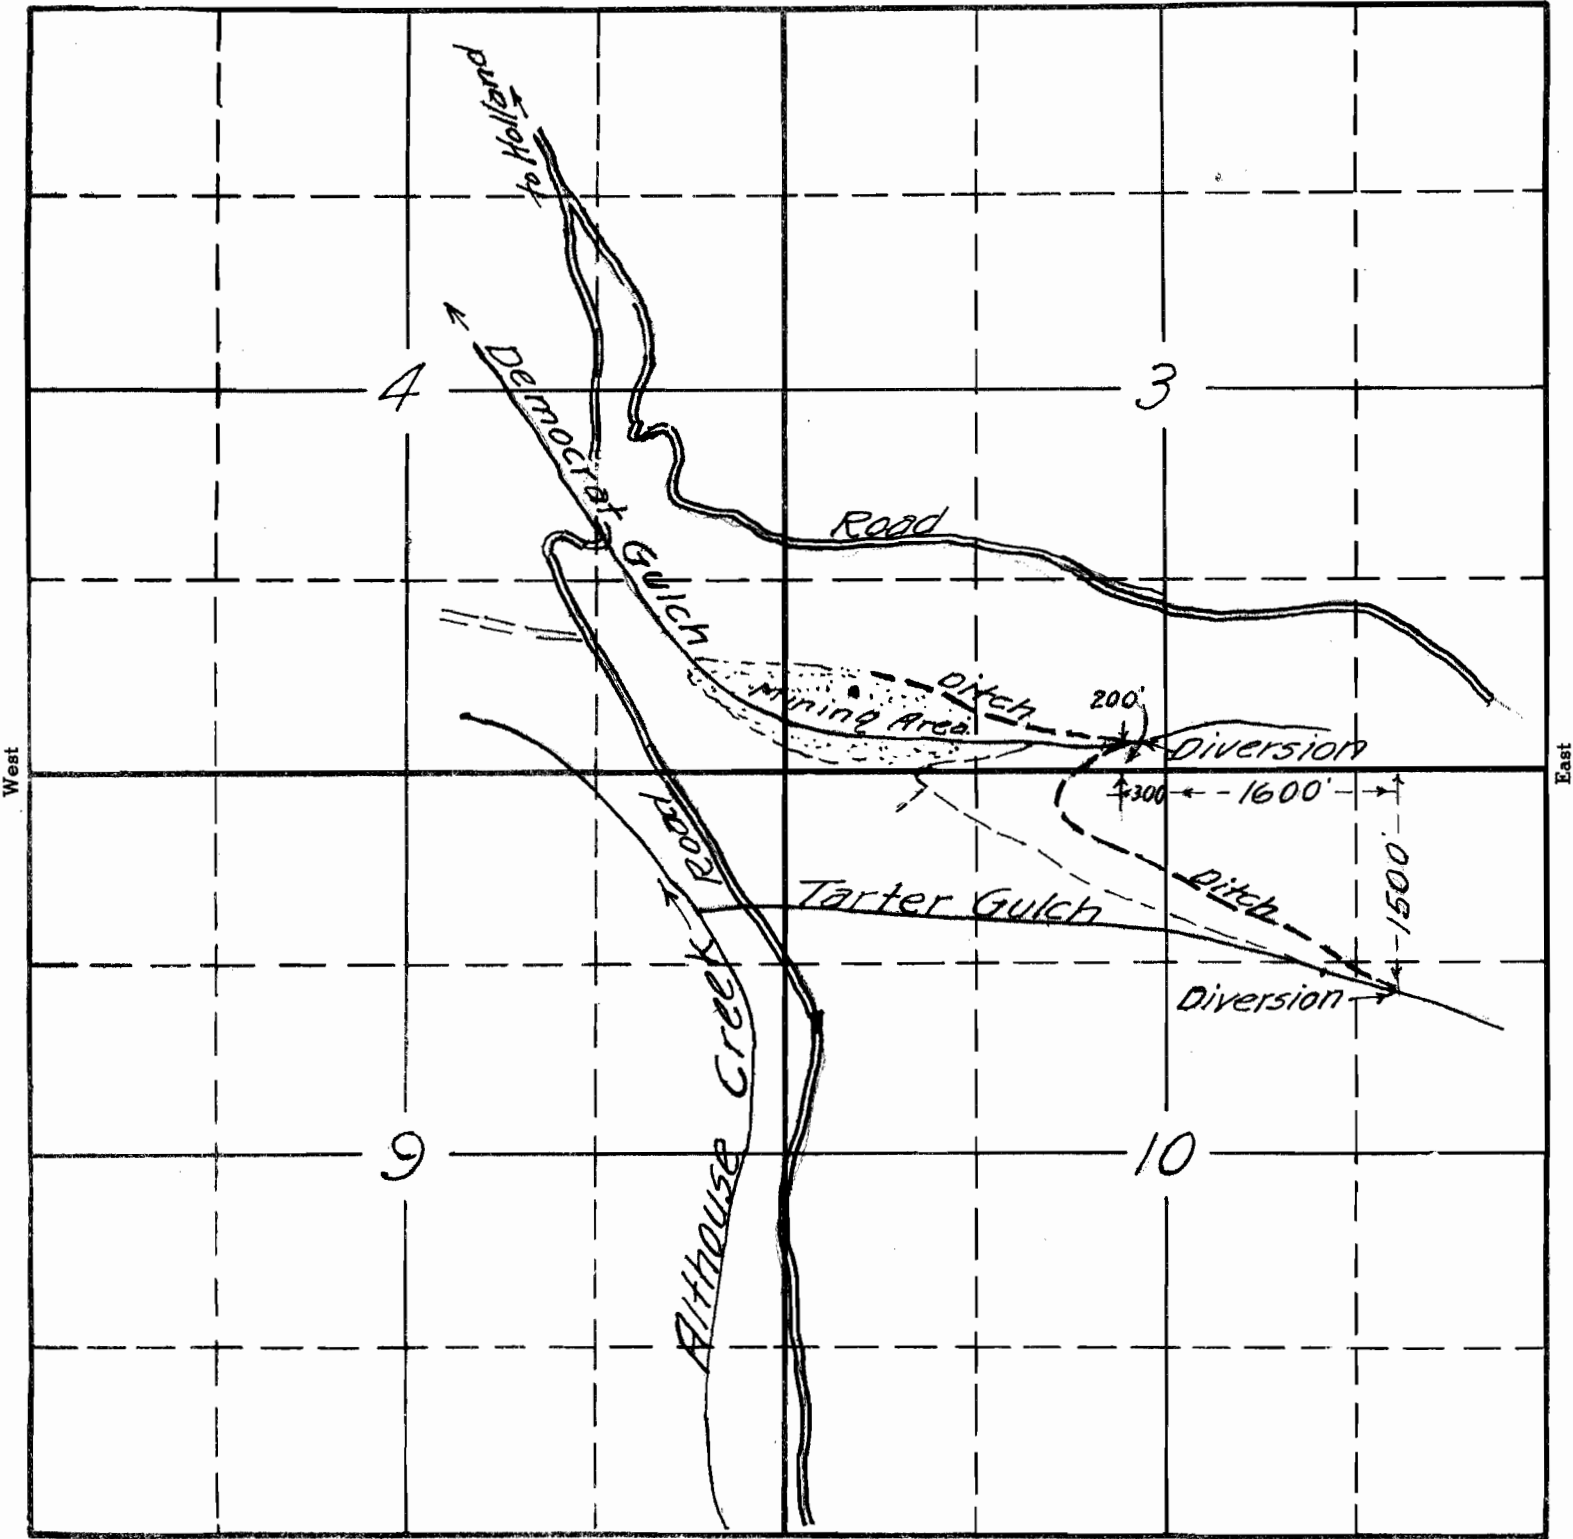

South

18517 OK
15-6

J. F. Wisecarver, Jr. APPLICATION No. 18517
Dec. 1939 PERMIT No. 14134