

SECTION


6

TOWNSHIP 37 S , RANGE 3 W , W. M.

North

West

East

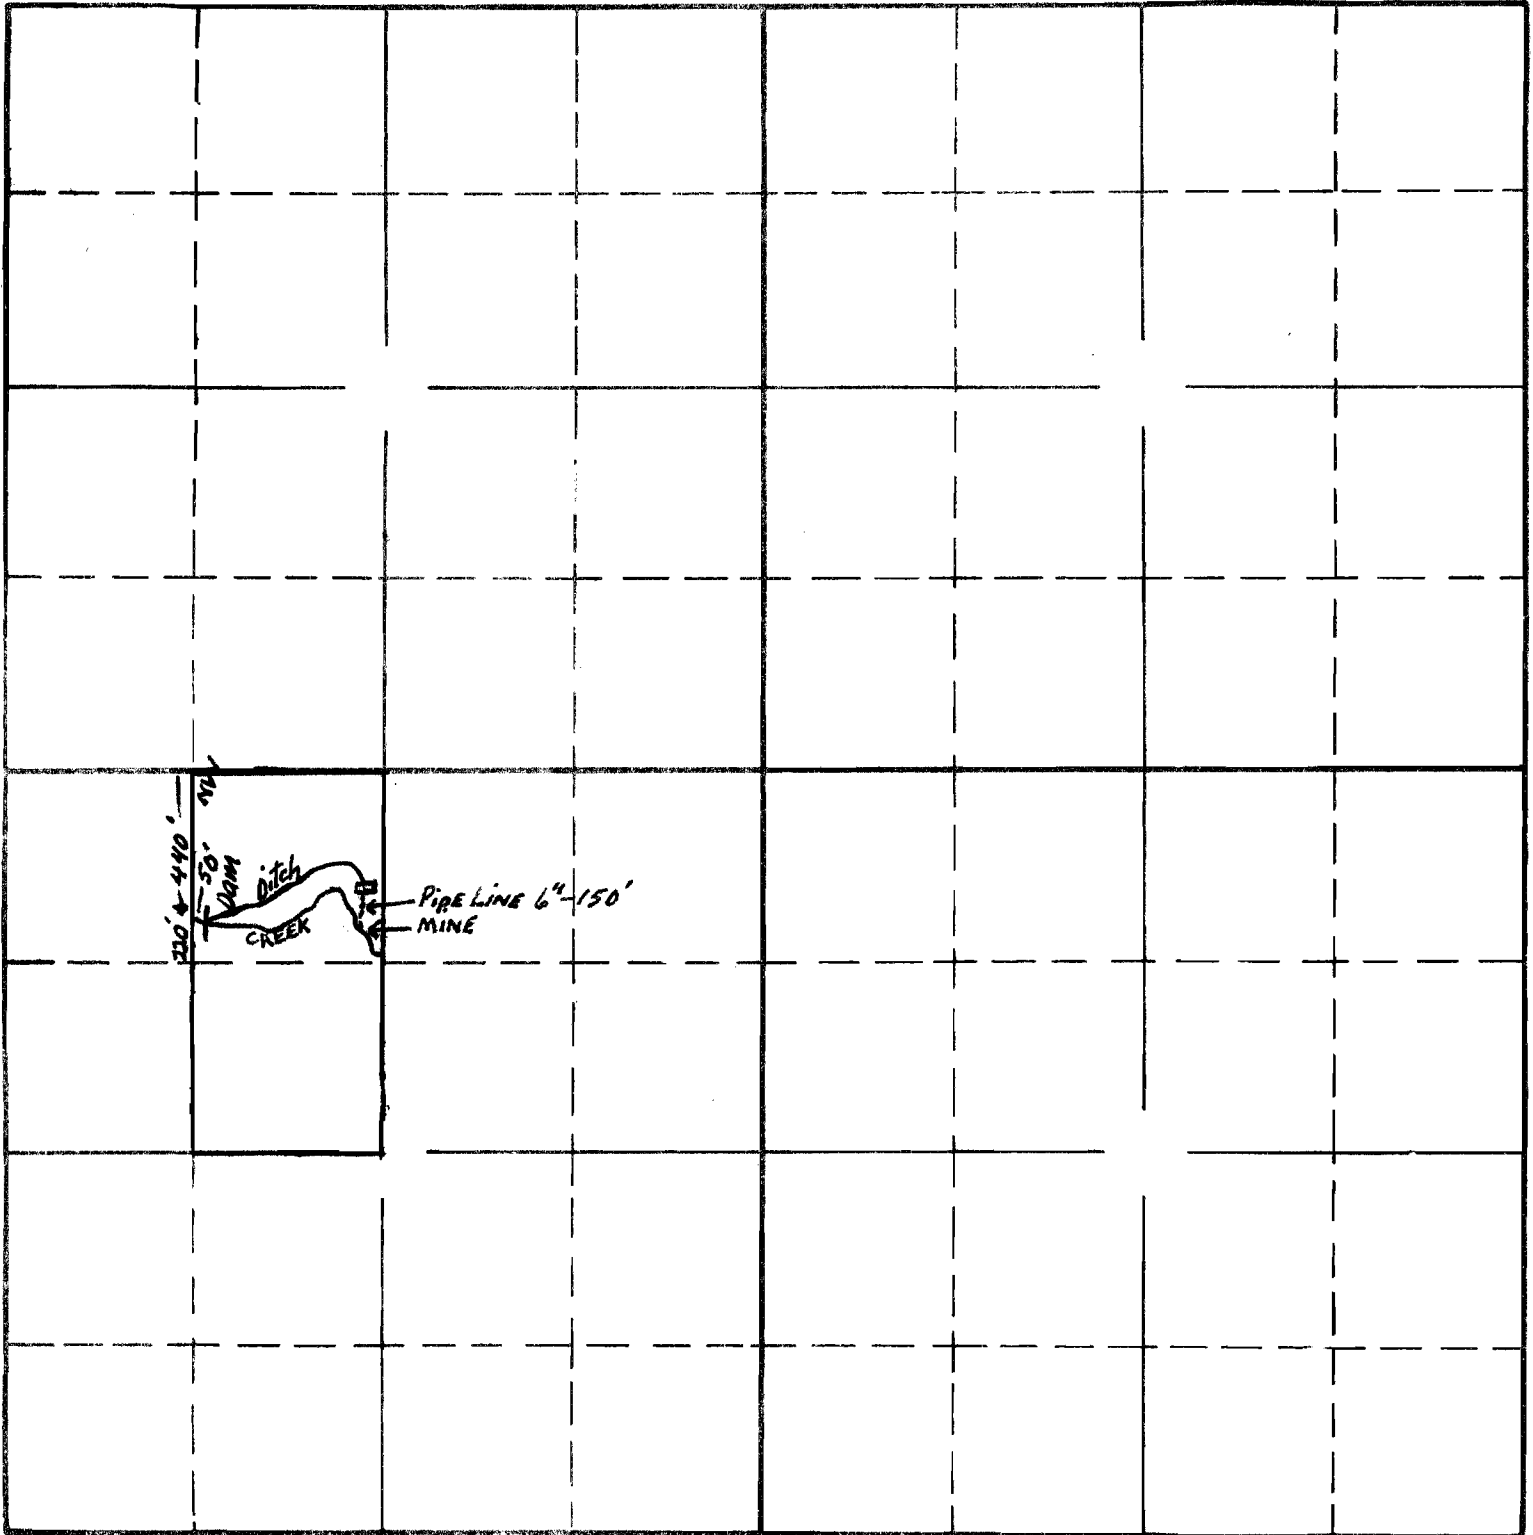

South

RECEIVED

FEB 7 1940

STATE ENGINEER
SALEM, OREGON

APPLICATION No. 18572

PERMIT No. 1438