


North

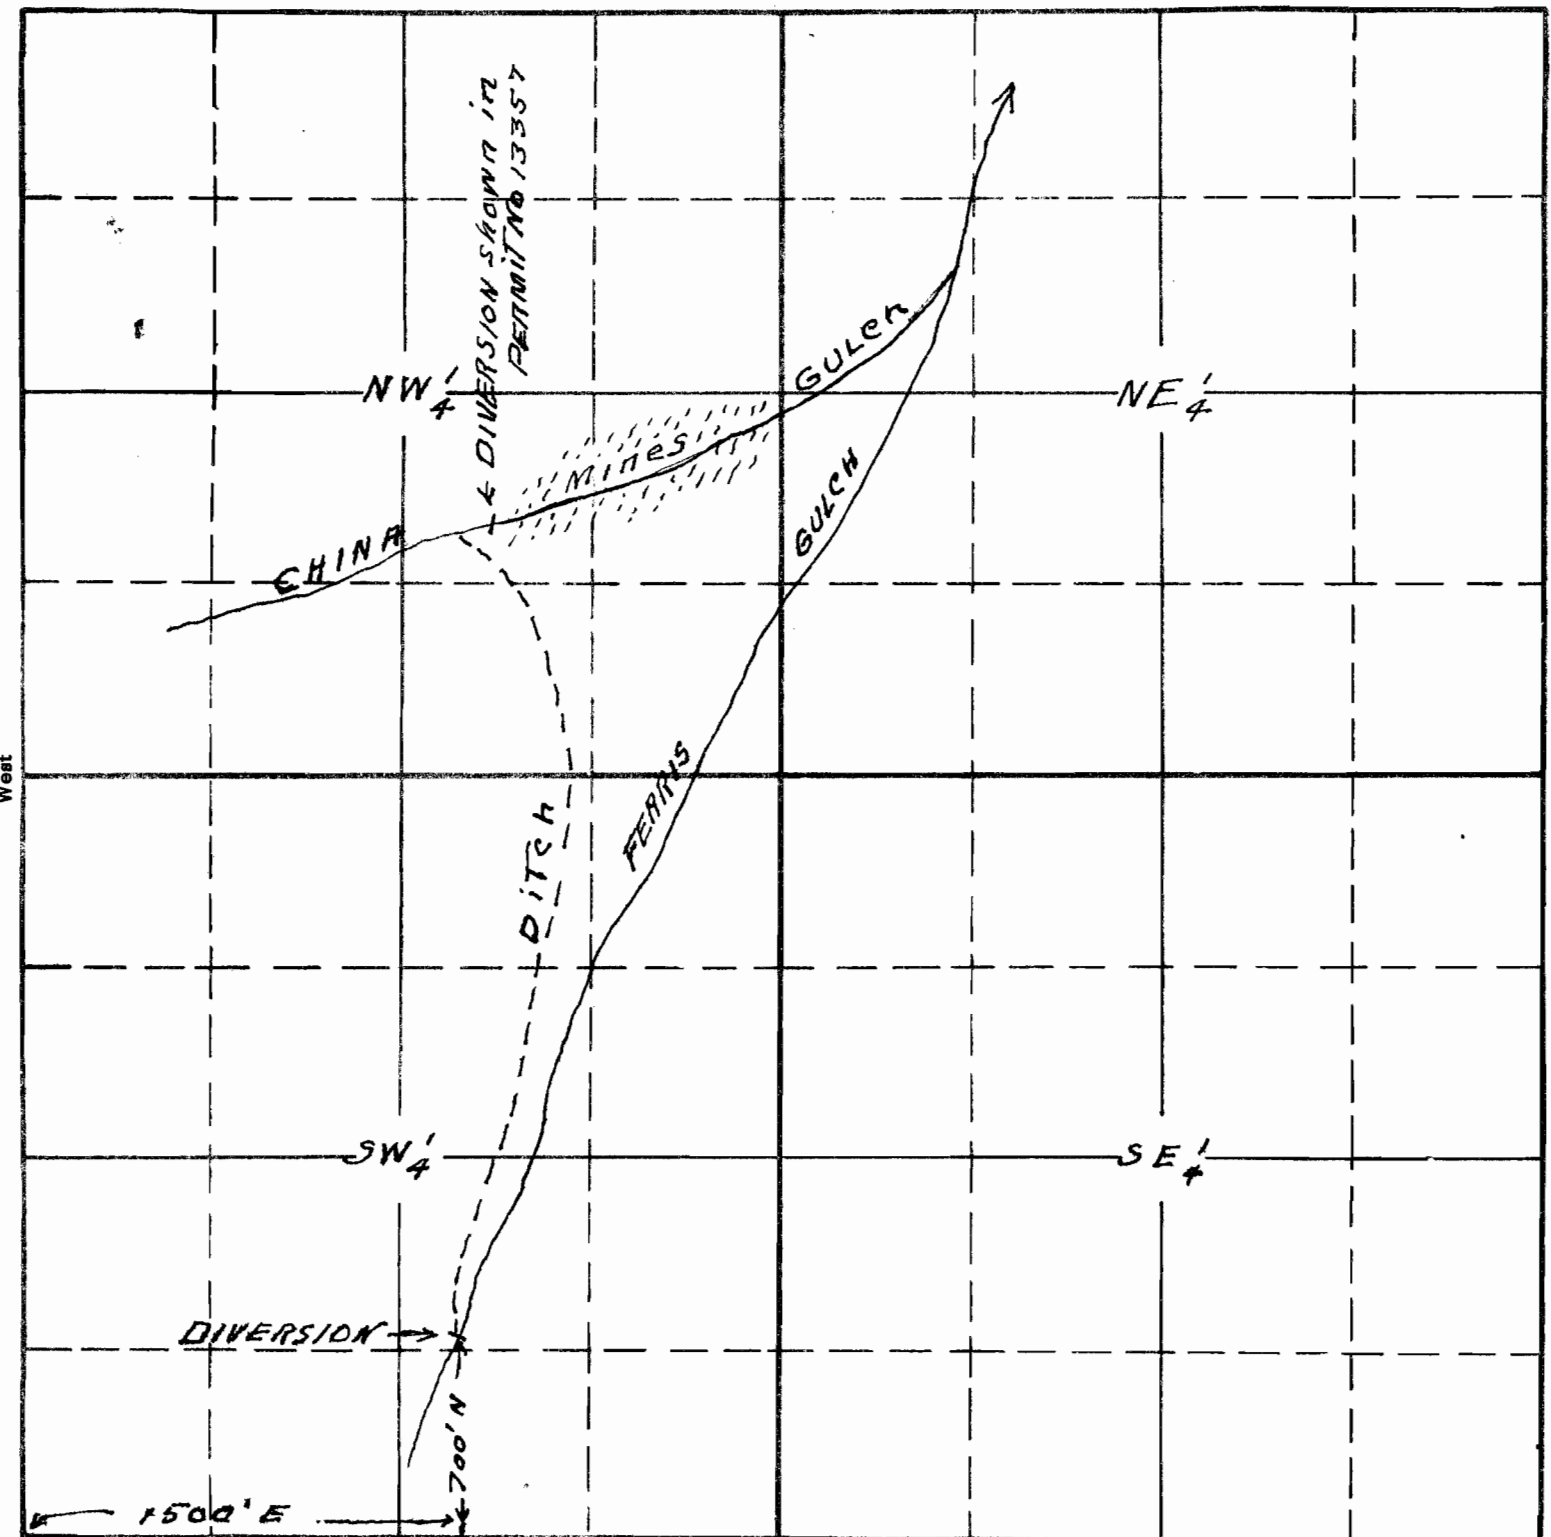

Sketch to accompany application of  
 G. V. Howard for use of 2.0 cts. of  
 Waters of FERRIS GULCH for mining.  
 Measurements made by G. V. H.

18574 EX  
 15-16 A  
 APPLICATION No. 18574  
 PERMIT No. 14139

This office 1/7/40 C. P. Smith