

SECTION

23

24

26

This Map traced from Assessors Map
Douglas Co. Court House.

TOWNSHIP 29S, RANGE 5W, W. M.

North

RECEIVED

DEC 13 1939

STATE ENGINEER
SALEM, OREGON

23

24

South Myrtle Road

95

05

Land to be Irrigated 12 Acres

South Myrtle Creek

Point of Diversion

Point of Location

20

26

25

South

18490 OR
16-35

APPLICATION No. 18490

PERMIT No. 14156

Location of Point of Diversion
as located by County Engineer
in Application of Noah Sellers in

1929 - This applicant to use opposite or North Bank of
South Myrtle Creek


West

East

SECTION

TOWNSHIP 295, RANGE 5W, W. M.

North

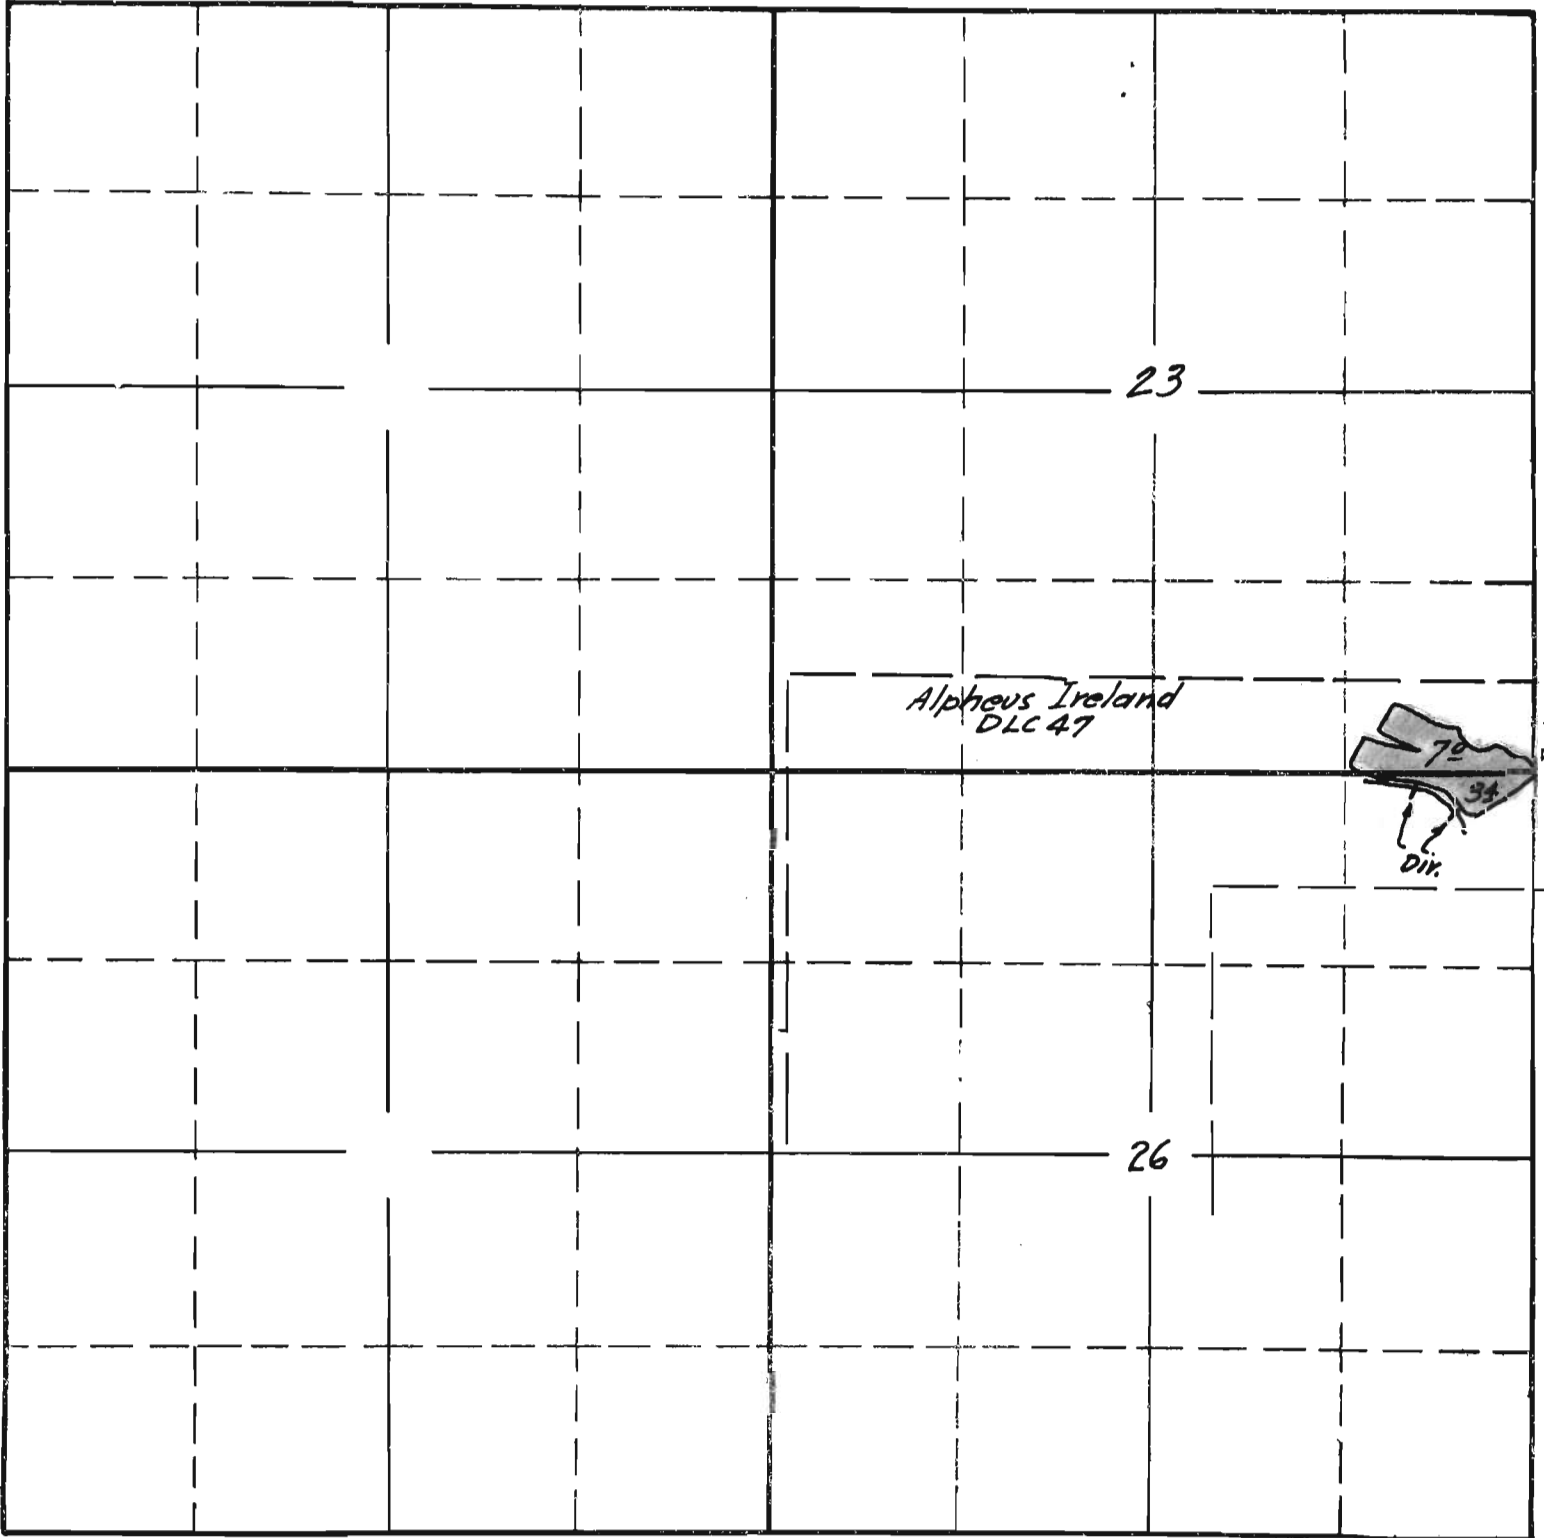

Surveyed June 9, 1941
C.A.B.

South

APPLICATION No. 18490
PERMIT No. 14156