


8

North

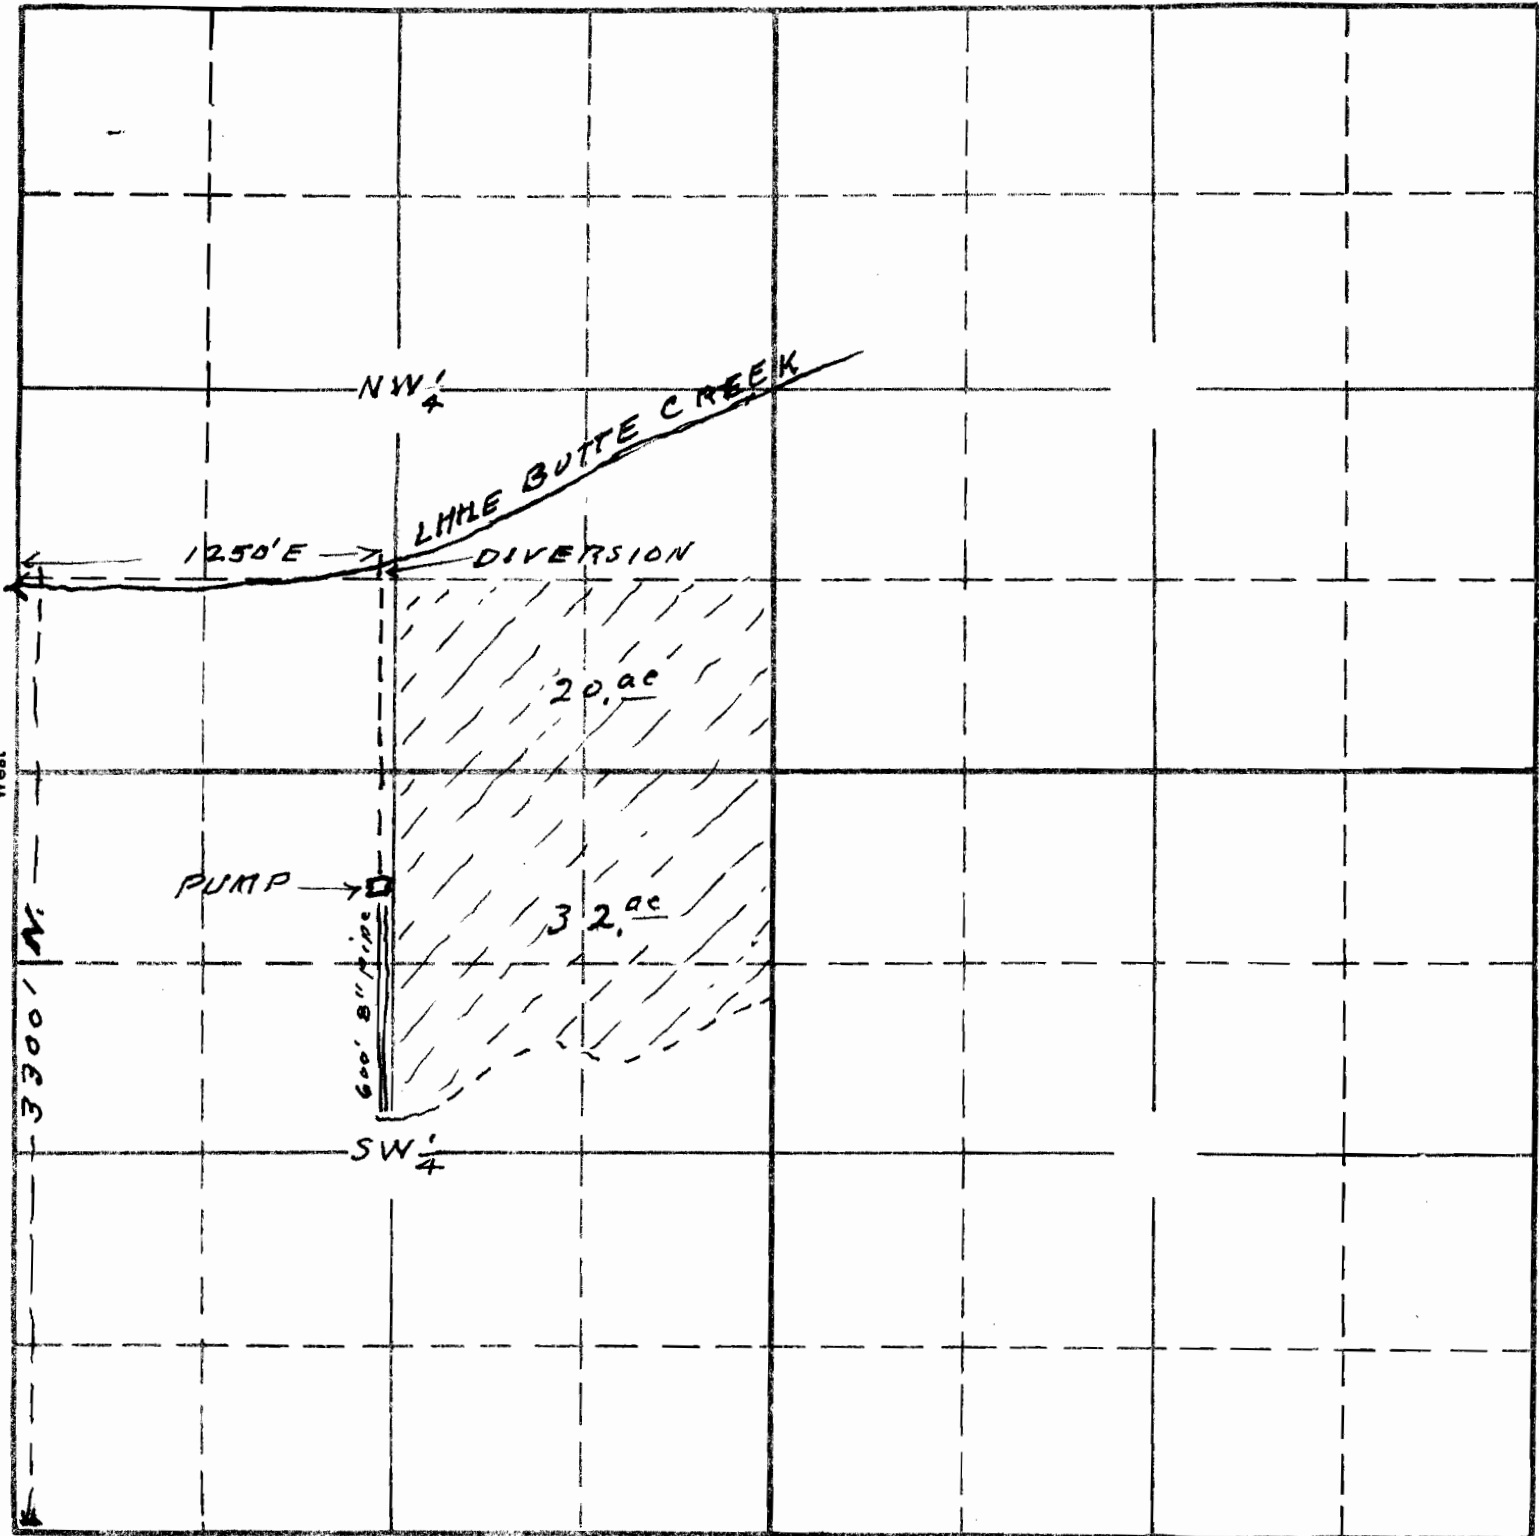

Sketch showing diversion of ^{South} stream and lands to be irrigated as shown in application of I. R. and Luella D. Kline from Little Butte Creek

APPLICATION No. 18561
 PERMIT No. 14183

This office 1/30/40 @ Smith