

MAP TO ACCOMPANY FINAL PROOF OF  
 BEN ALFONSO, FOR USE OF WATER FROM  
 W.F. EVANS CREEK FOR IRRIGATION PURPOSES.

MAP COPIED FROM PLANE TABLE  
 SURVEY - MADE 1-7-55.

David L. Hendrix

WATERMASTER DIST. NO. 15

APPLICATION No. 18596

PERMIT No. 14195

RECEIVED  
 JUN 18 1955  
 STATE ENGINEER


SECTION

23  
24  
25

7210  
7210A

TOWNSHIP 34S, RANGE 3 W, W. M.

North

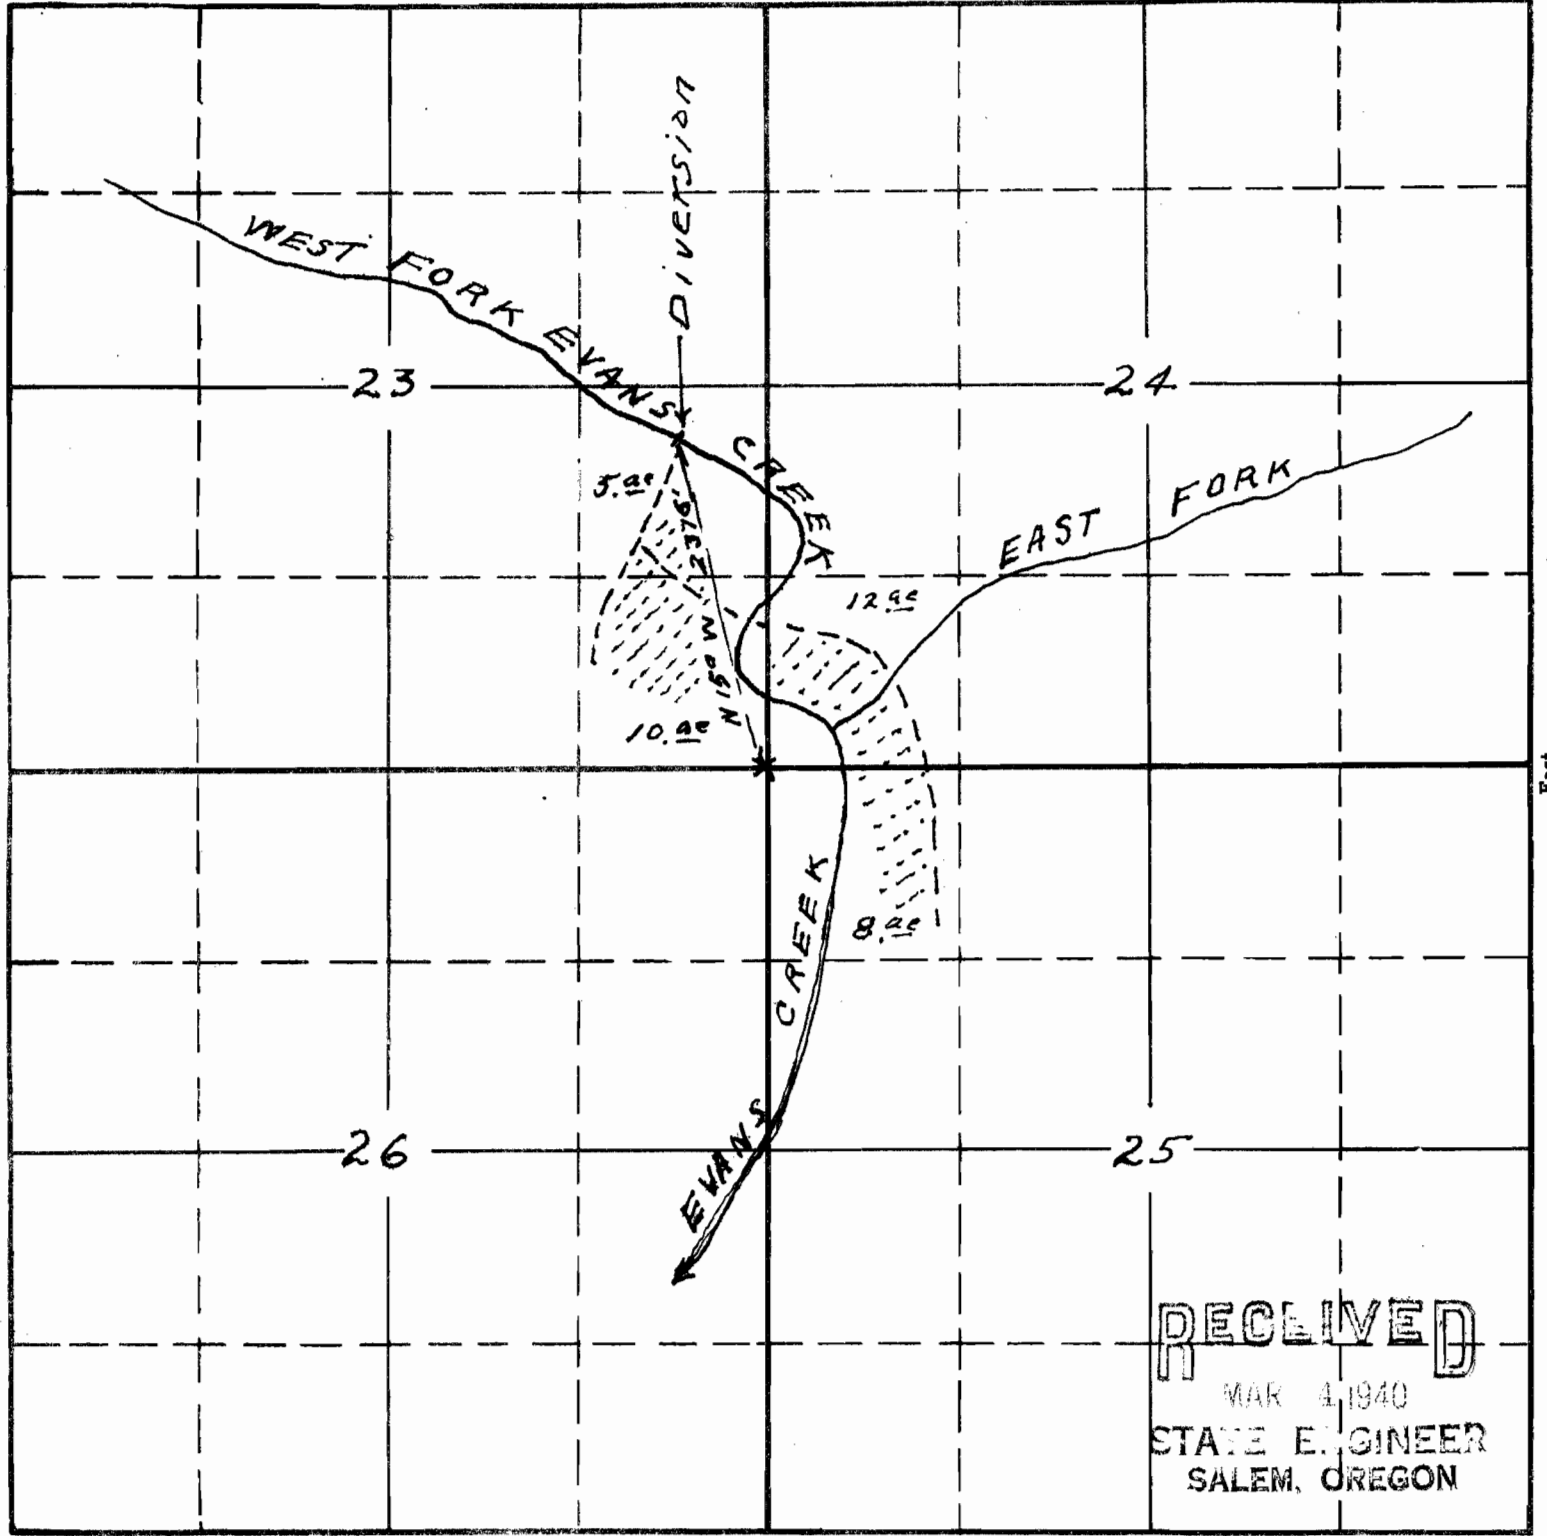

**RECEIVED**  
 MAR 4 1940  
 STATE ENGINEER  
 SALEM, OREGON

South  
 Sketch to accompany application of  
 C.F. Angle for permit to use waters  
 of West Fork of Evans Creek for  
 irrigation purposes

18596 OK  
 15-41  
 APPLICATION No. 18596  
 PERMIT No. 14195

This office 3/2/40 *Ch...*