


29

TOWNSHIP 32S, RANGE 3E, W. M.

North

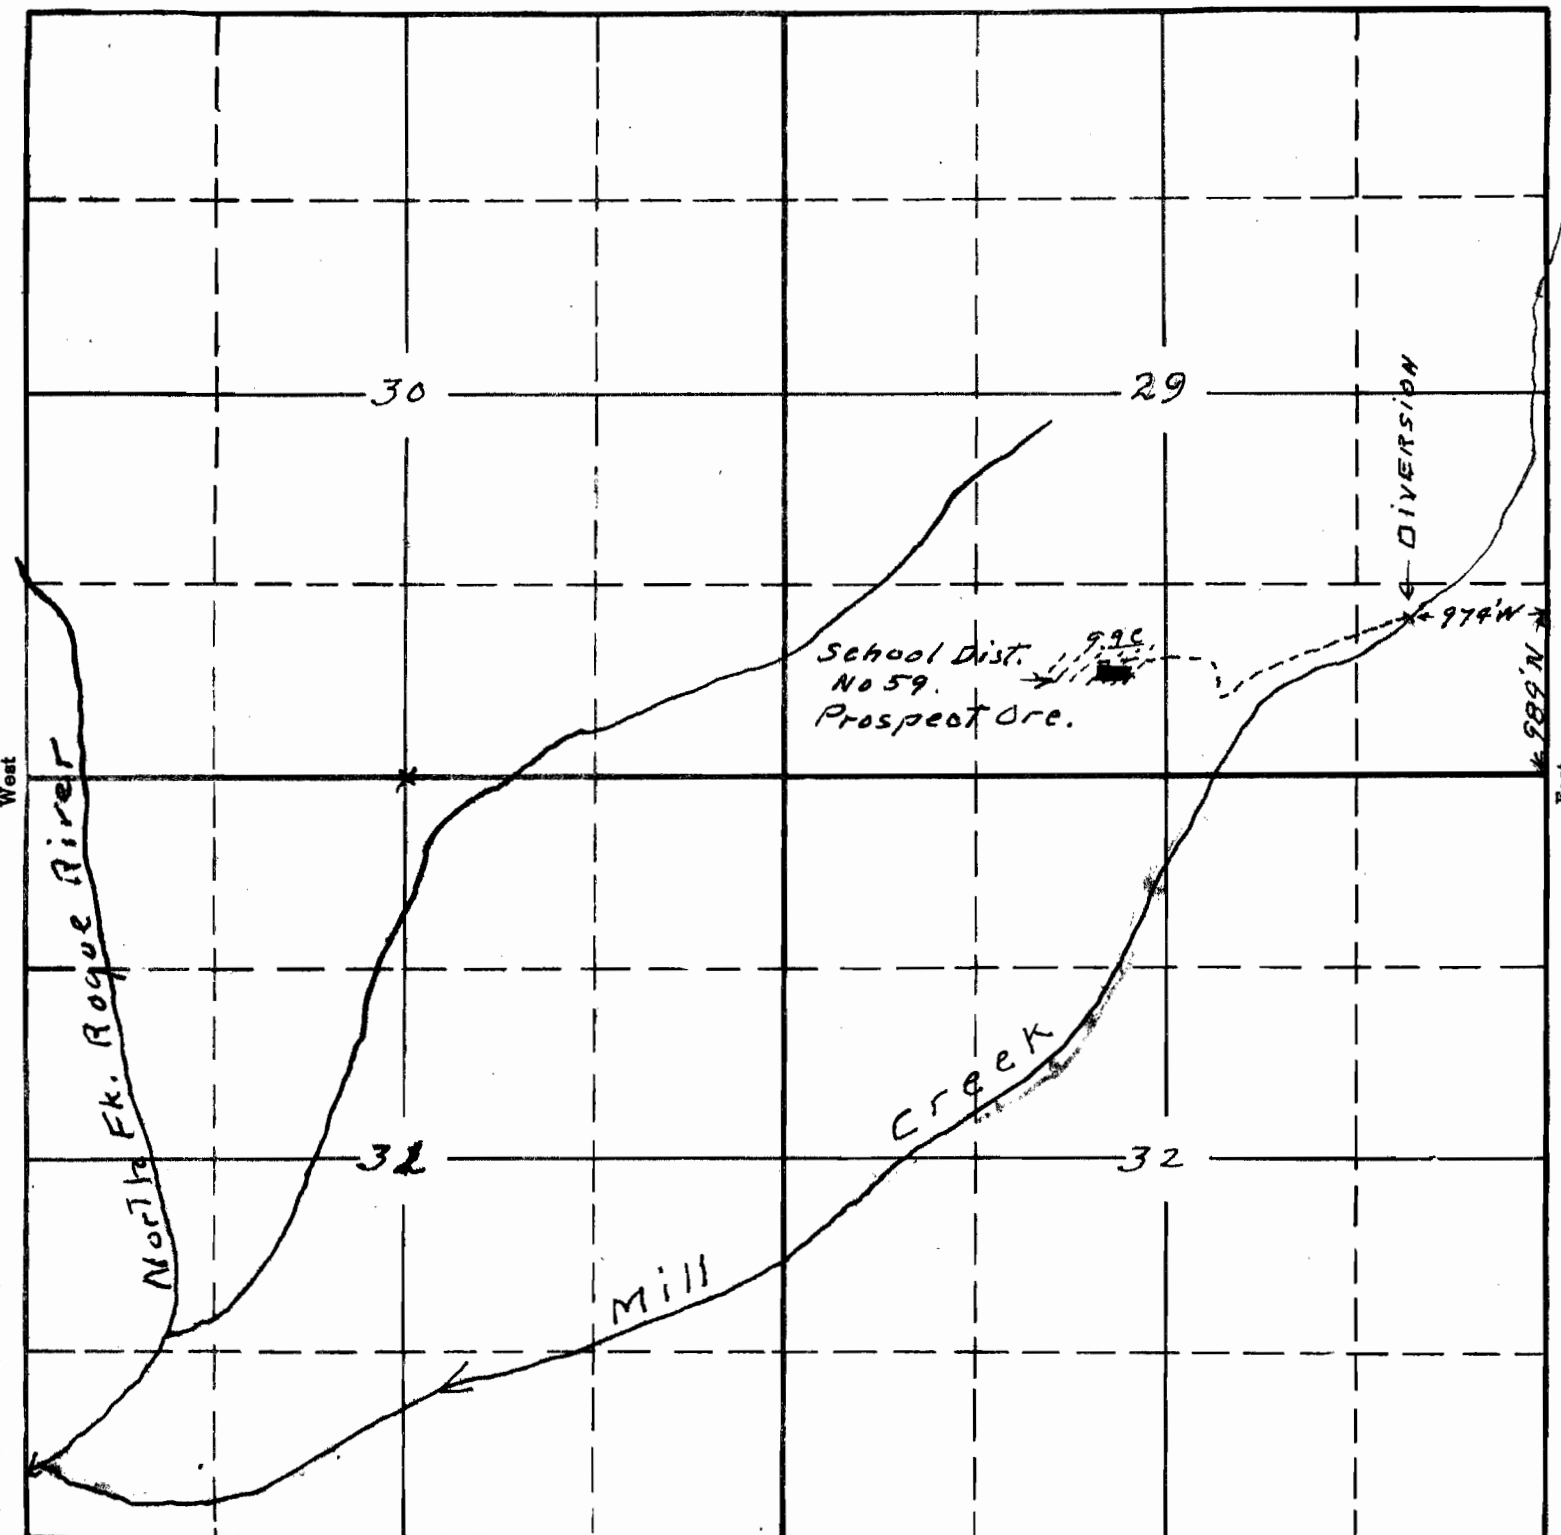

Map to accompany application of  
 School Dist. 59 of Prospect Ore.  
 H. L. Carlton Chairman of the Board,  
 for irrigation, fire protection, school use  
 and power for ram

18509 01  
 15-17  
 APPLICATION No. 185-09  
 PERMIT No. 14229

This office 12/15/39 El Smith