


SECTION

TOWNSHIP 34S, RANGE 4W, W. M.

North

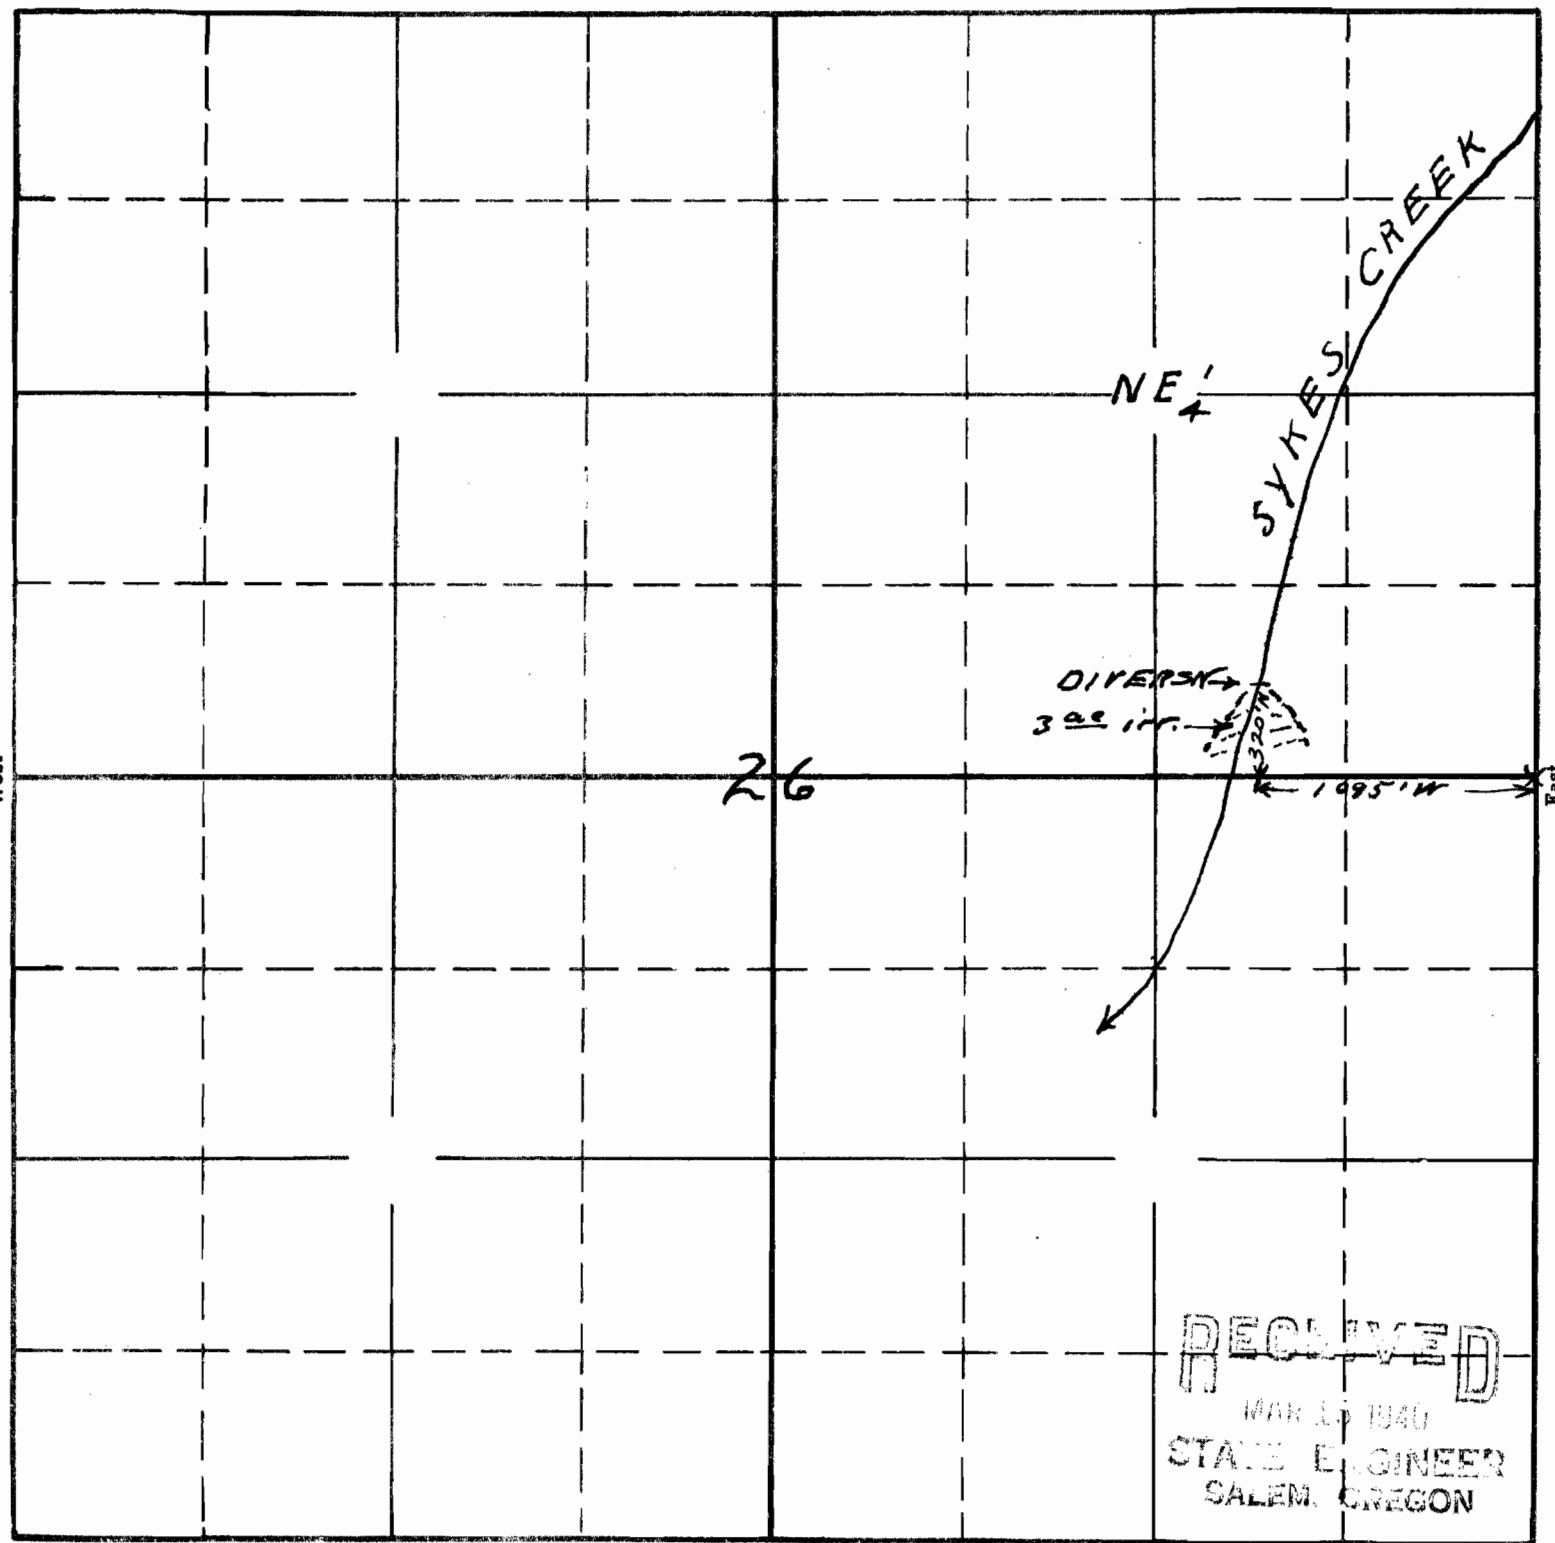

RECEIVED
 MAR 10 1940
 STATE ENGINEER
 SALEM, OREGON

To accompany application of Benjamin M Horst for use of waters of Sykes Creek for irrigation purposes.

18613 OK
 15-41
 APPLICATION No. 18613
 PERMIT No. 14251

This office 3/14 Smith