


ION


North

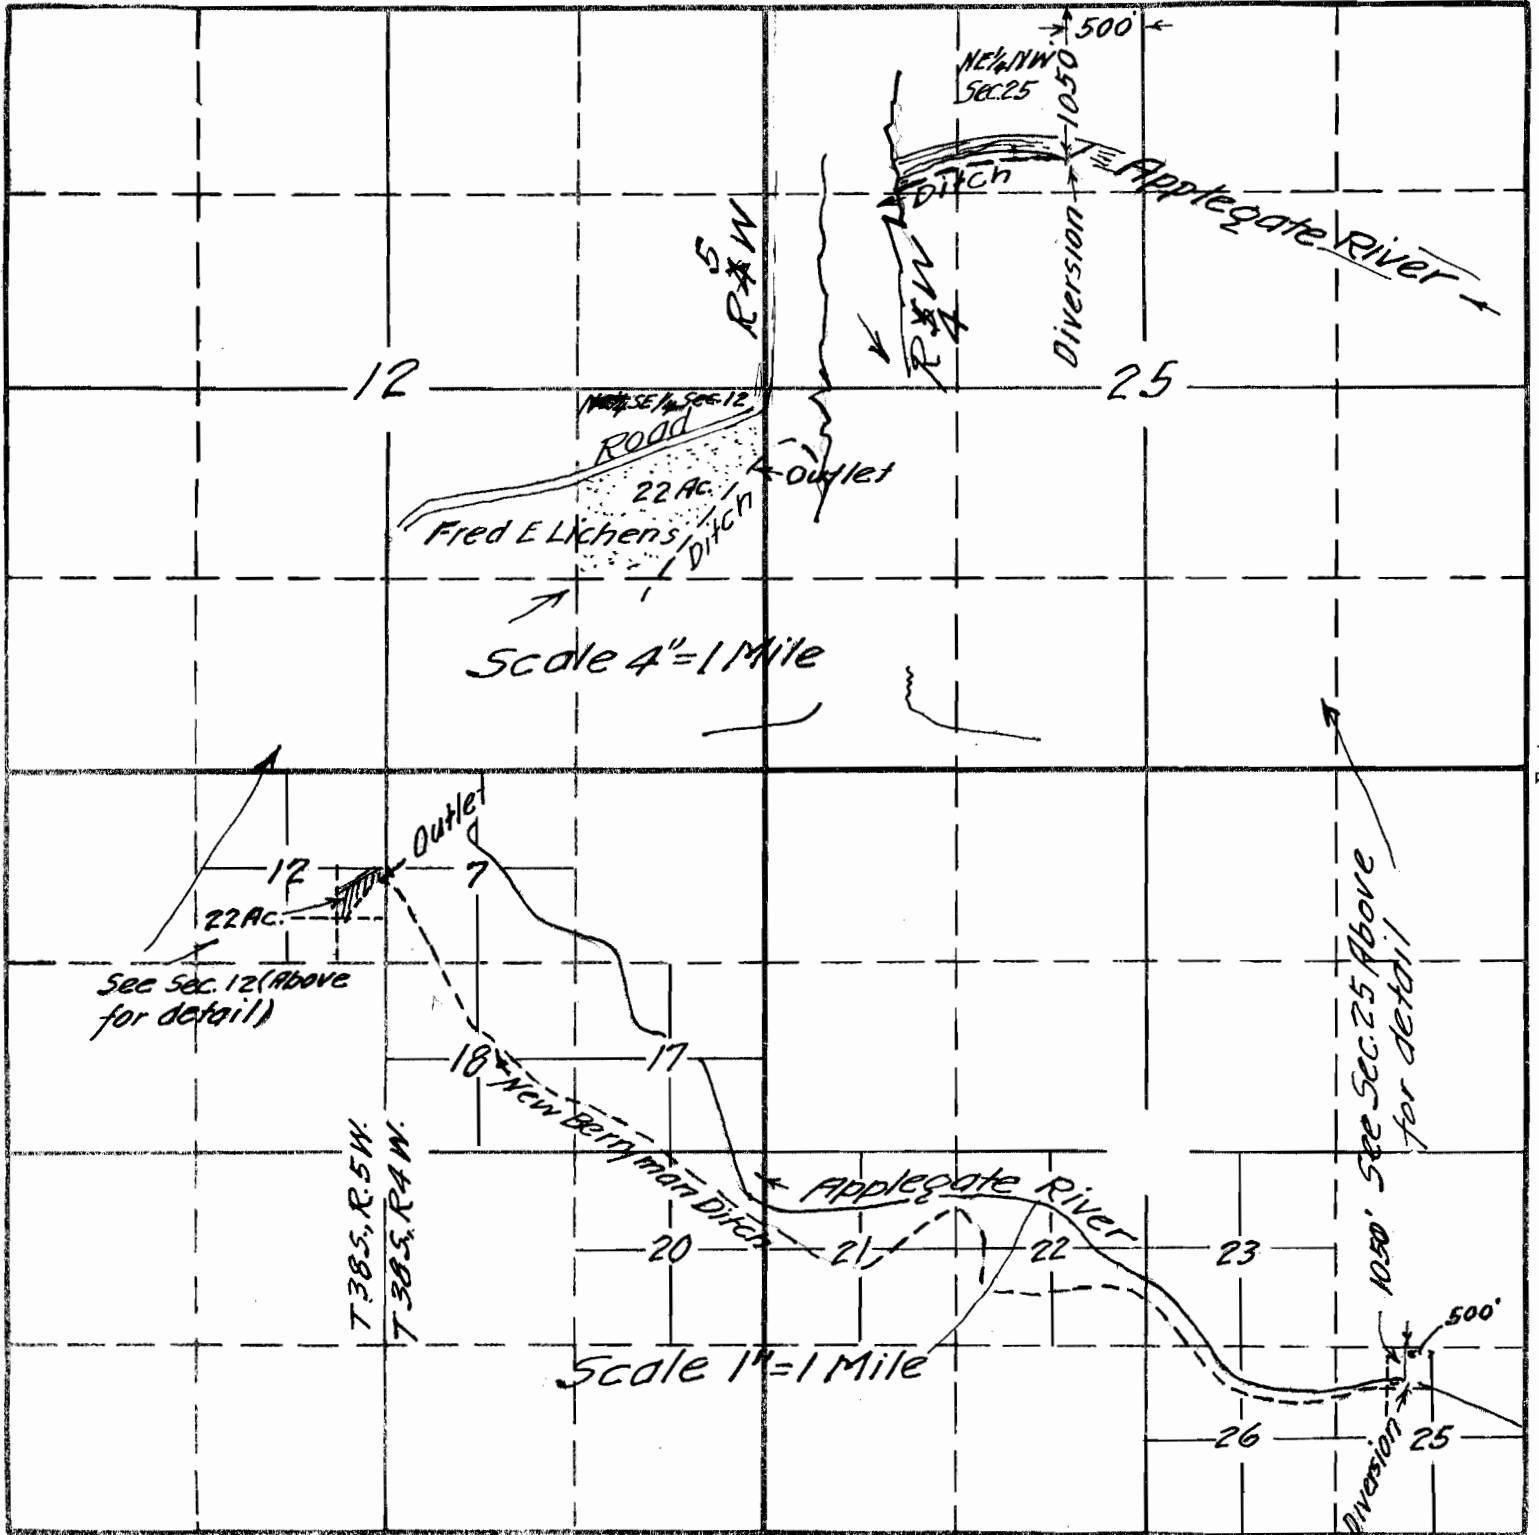

South

RECEIVED

APR 15 1940



STATE ENGINEER
SALEM, OREGON

Fred E Lichens
April 1940

APPLICATION No. 18659

PERMIT No. 14291

18757

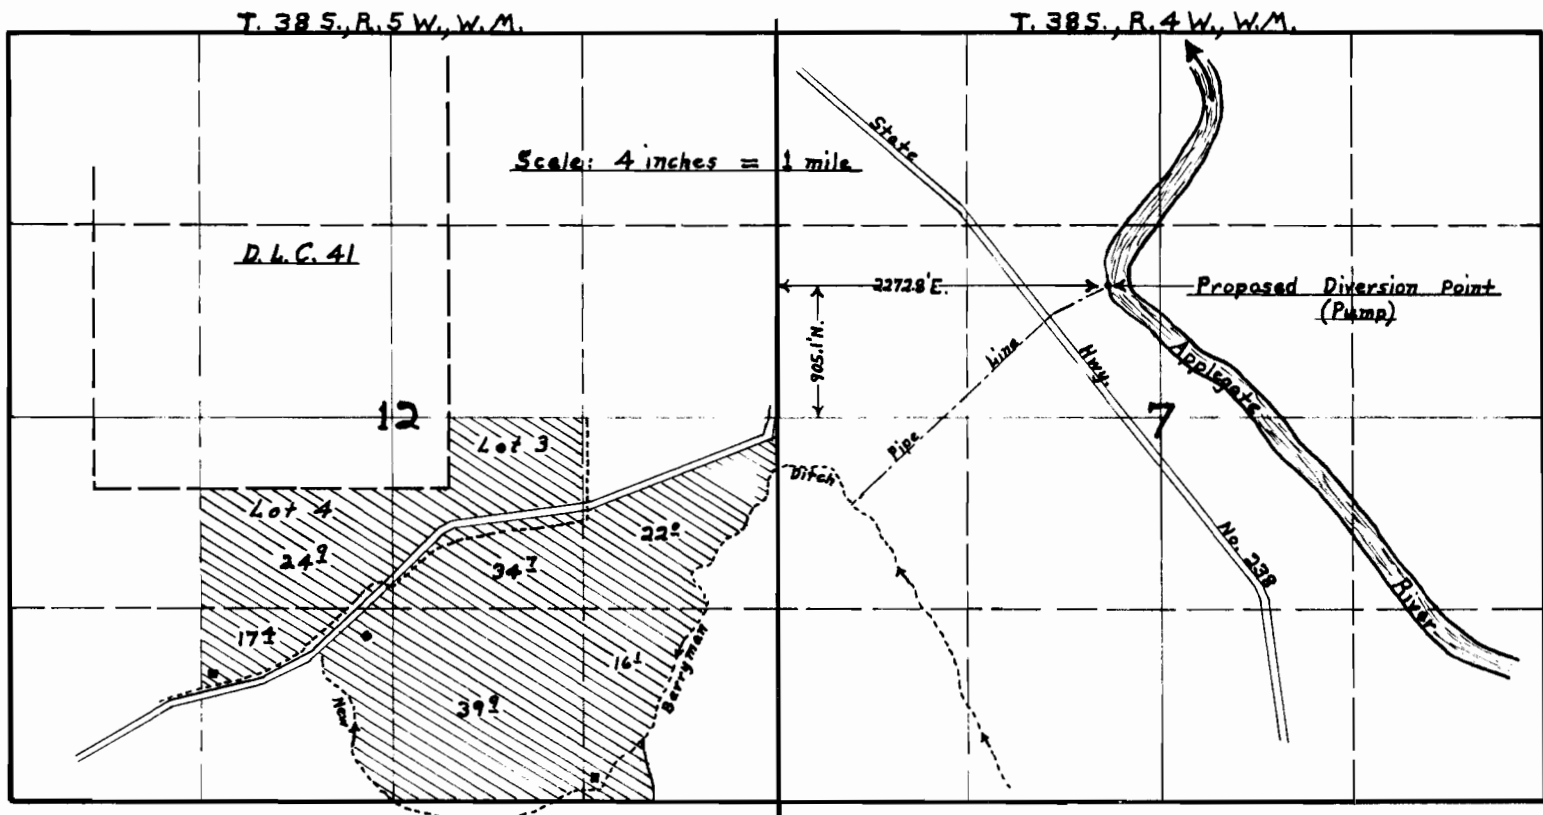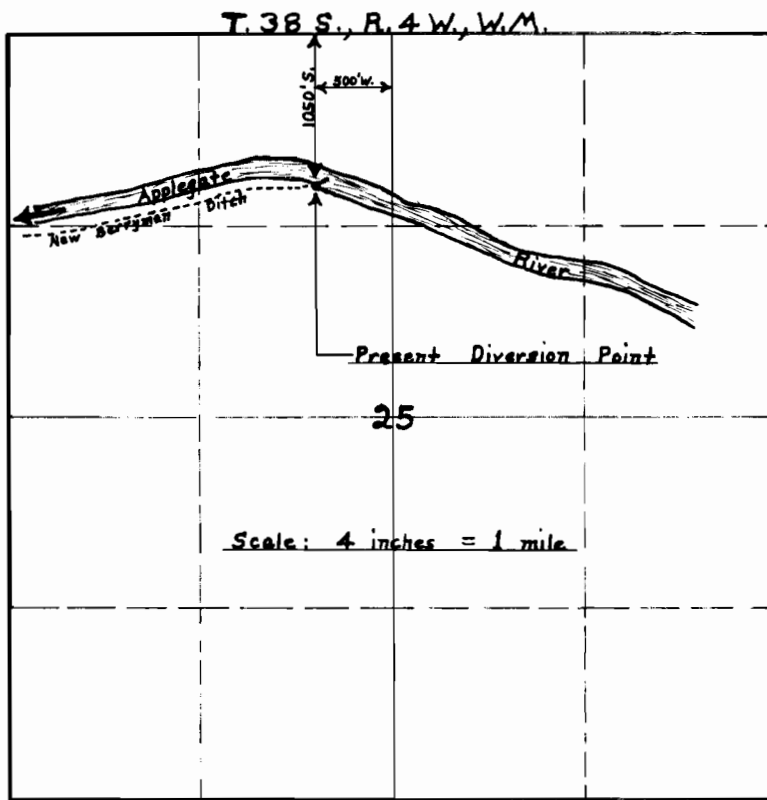

Map to accompany applications of Paul A. Sakraida and Leo J. Sakraida, for a change in point of diversion of water from the Applegate River.

This Office ----- April 7, 1957

David C. Hendrix, Watermaster Dist. #15