


Chypt. NO. 8740  
Plat. NO. 1744  
MAG. DECL. 21° E.

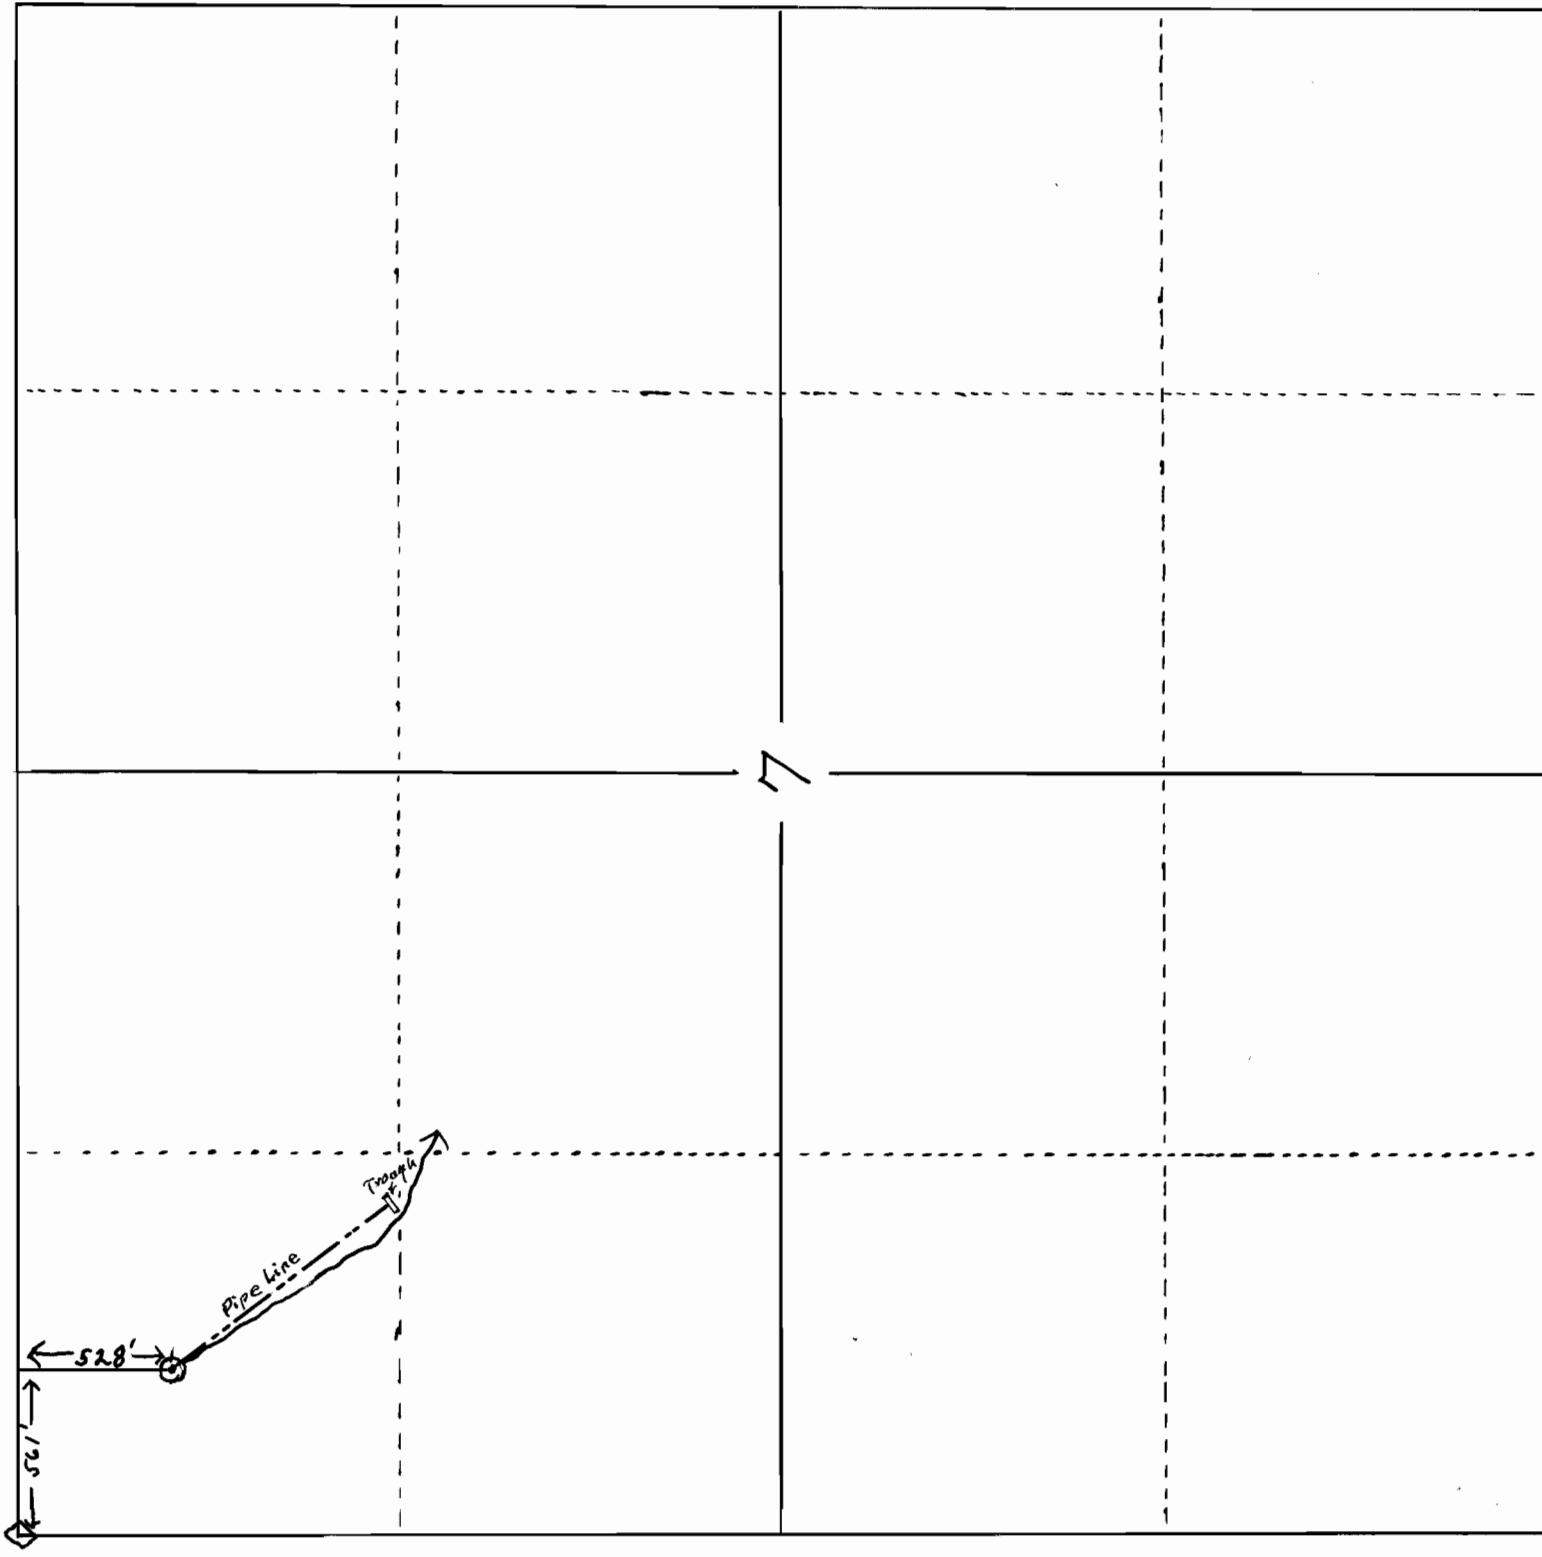

FIELD WORK BY - H.H.O. DATE. 4/16/40 PLATTED BY - H.H.O.	U. S. DEPT. AGRICULTURE FOREST SERVICE DESCHUTES NAT. FOREST	CORRAL SPRING SEC. 7 T. 27 S. R. 8 E. W.M. SCALE. 8 inches = 1 mile
--	--	---

1744