


SECTION

32

TOWNSHIP 35⁸, RANGE 1 W, W.M.

Jackson Co, Ore.

North

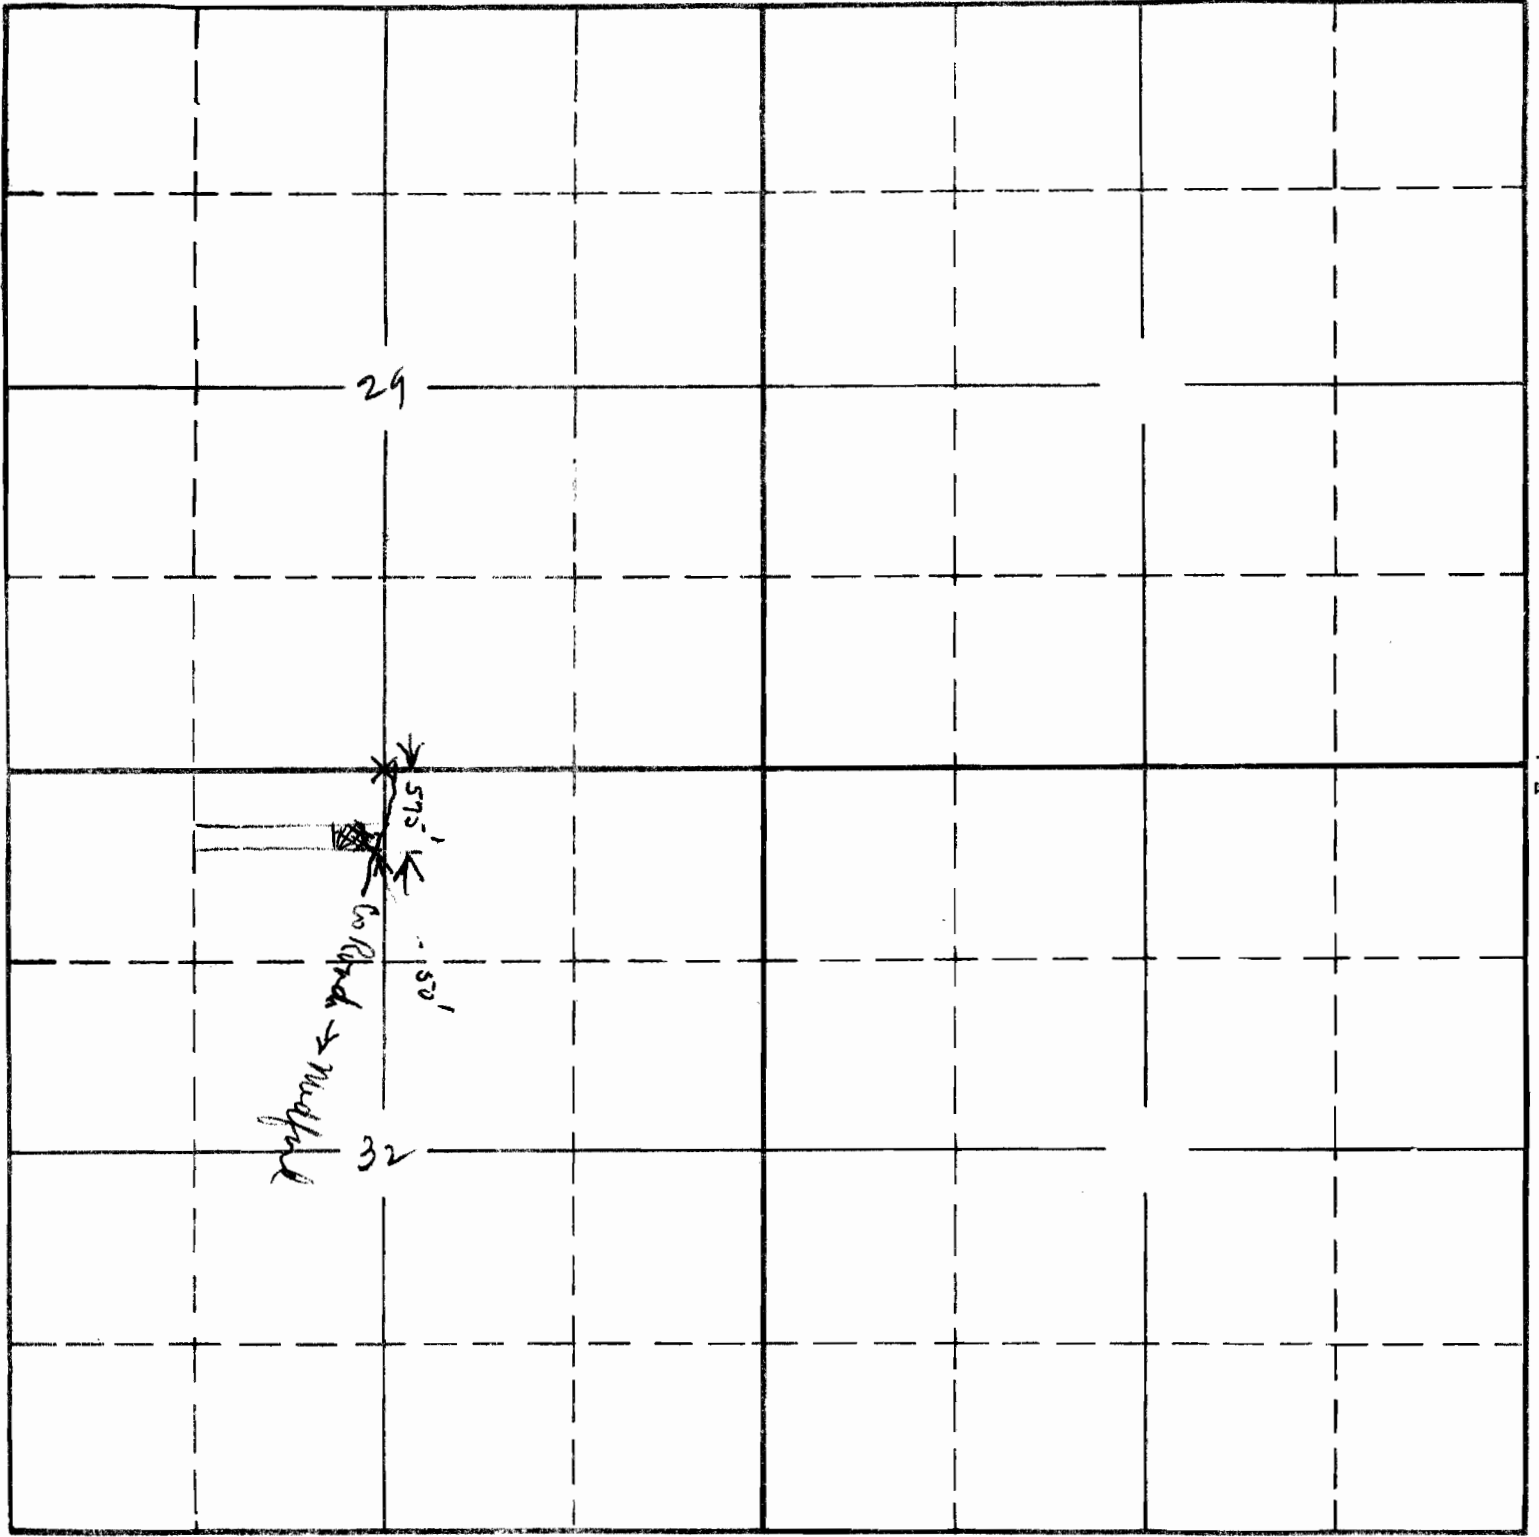

South

17428
 APPLICATION No. 18778
 PERMIT No. 17428