


SECTION

TOWNSHIP 36 S, RANGE 5 W, W. M.

North

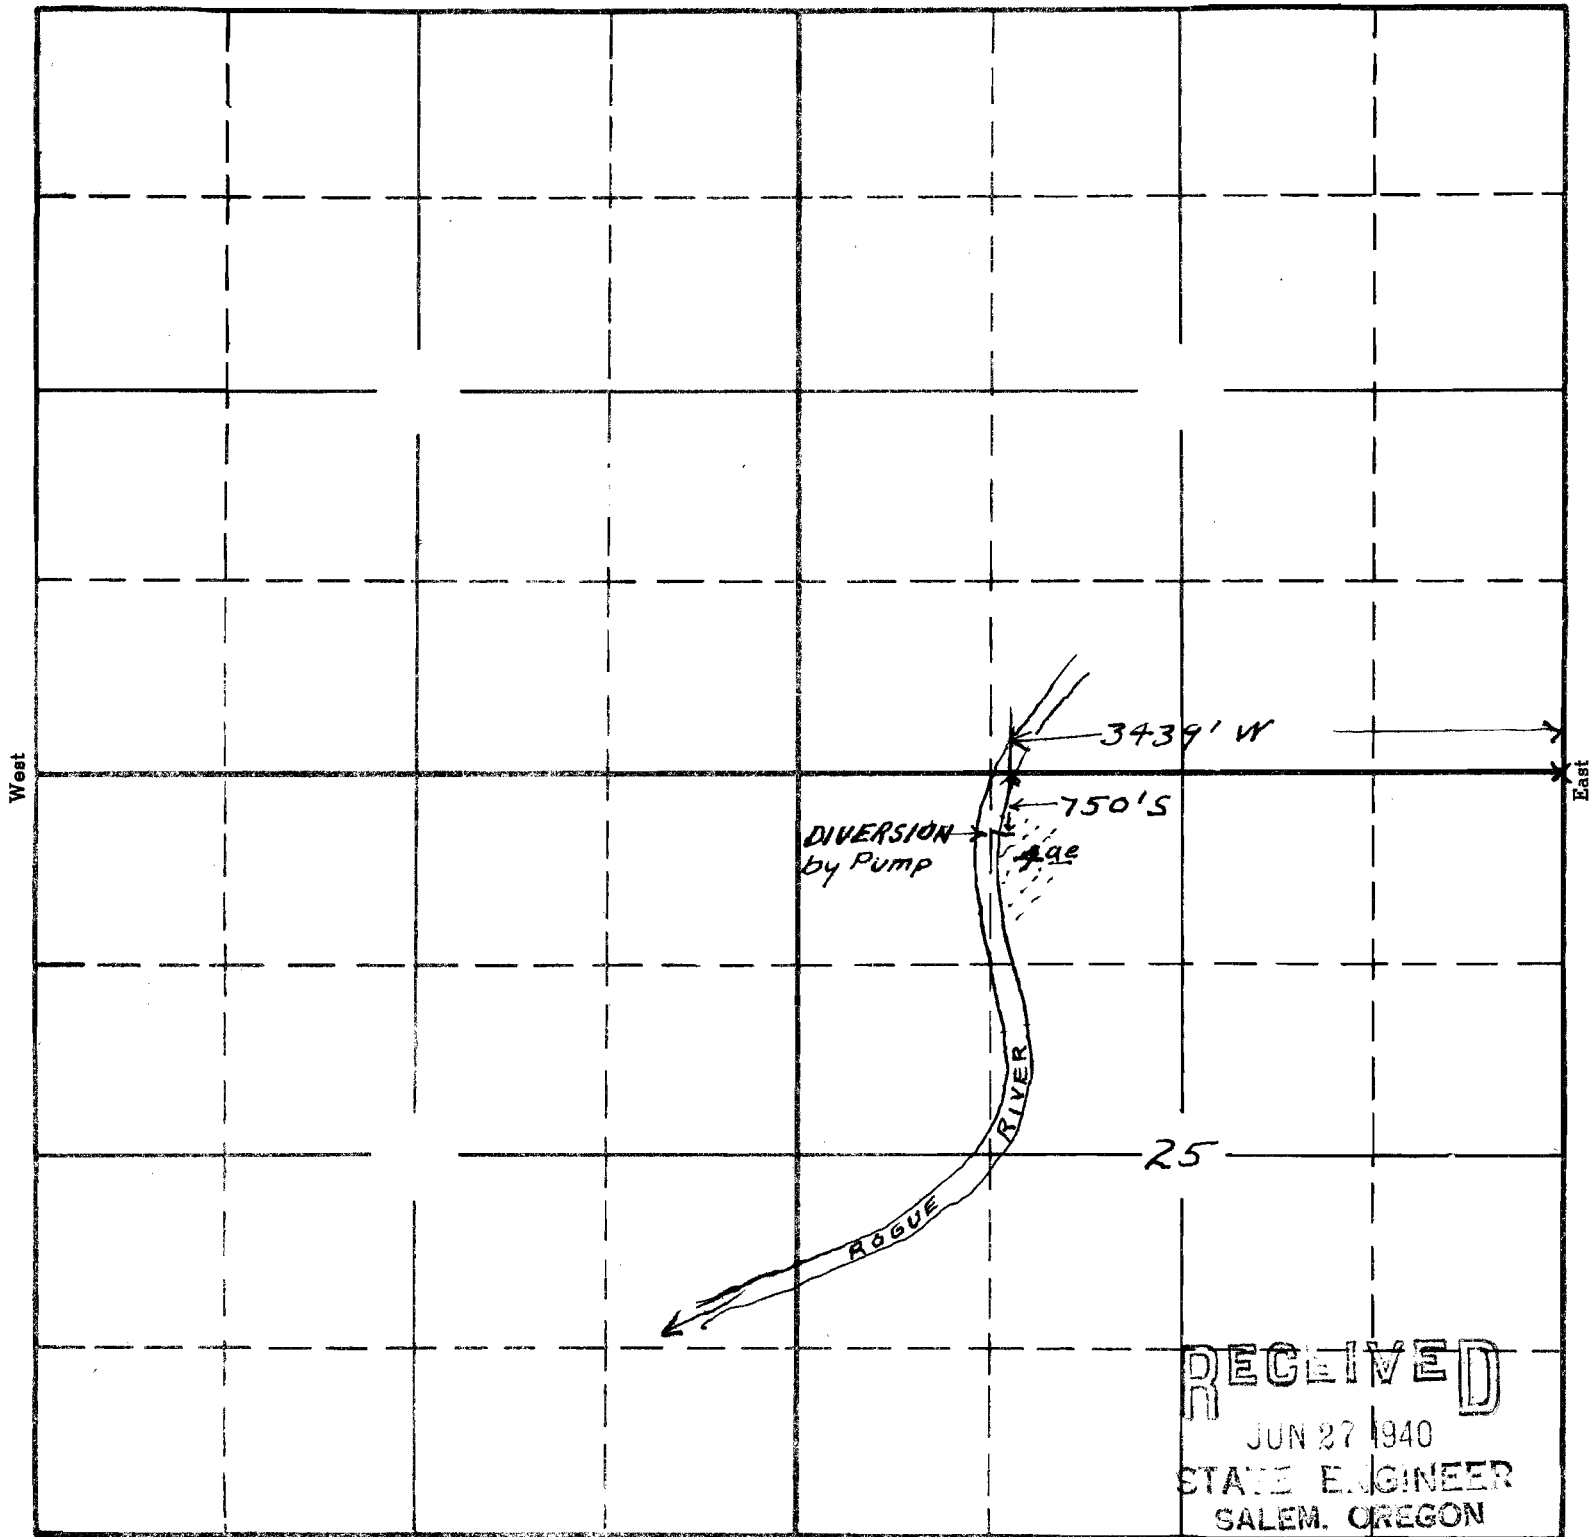

RECEIVED
 JUN 27 1940
 STATE ENGINEER
 SALEM, OREGON

To accompany application of ^{South} Edward F. and Eleanor S. Bolt, for use of waters of Rogue River for irrigation purposes

18814 MC
 15-60
 APPLICATION No. 18814
 PERMIT No. 14454

Meas. by E. F. B.

This office 6/25 Ed Smith