


32

TOWNSHIP 355, RANGE 1 W, W. M.

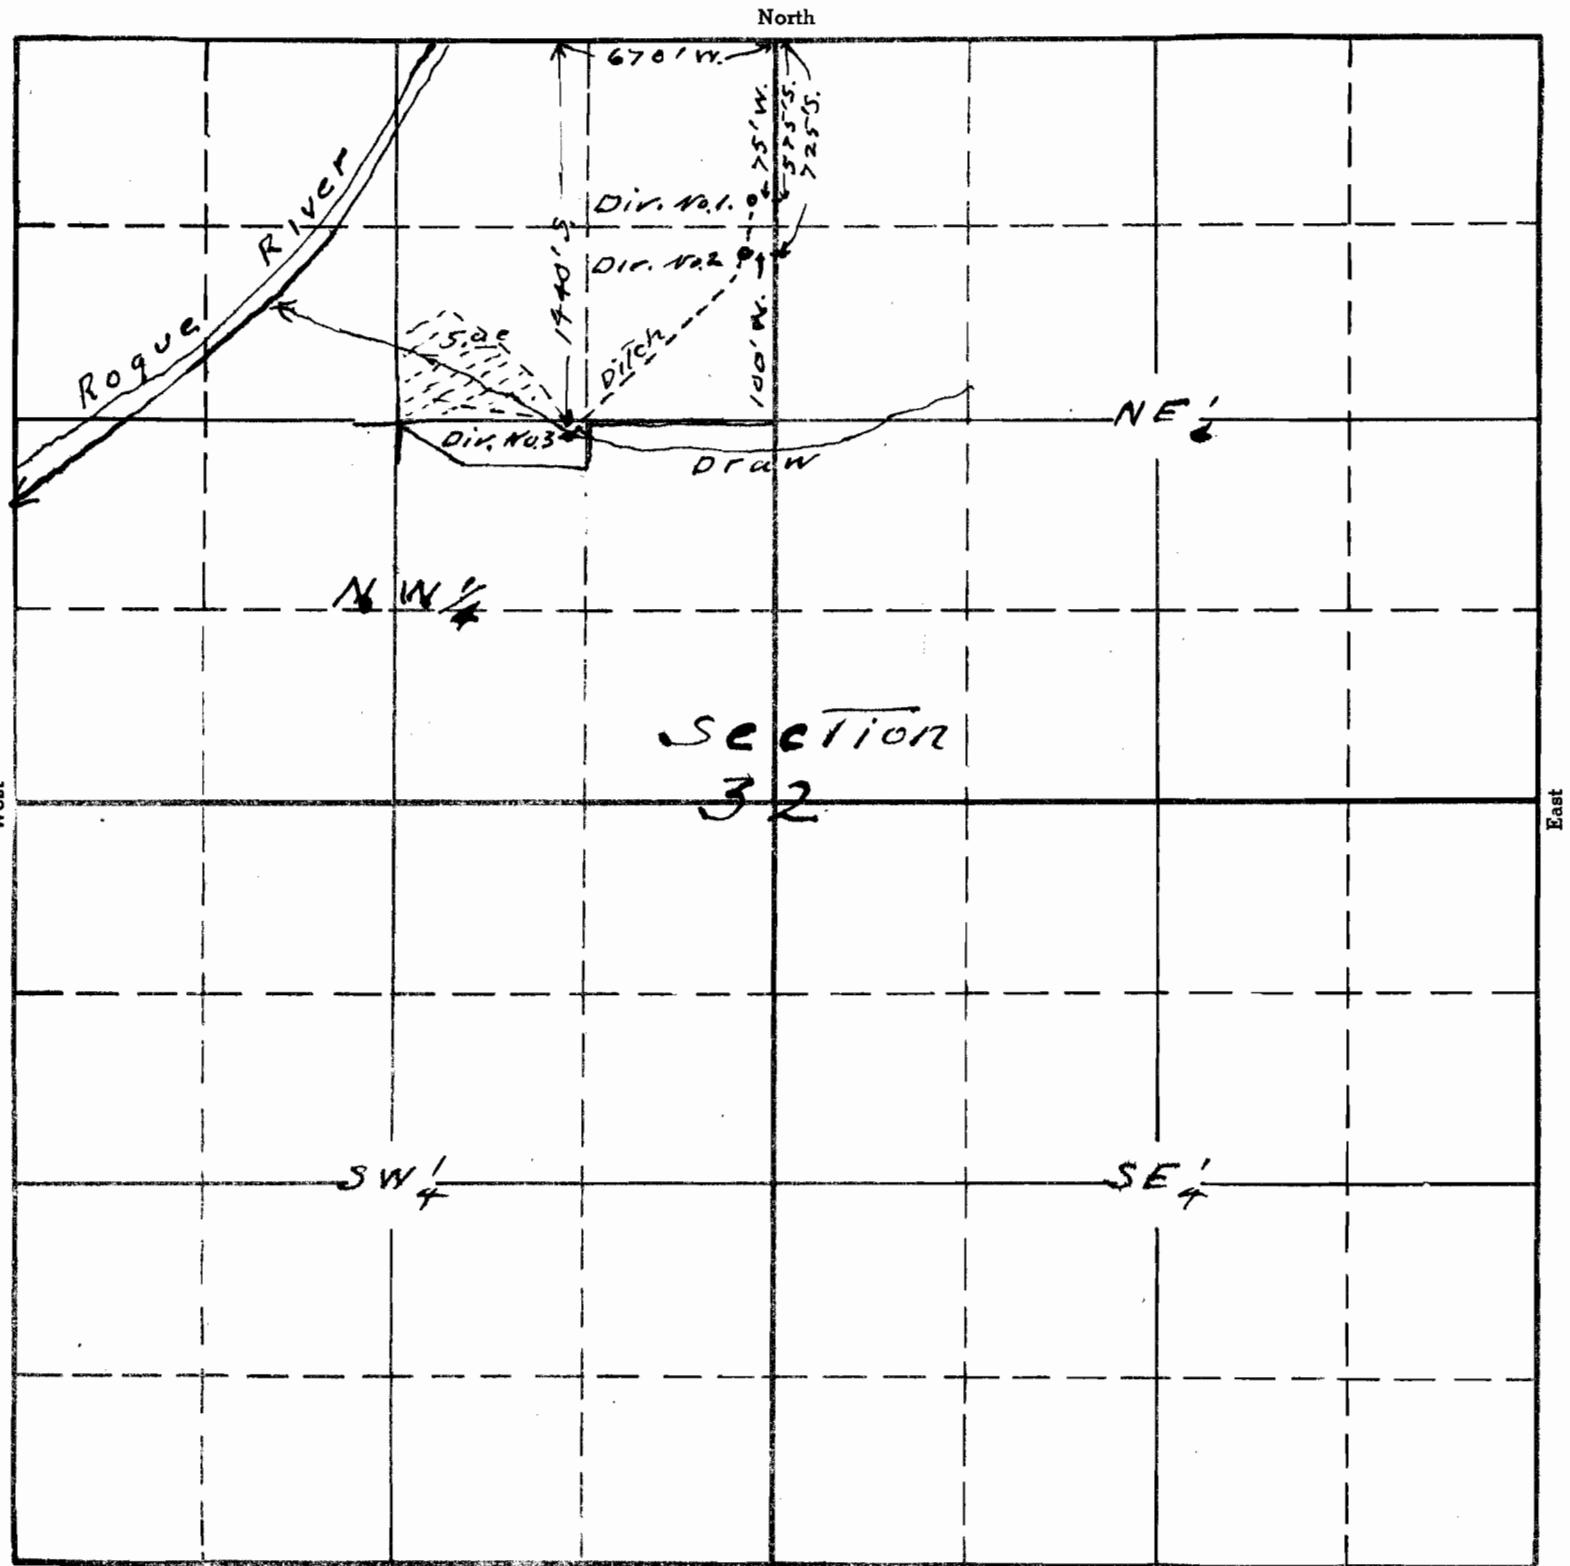

Sketch to accompany application of
Scot Davis for use of waste and
seepage water for irrigation purposes

19028
15-78
APPLICATION No. 19028
PERMIT No. 14635

This office 10/1/40