


SECTION

TOWNSHIP 37 S, RANGE 7 W., W. M.

Oct. 1940

North

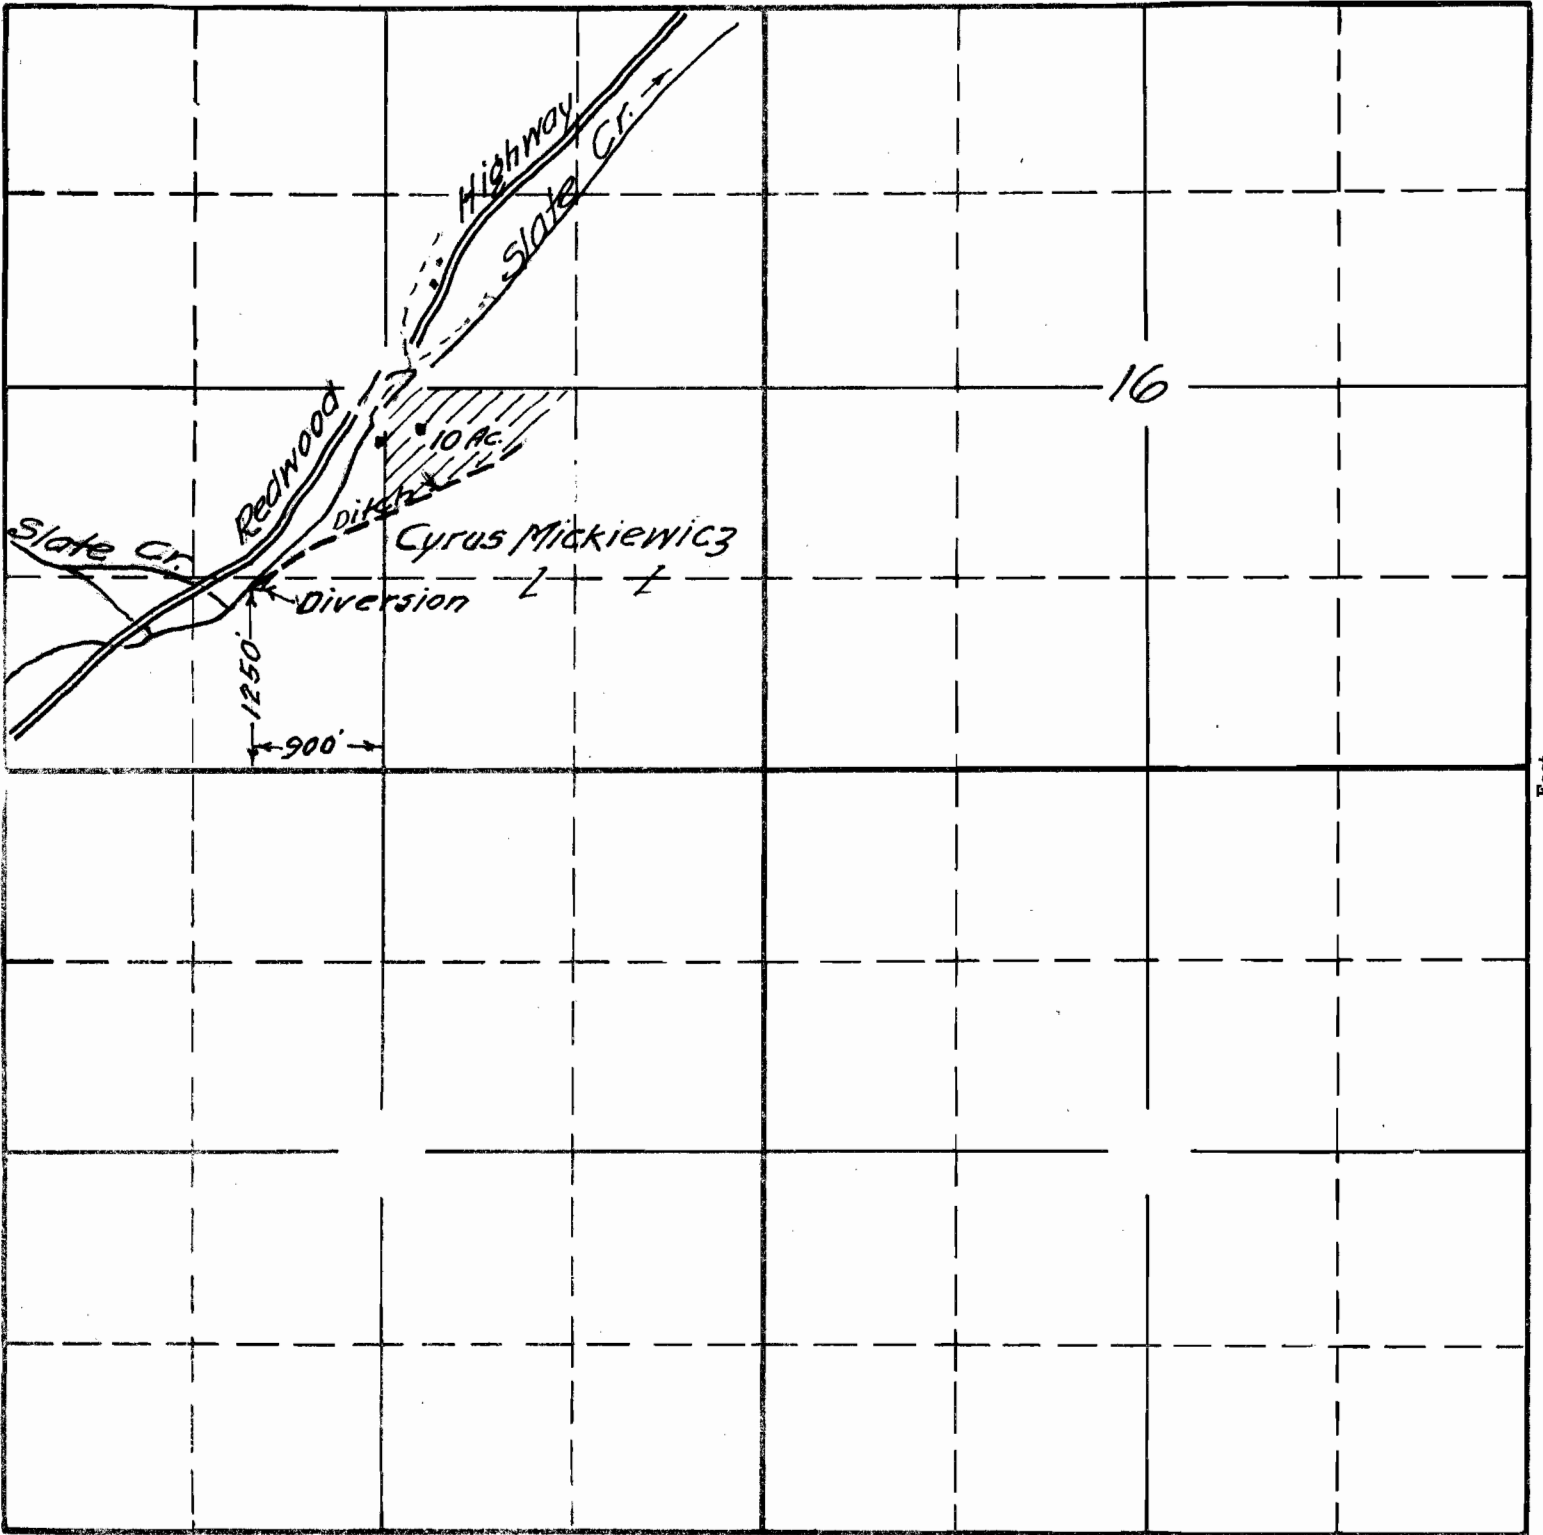

South

1940-12
15-64

APPLICATION No. 19040

PERMIT No. 14646

RECEIVED

OCT 14 1940

STATE ENGINEER
SALEM, OREGON